


APPLE ST.

HICKORY ST.

ORANGE ST.

MARKET ST.

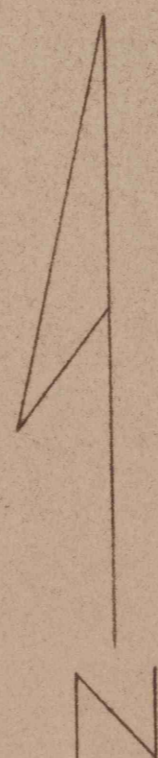


6 TH ST.

7 TH ST.

BUICK ST.

8 TH ST.

MOUNT CARMEL BORO
MOUNT CARMEL TWP.

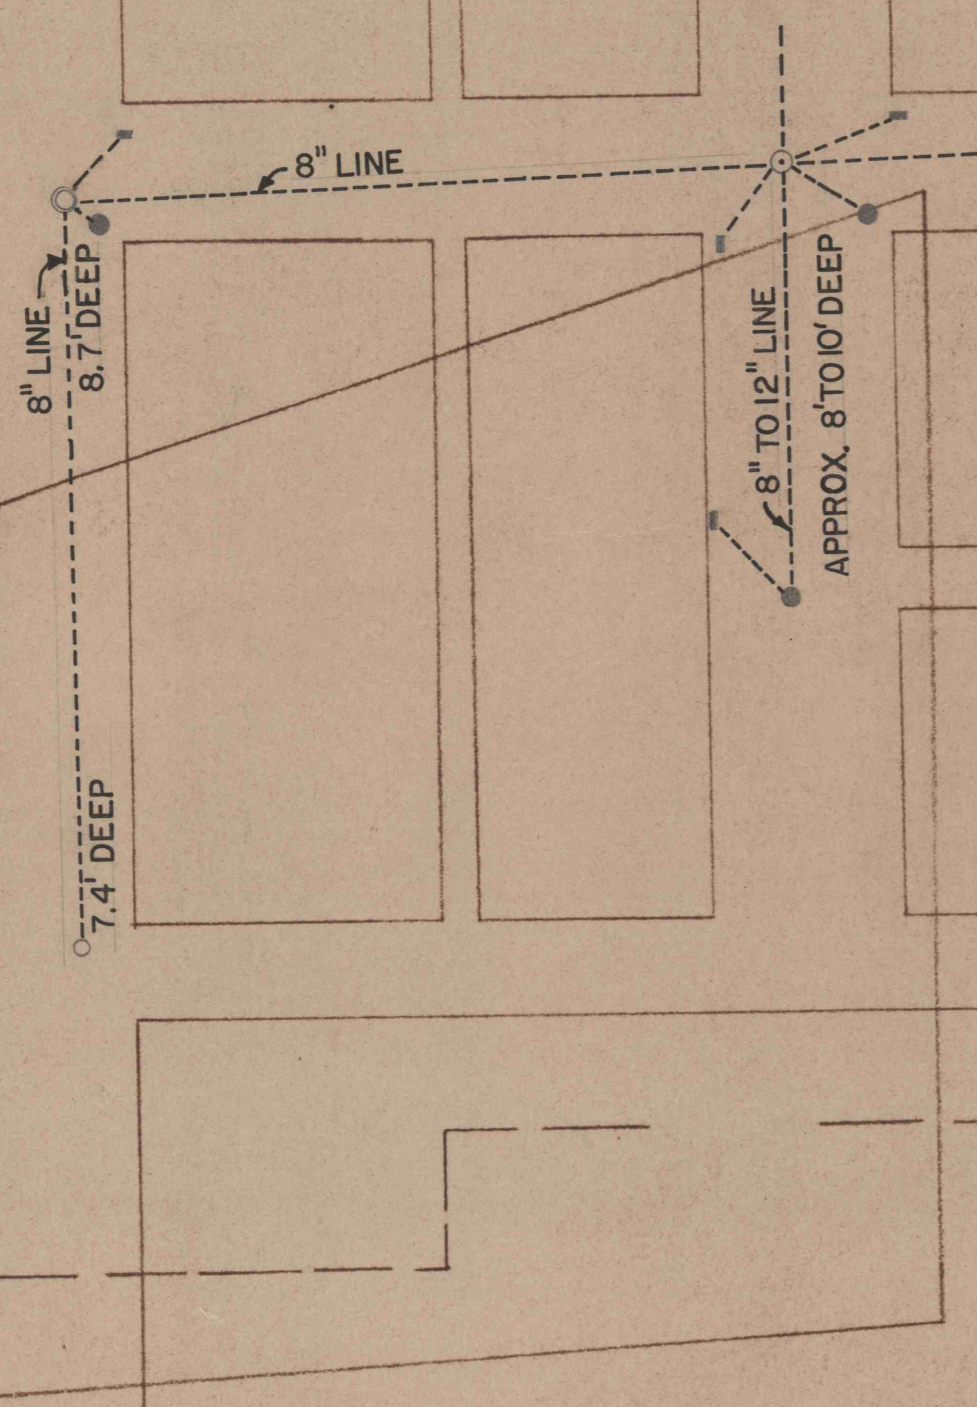

UTILITY LAYOUT

MT. CARMEL SEWER AUTH'Y
AVENUE AND OAK ST,
MT. CARMEL, PA. 17851
MR. JACK SCANLON
717-339-5166

FOR
FLUSHING PROJECT

ASP-18