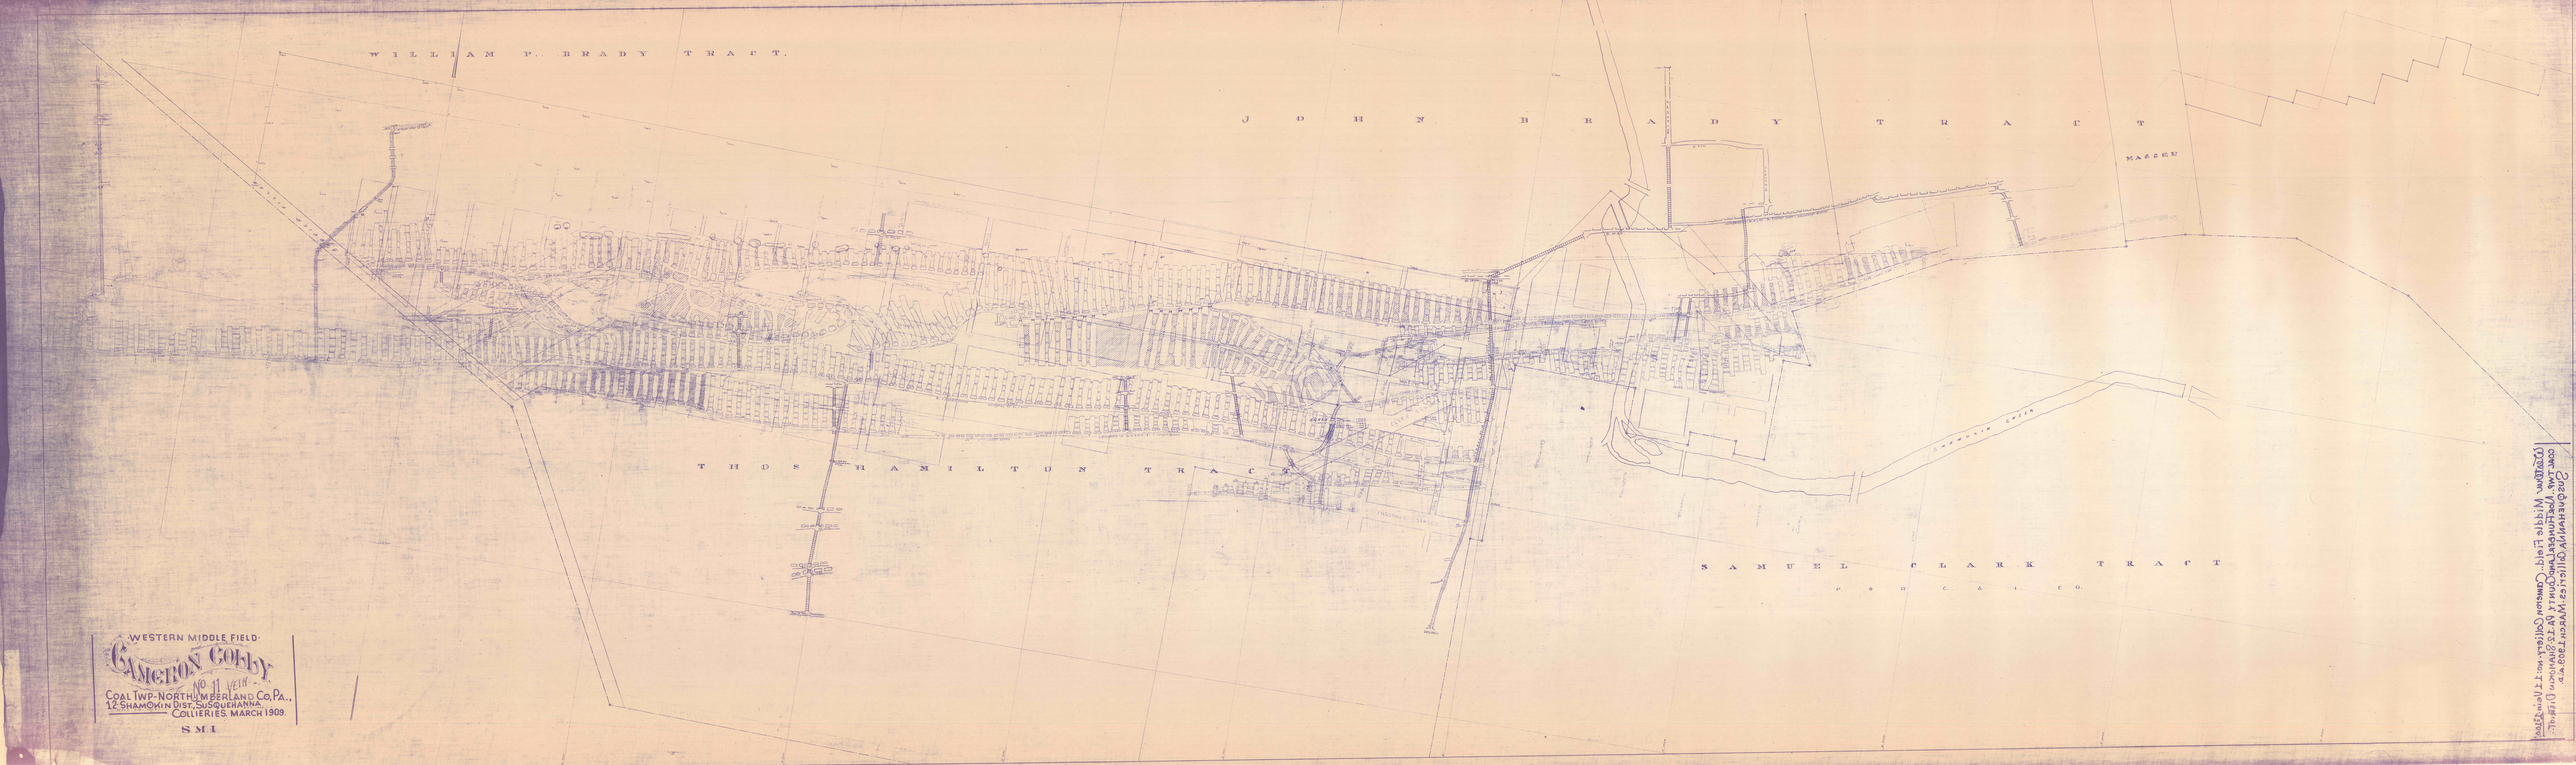
WILLIAM P. BRADY TRACT.
JOHN BRADY TRACT
MASSEE
THOS HAMILTON TRACT
SAMUEL CLARK TRACT
P. & H. C. & I. CO.
WESTERN MIDDLE FIELD
CAMERON COLLIERY
No. 11 VEIN
COAL TWP. NORTHUMBERLAND CO. PA.,
12 SHAMOKIN DIST. SUSQUEHANNA
COLLIERIES. MARCH 1909.
SMI
