


W E S T E R N
M I D D L E
F I E L D
C O A L
T O W N S H I P

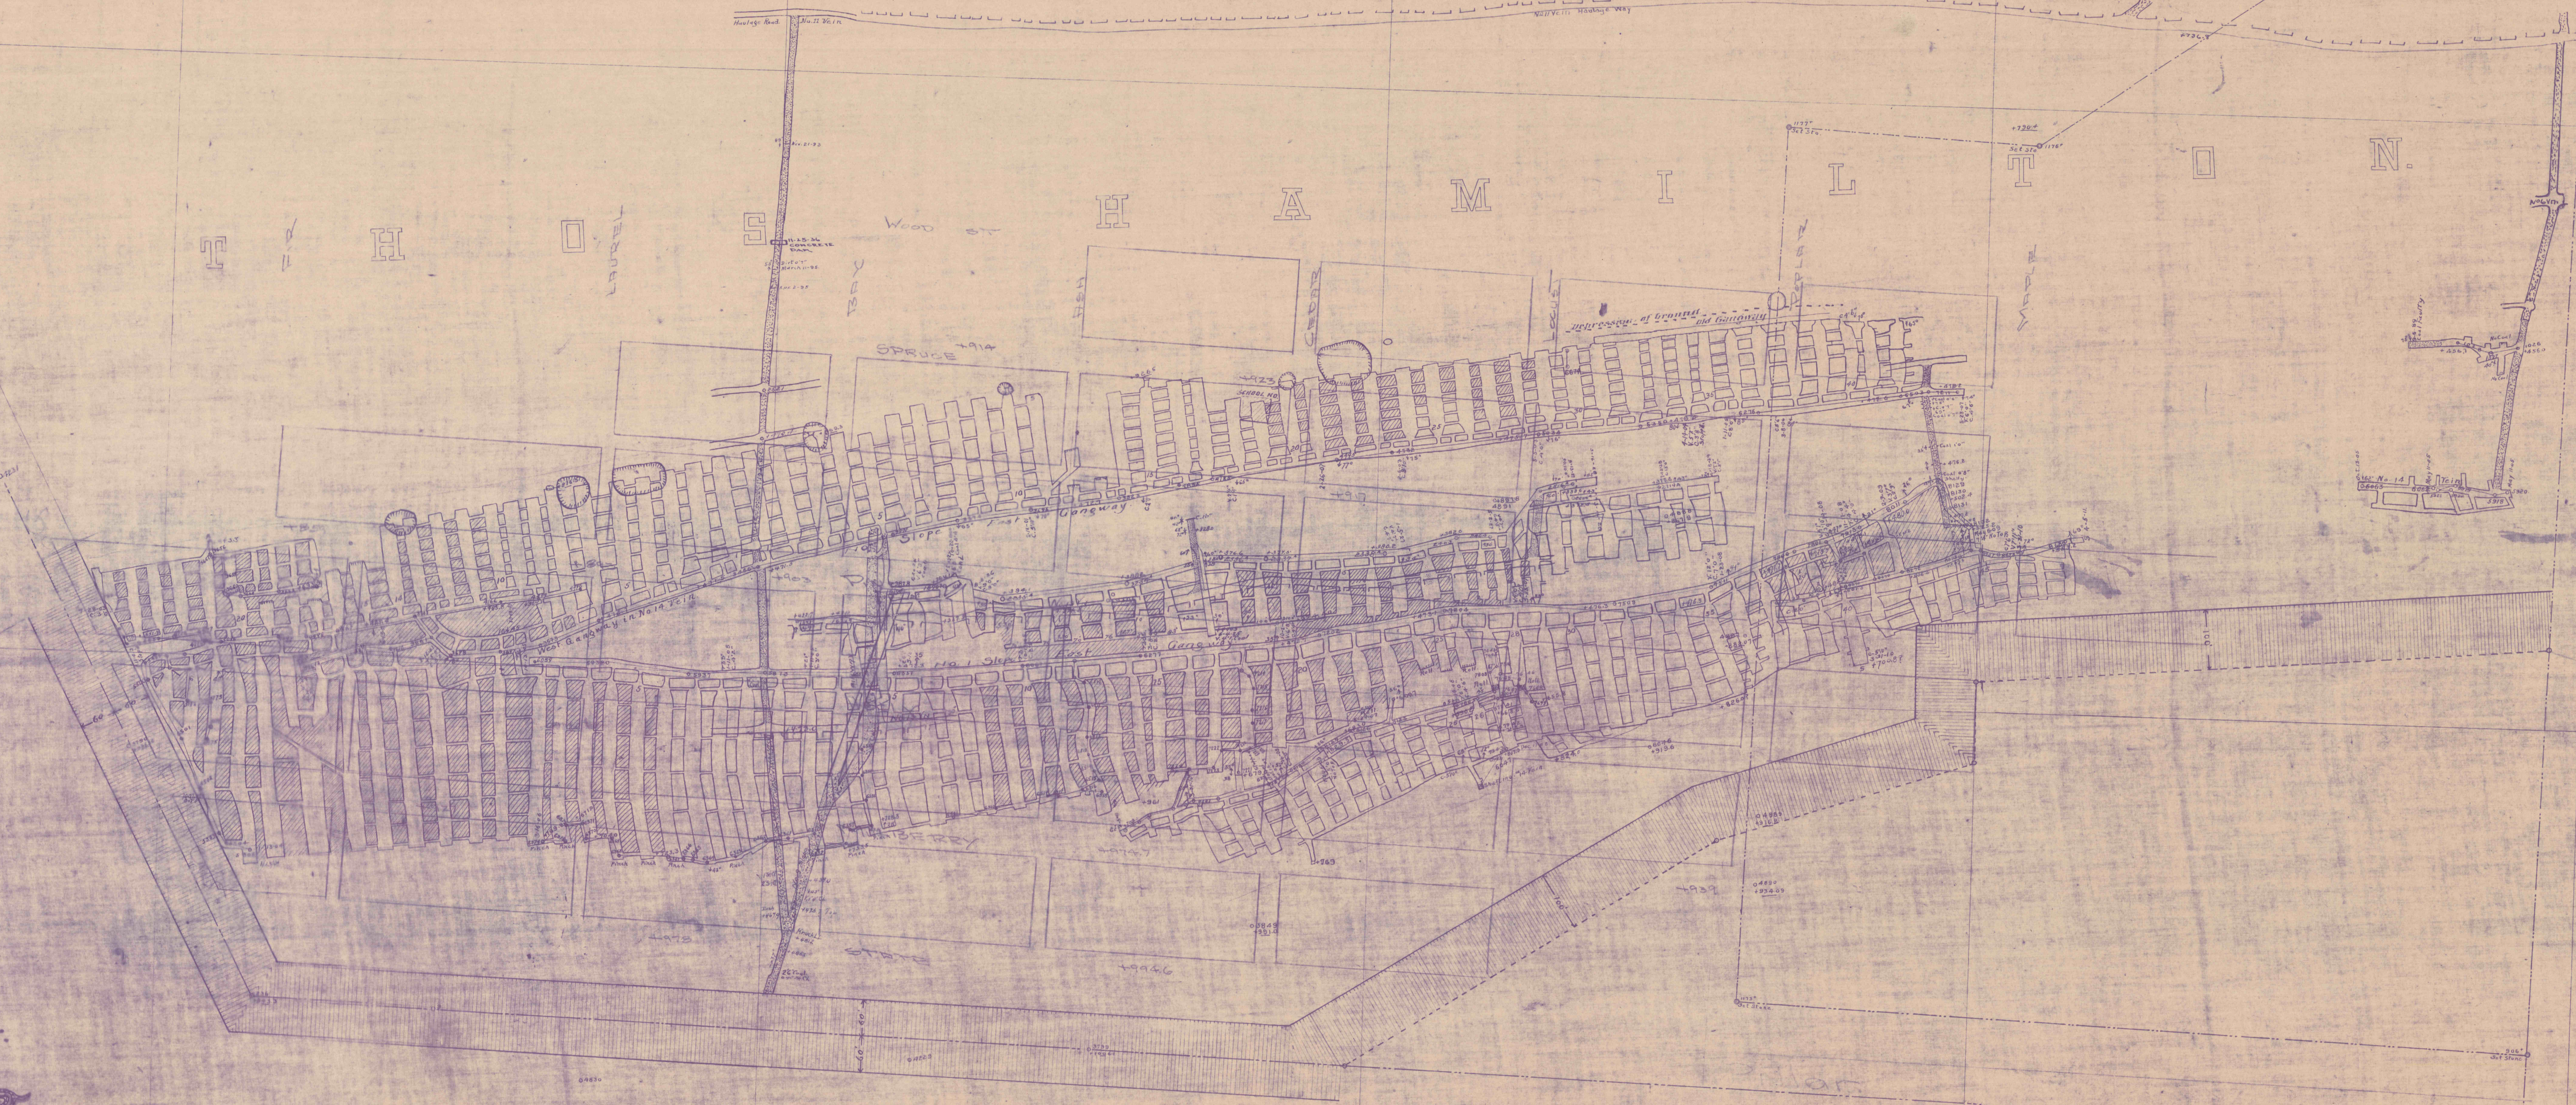

Western Middle Field.
COAL TOWNSHIP...

CAMERON COLLY

NORTH UMBERLAND CO., PA.,

NO. 14 VEIN WORKINGS

NOV 2 - 1912. 12. SHAMOKIN DISTRICT.

S.M.I. SUSQUEHANNA COLL'RS.

12. SHAMOKIN DISTRICT SUSQUEHANNA COLL'RS.
NOV 2 - 1912. 100. NORTH UMBERLAND CO., PA.
Cameron Colliery No 14 Vein.
Scale 1 inch = 100 feet.