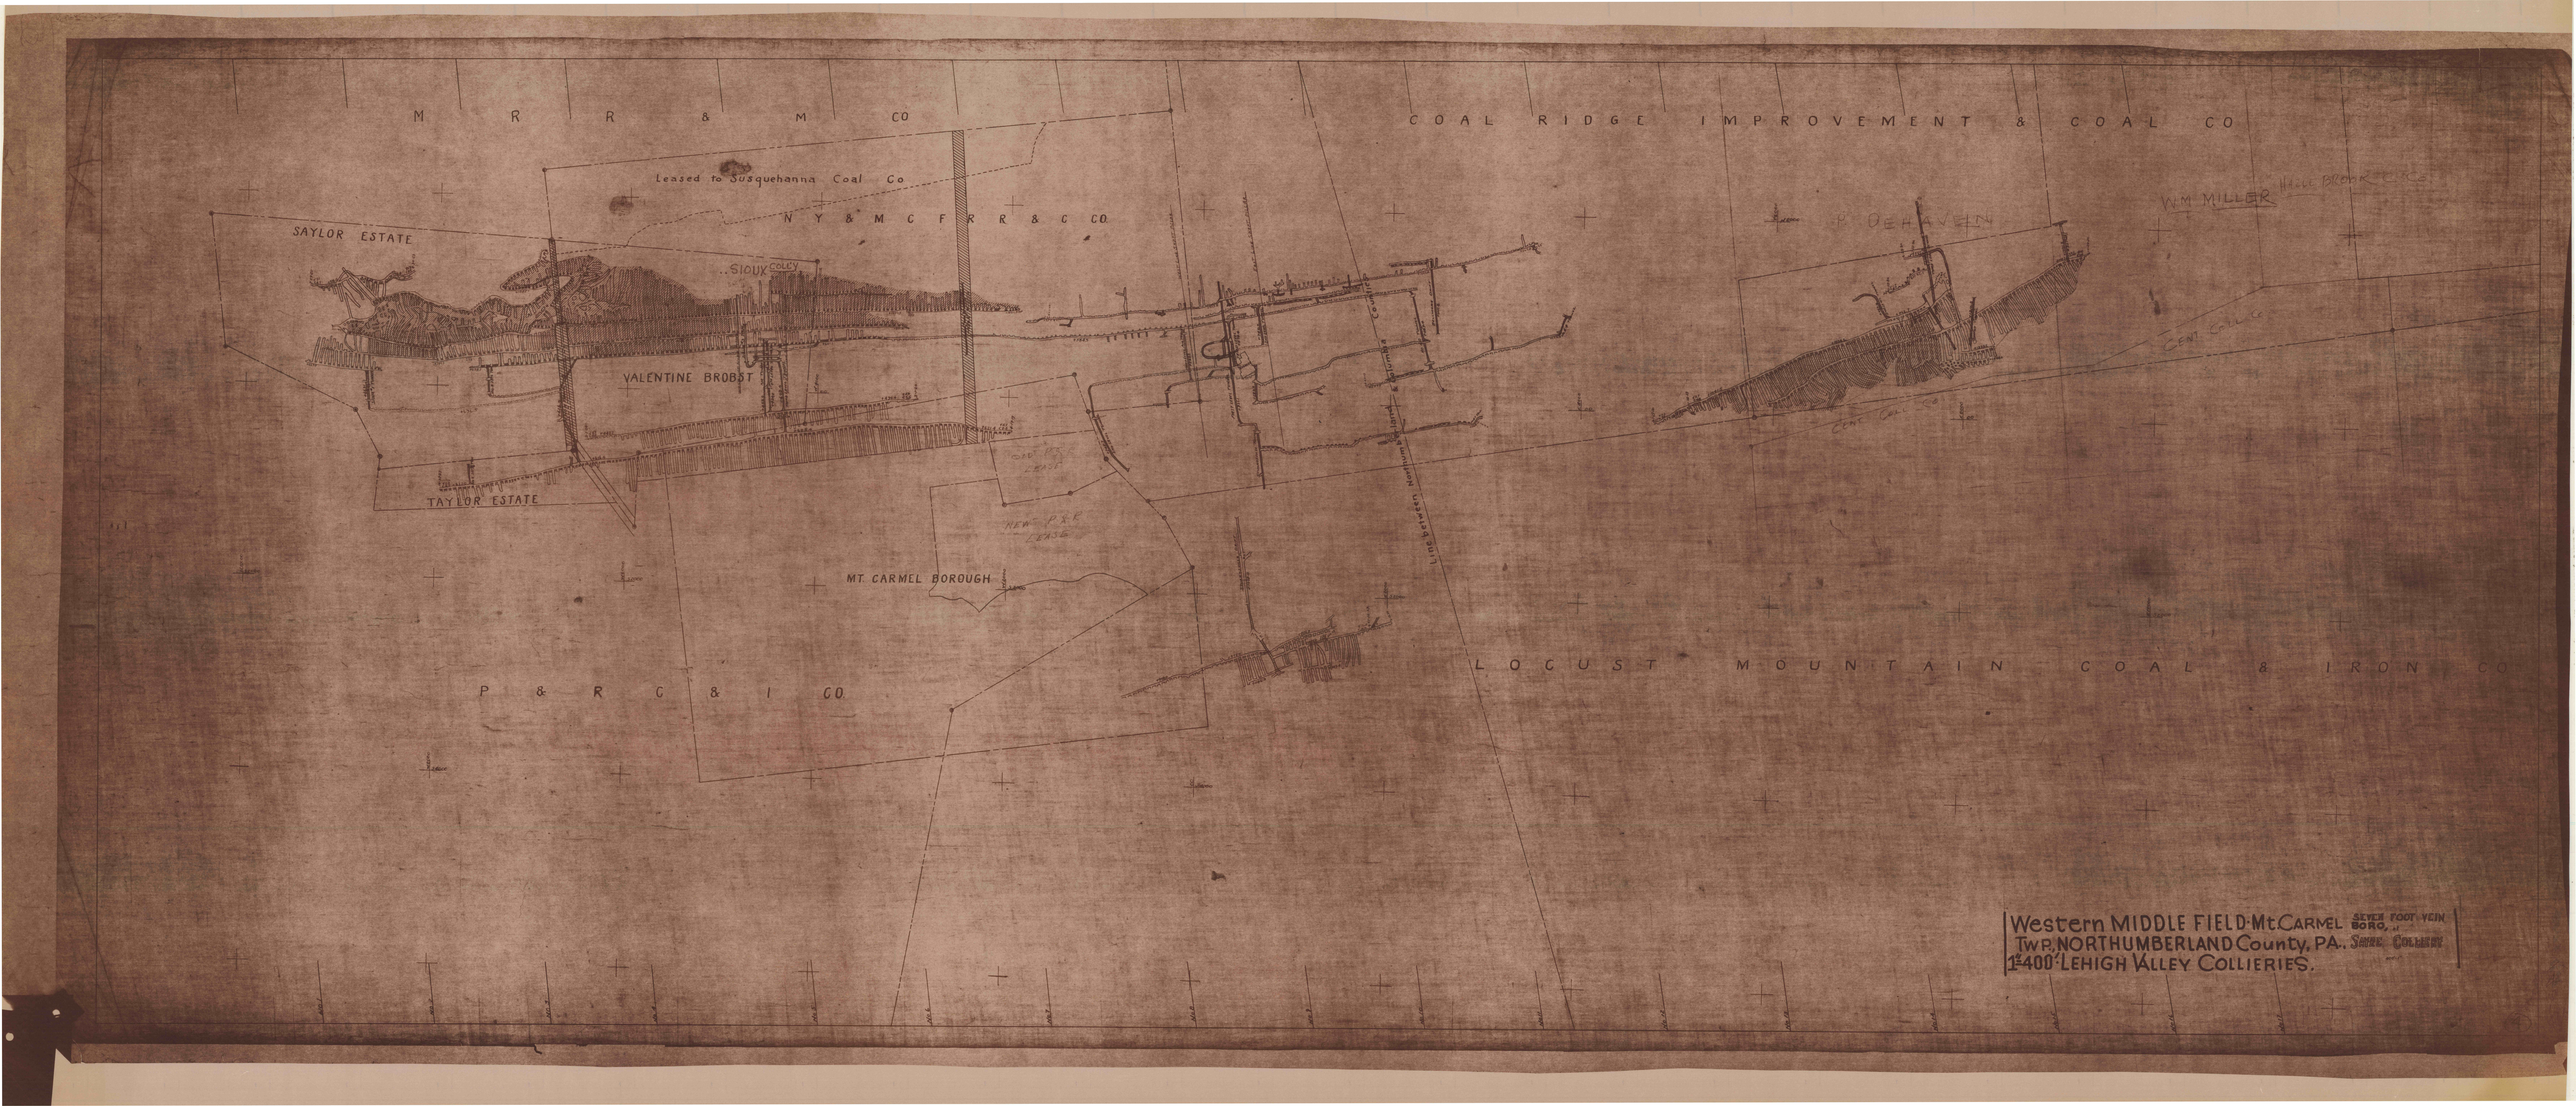
M R R & M CO
COAL RIDGE IMPROVEMENT & COAL CO
Leased to Susquehanna Coal Co
N Y & M C F R R & C CO
SAYLOR ESTATE
SIOUX COLLY
VALENTINE BROBST
TAYLOR ESTATE
MT. CARMEL BOROUGH
P & R C & I CO
LOCUST MOUNTAIN COAL & IRON CO
Line between Northumberland & Columbia Counties
P. DEHAVEN
WM MILLER
HALLE BROOK C. CO
CENT COLL CO
Western MIDDLE FIELD·Mt.CARMEL SEVEN FOOT VEIN
BORO,
TWP., NORTHUMBERLAND County, PA. SHIRE COLLIERY
1"=400' LEHIGH VALLEY COLLIERIES.