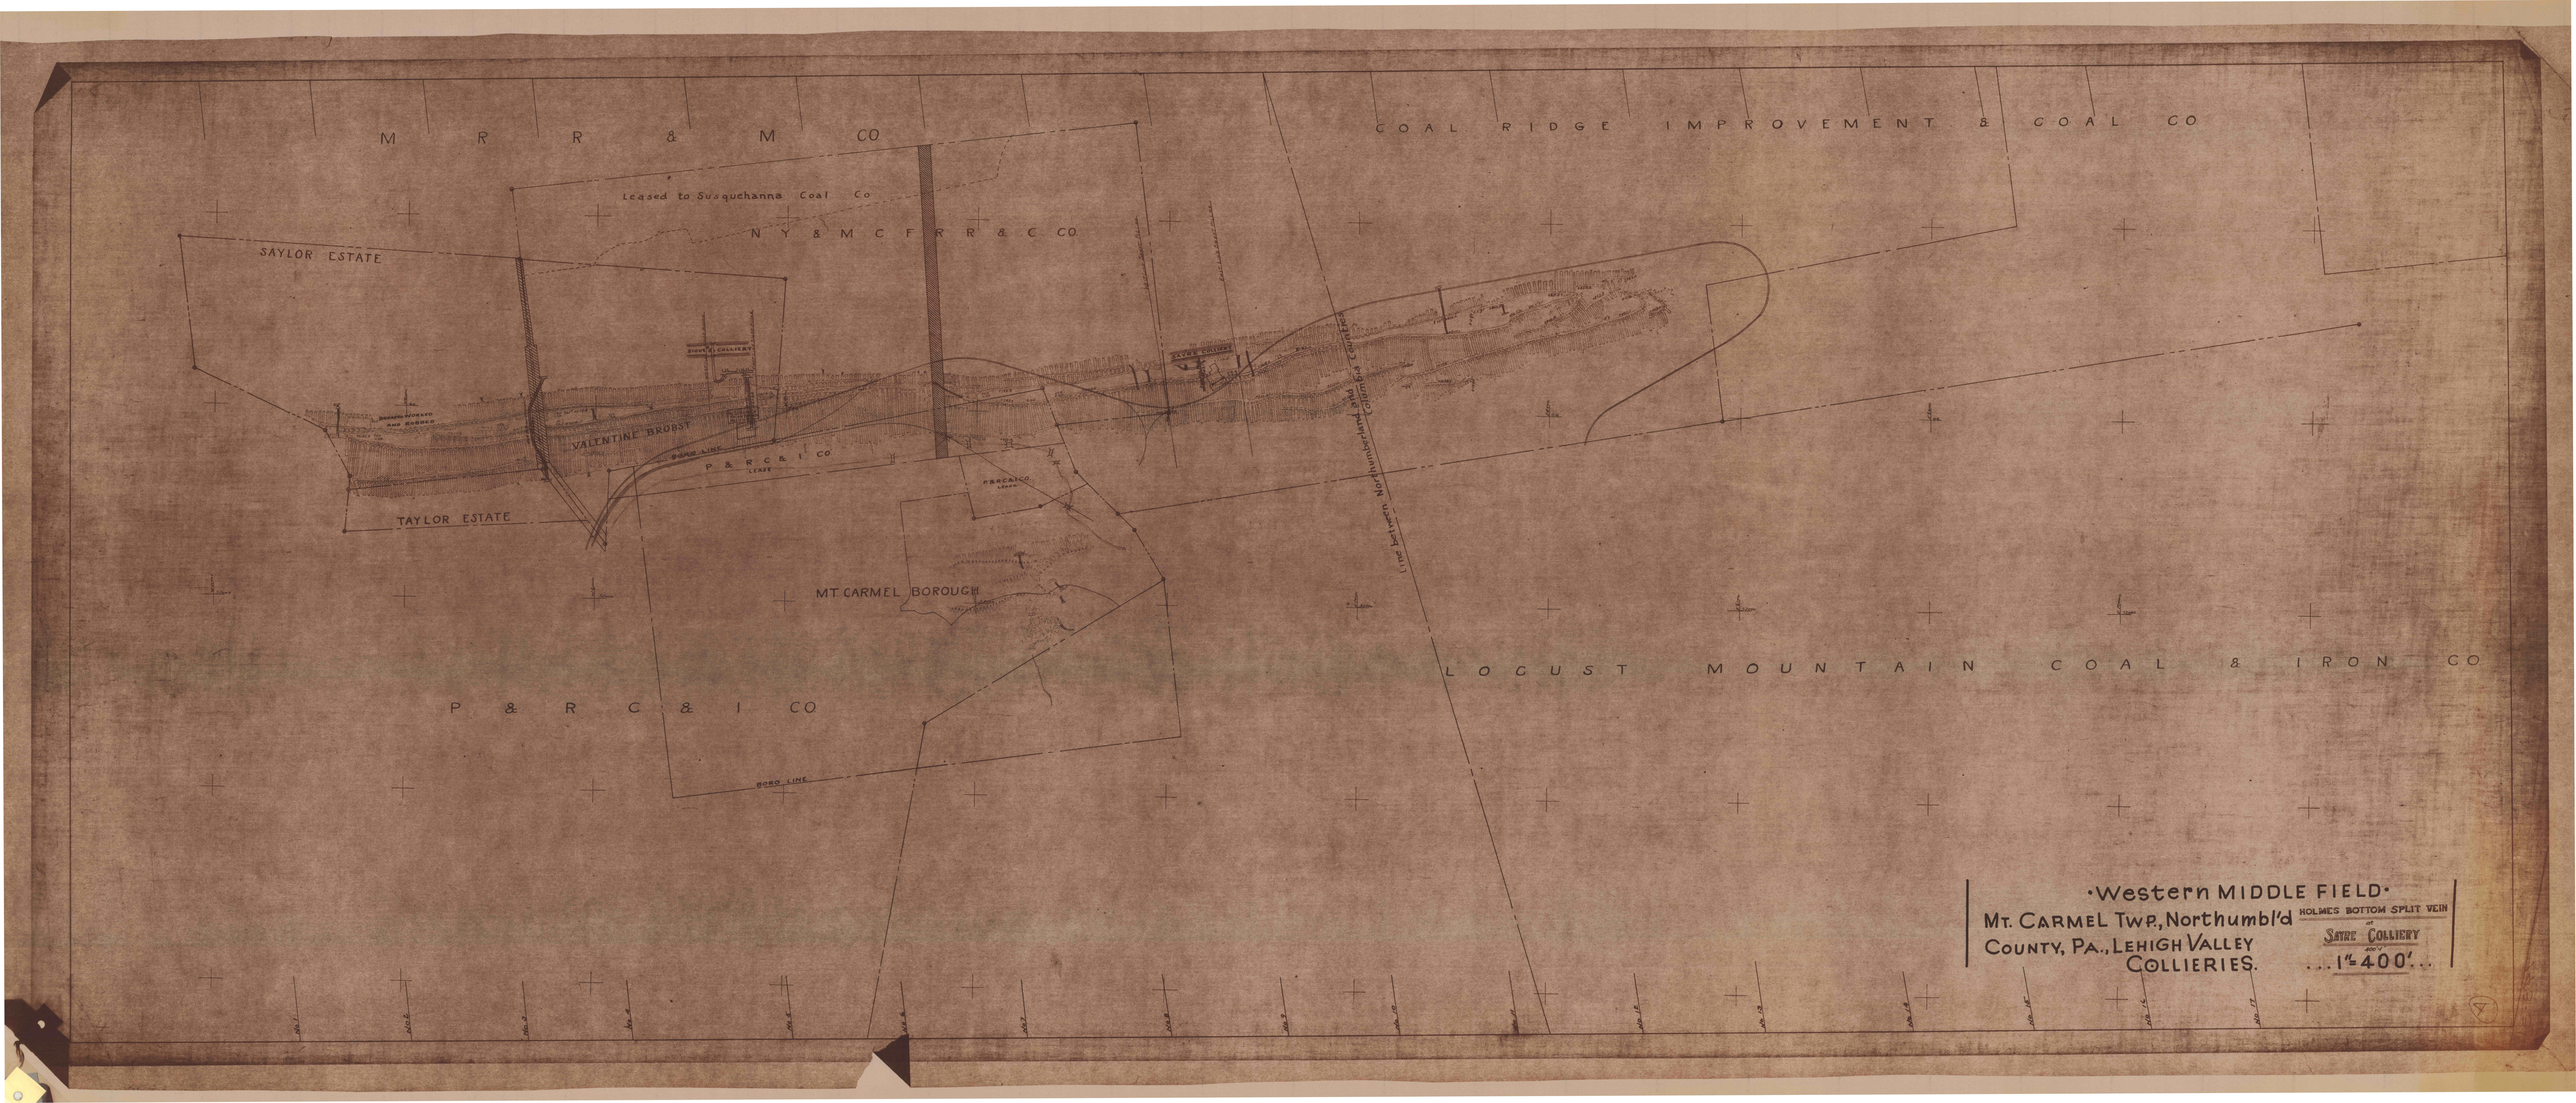
M R R & M CO
COAL RIDGE IMPROVEMENT & COAL CO
Leased to Susquehanna Coal Co
N Y & M C F R R & C CO
SAYLOR ESTATE
VALENTINE BROBST
P & R C & I CO
TAYLOR ESTATE
MT. CARMEL BOROUGH
Line between Northumberland and Columbia Counties
LOCUST MOUNTAIN COAL & IRON CO
P & R C & I CO
BORO LINE
·Western MIDDLE FIELD·
MT. CARMEL TWP., Northumbl'd
COUNTY, PA., LEHIGH VALLEY
COLLIERIES.
HOLMES BOTTOM SPLIT VEIN
at
SAYRE COLLIERY
400'
1"=400'