


383

383

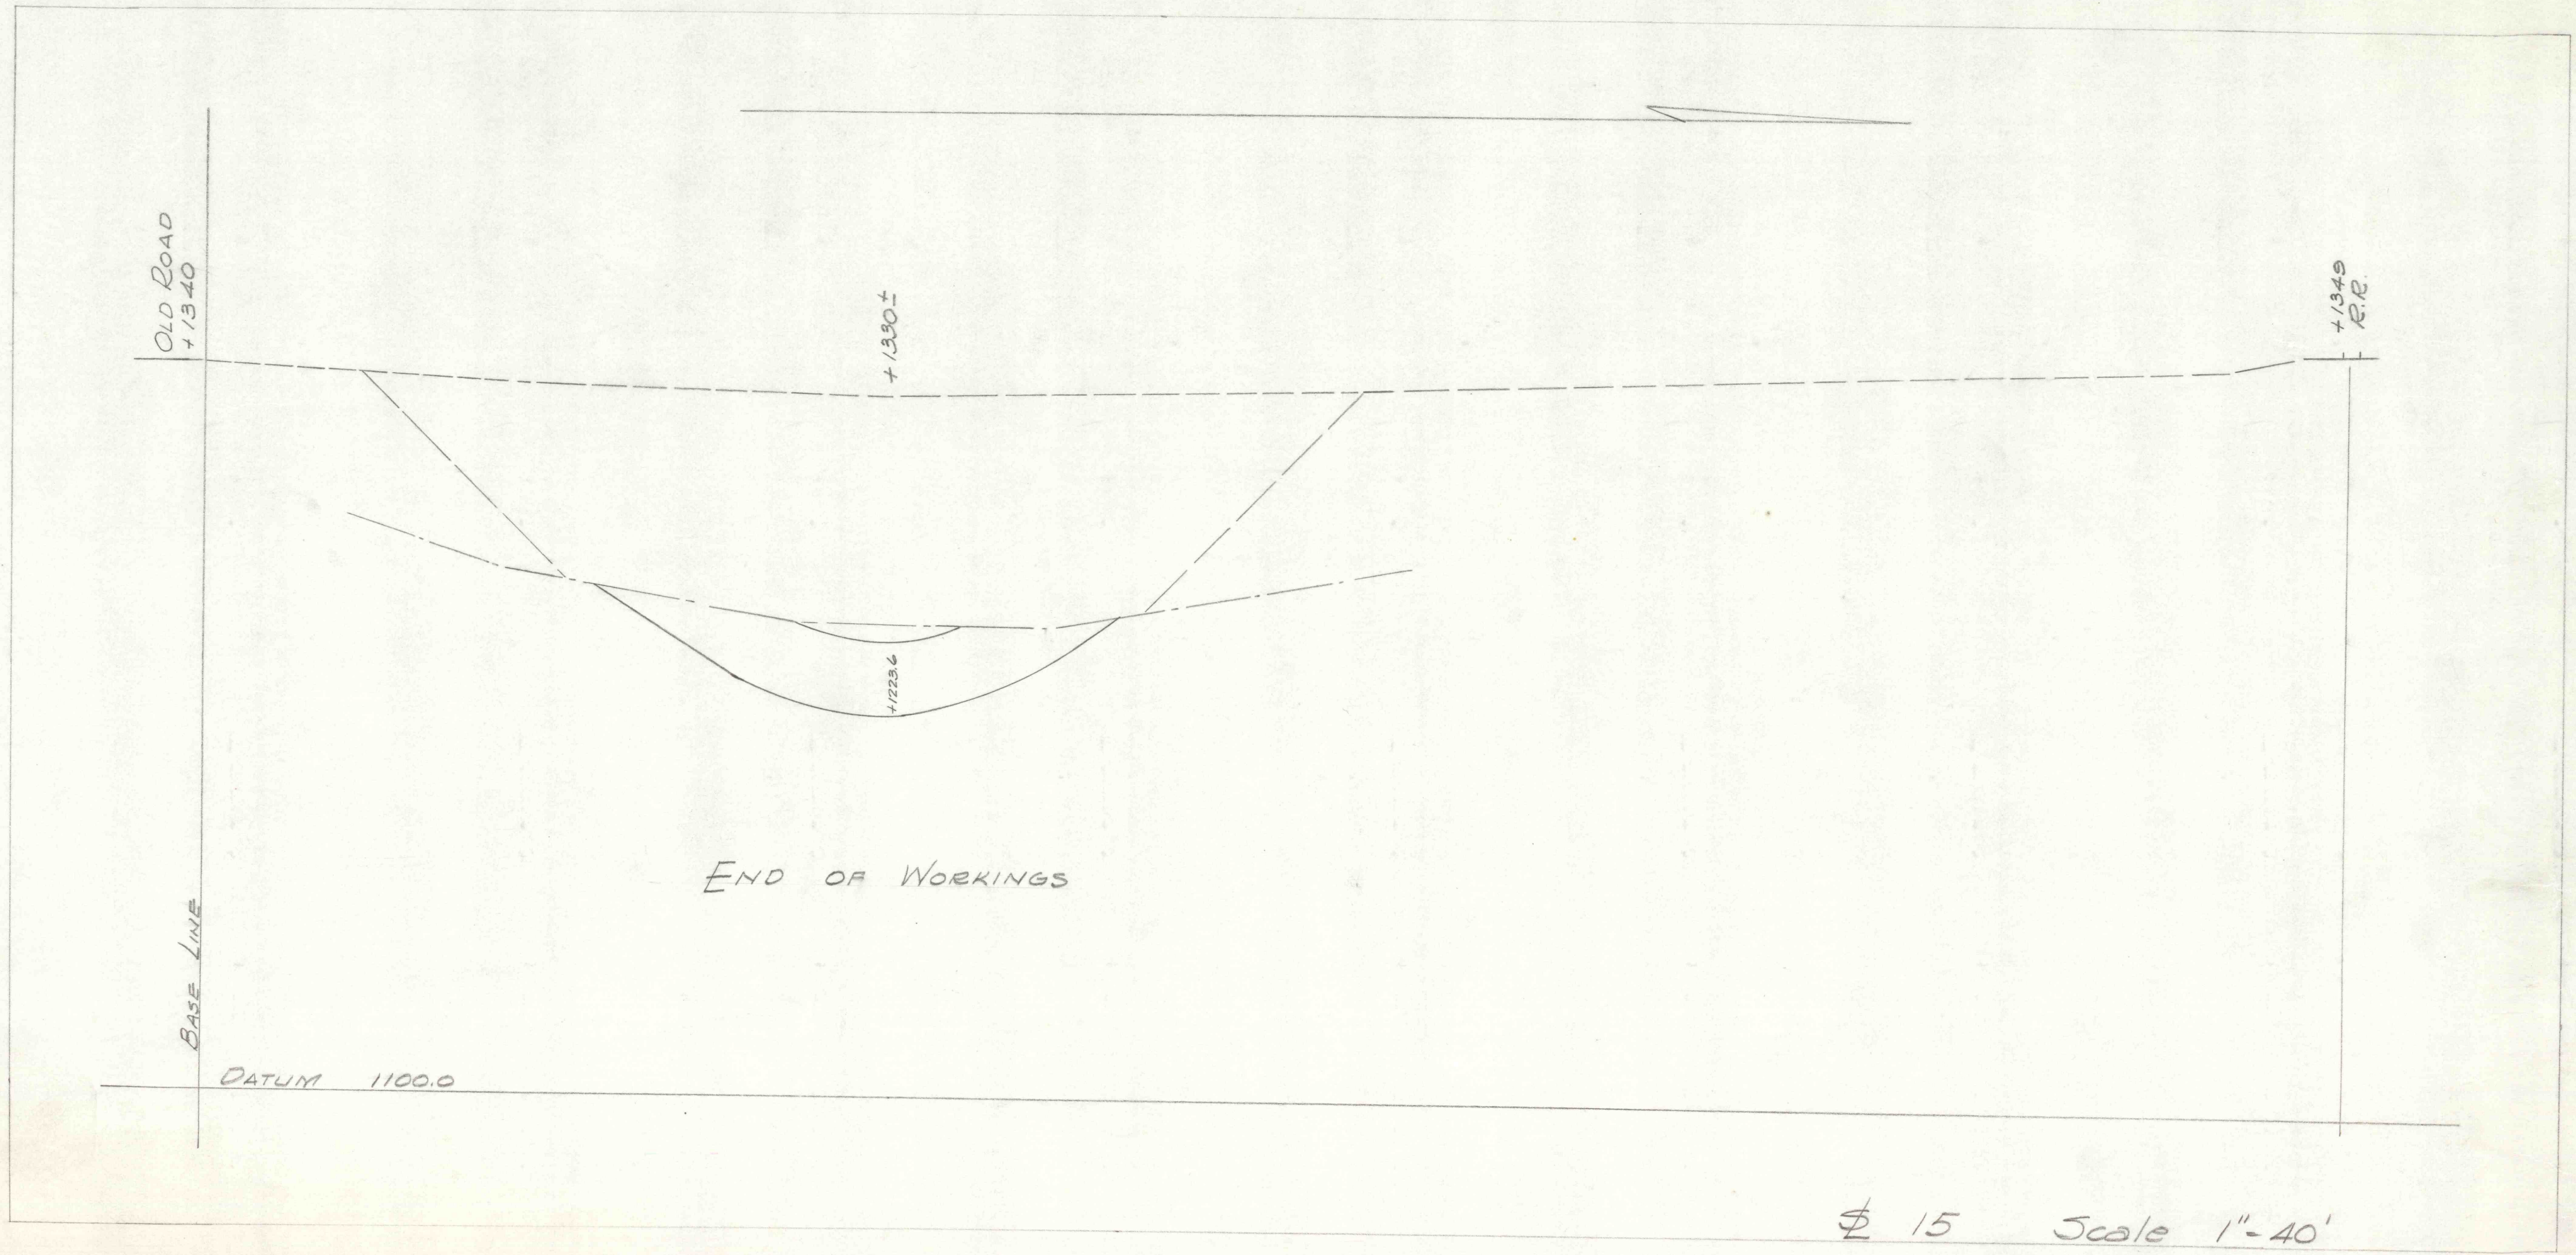

\$ 15 Scale 1" = 40'