


PIT AS OF
MAY 1, 1958

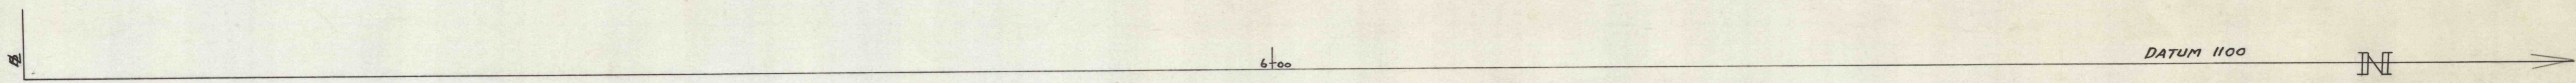

J. ROBERT BAZLEY, Inc.		
POTTSVILLE, PENNA.		
LOGAN MAMMOTH		
VEIN STRIPPING		
SECTION 56+00		
DATE	SCALE	BY
12-55	1"=50'	