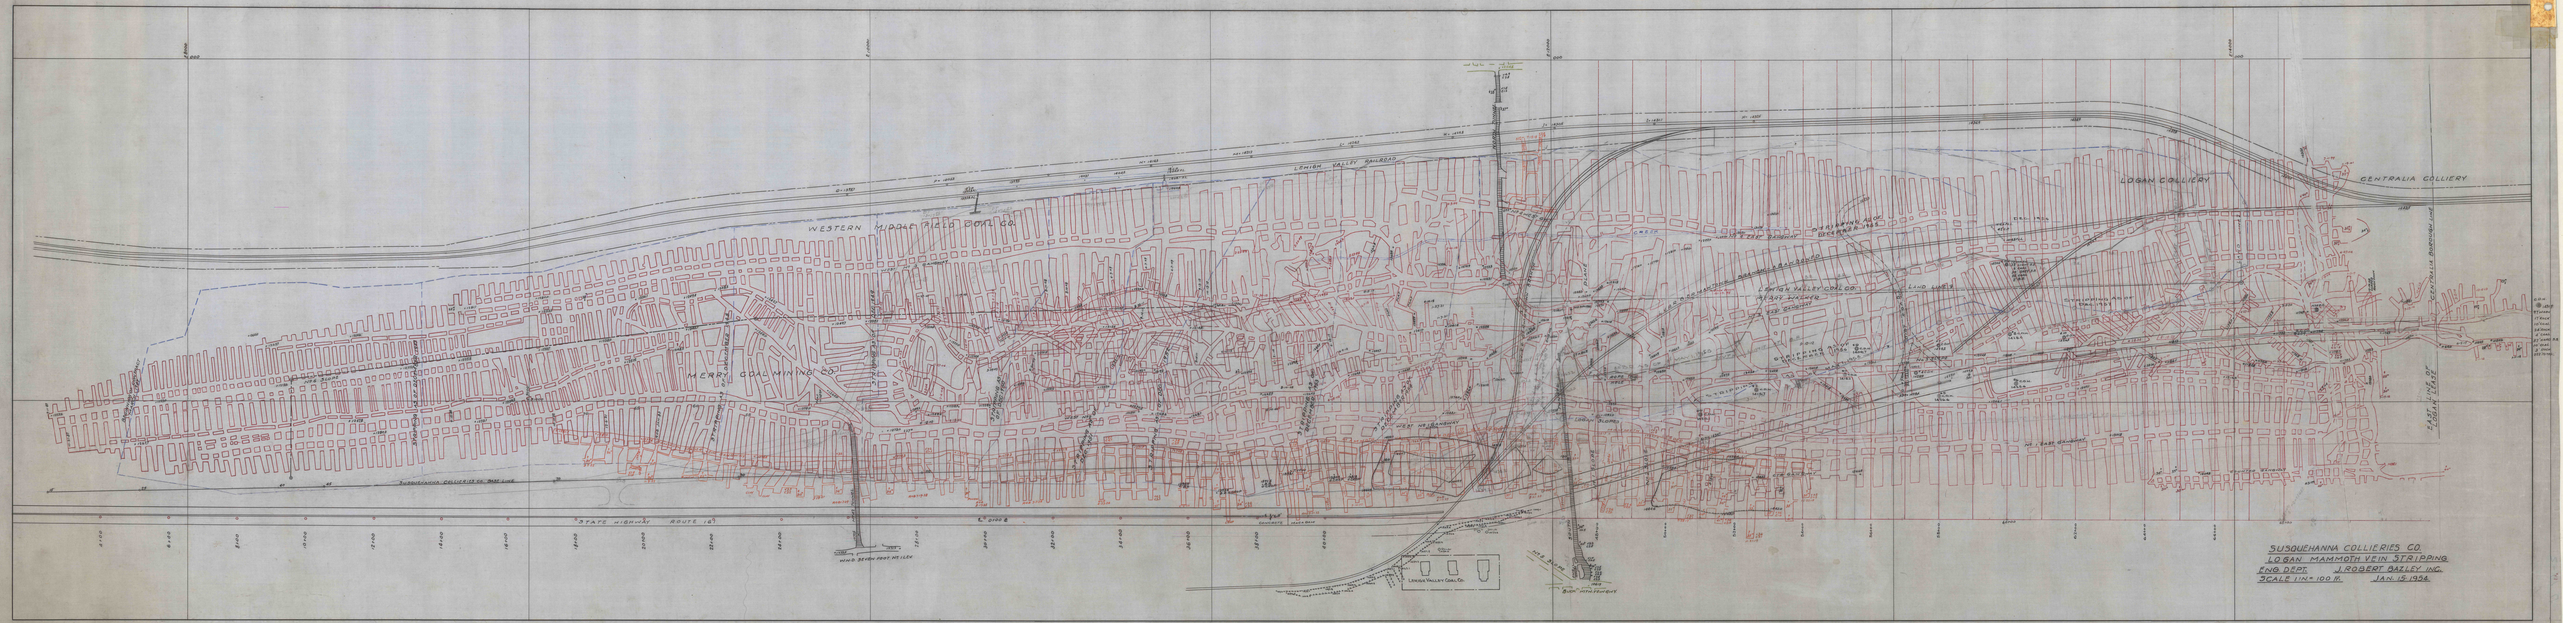
LOGAN COLLIERY
CENTRALIA COLLIERY
LEHIGH VALLEY RAILROAD
MERRY COAL MINING CO.
LEHIGH VALLEY COAL CO.
SUSQUEHANNA COLLIERIES CO. LINE
CENTRALIA BOROUGH LINE
SUSQUEHANNA COLLIERIES CO.
LOGAN MAMMOTH VEIN STRIPPING
ENG. DEPT. J. ROBERT BAILEY, INC.
SCALE 1 IN = 100 ft. JAN. 15, 1934