


RESERVATION

RESERVATION

S-1

S-1

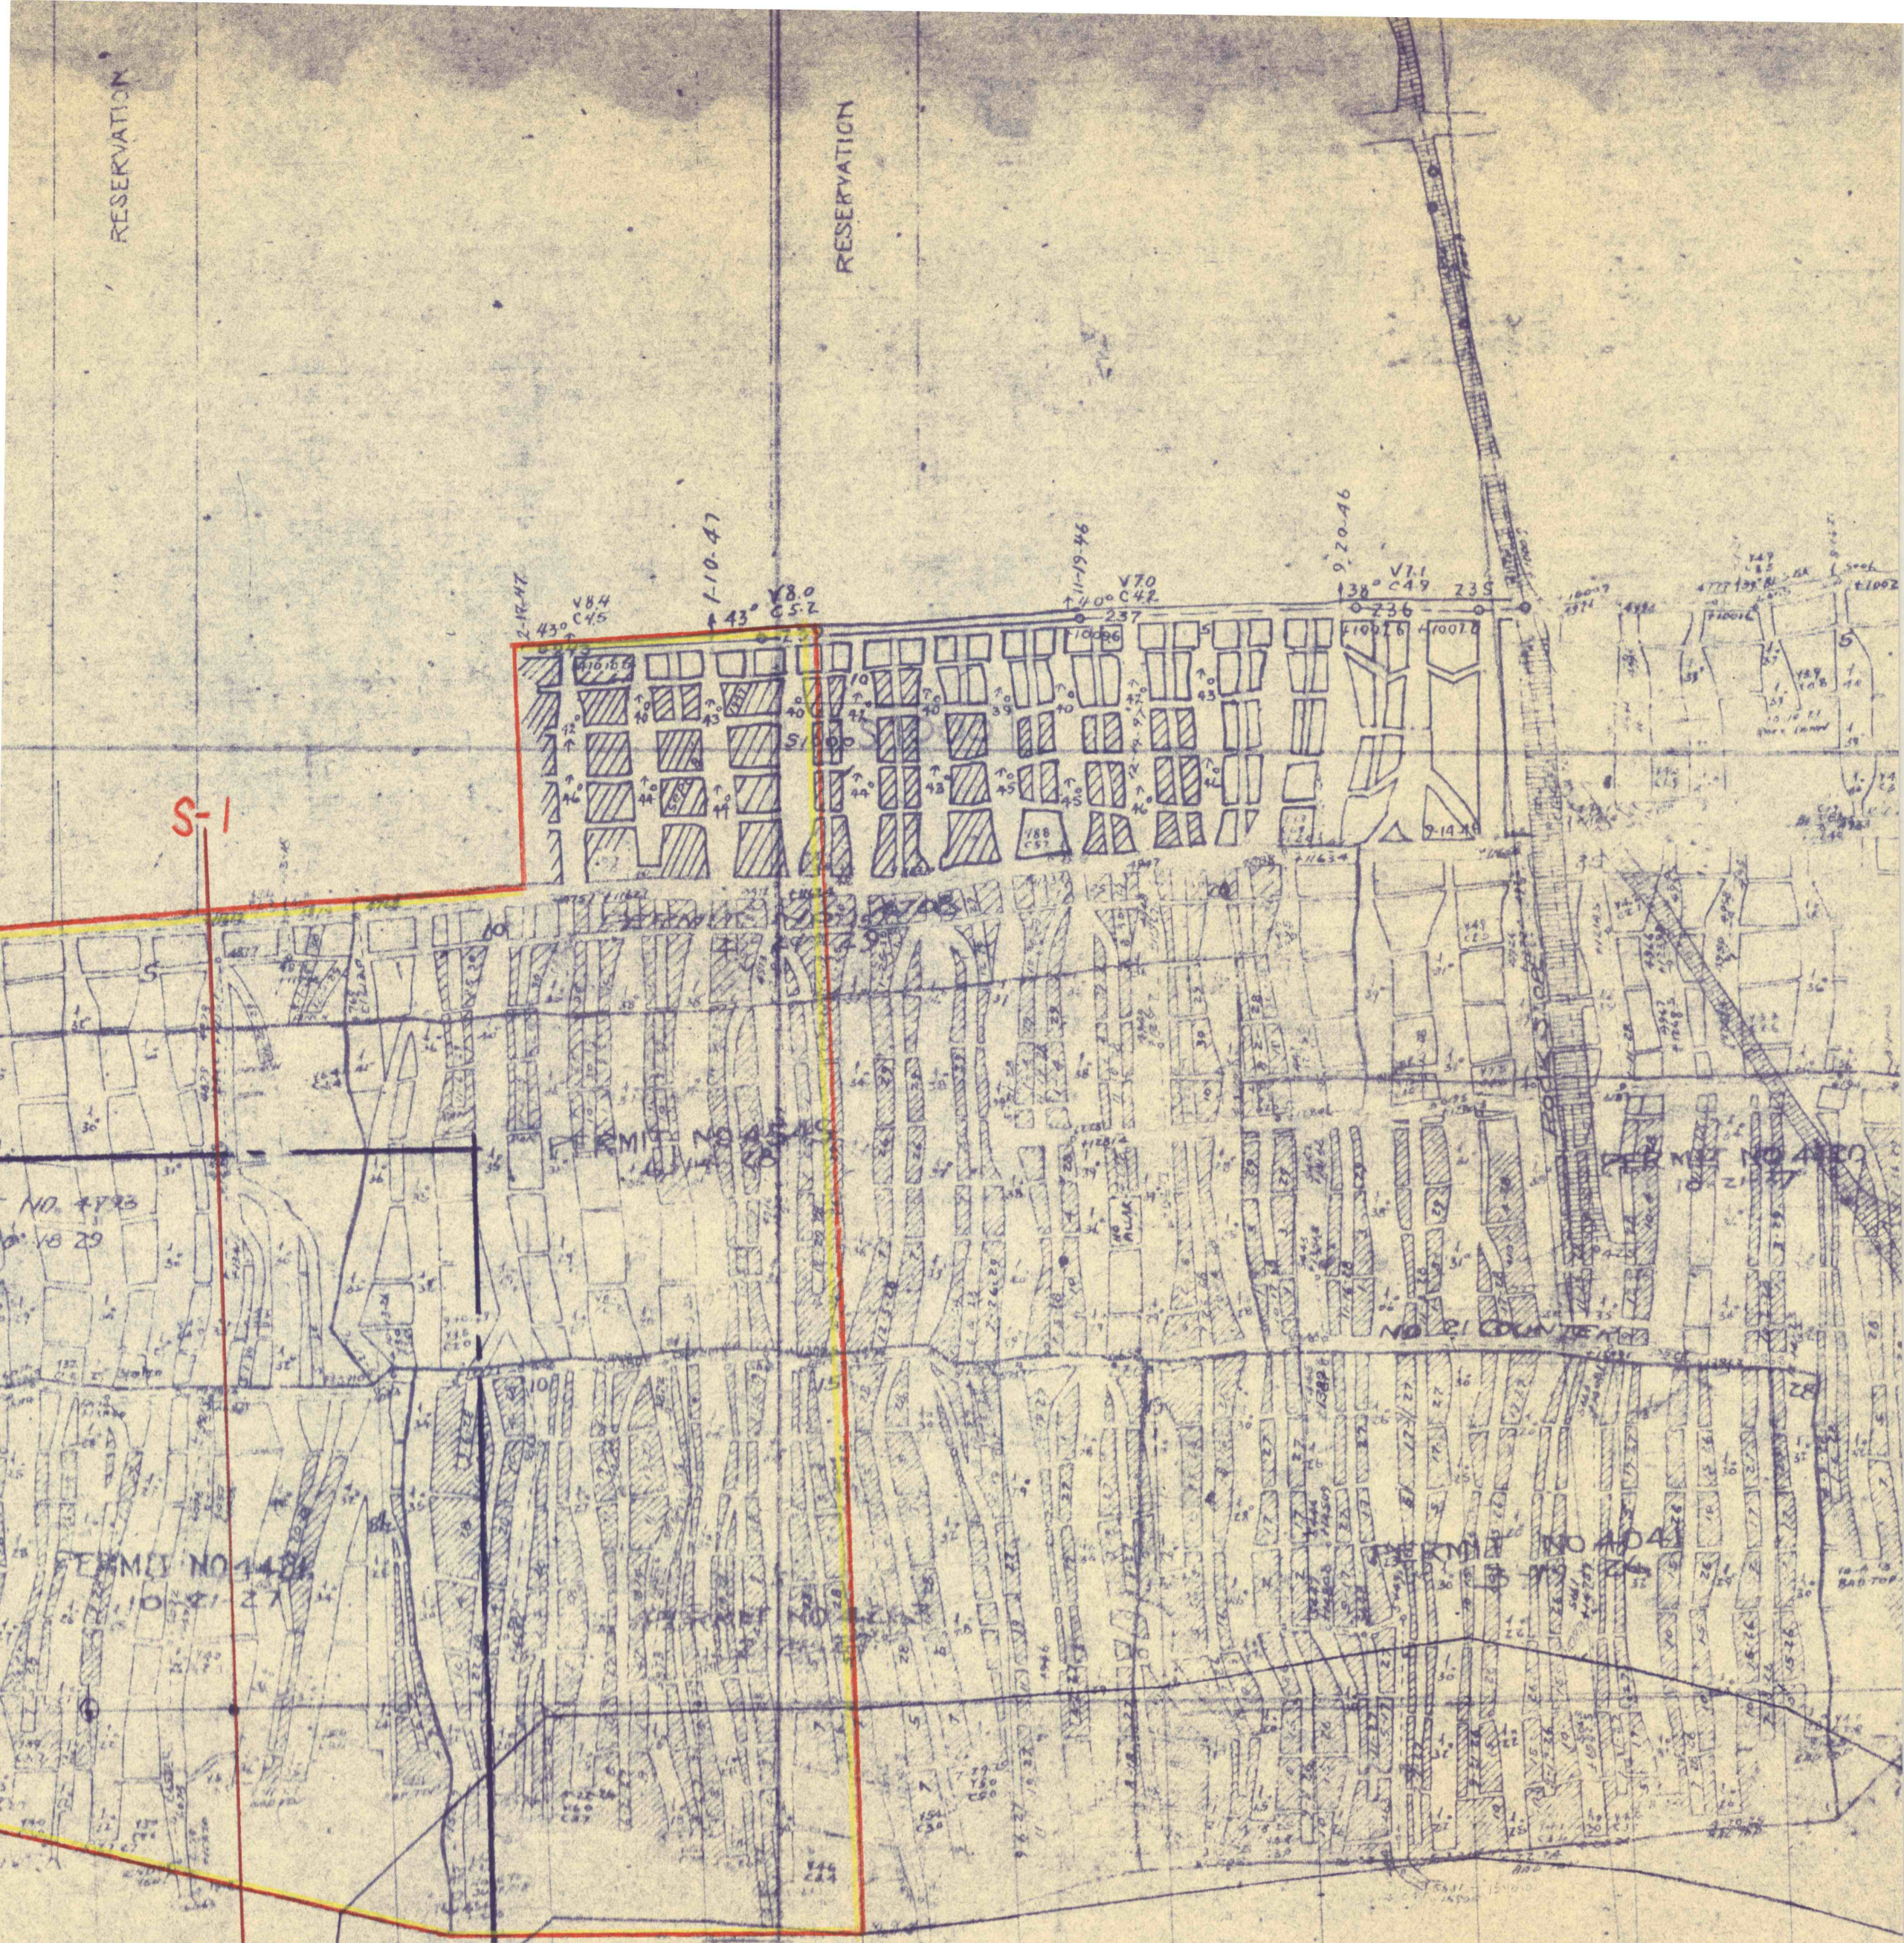

E 19,000'

SEVEN FOOT VEIN  
 S 2,000'  
 CENTRALIA, PA.  
 1" = 100'

I.O.P.F.  
 CEMETERY

1 3 5 7 9 11 13 15 17 19 21