


C R I & C CO

L MTN C & I CO

P & R C & I CO

CONTINENTAL SHAFTESTATE
GIRARD CO & R C & P

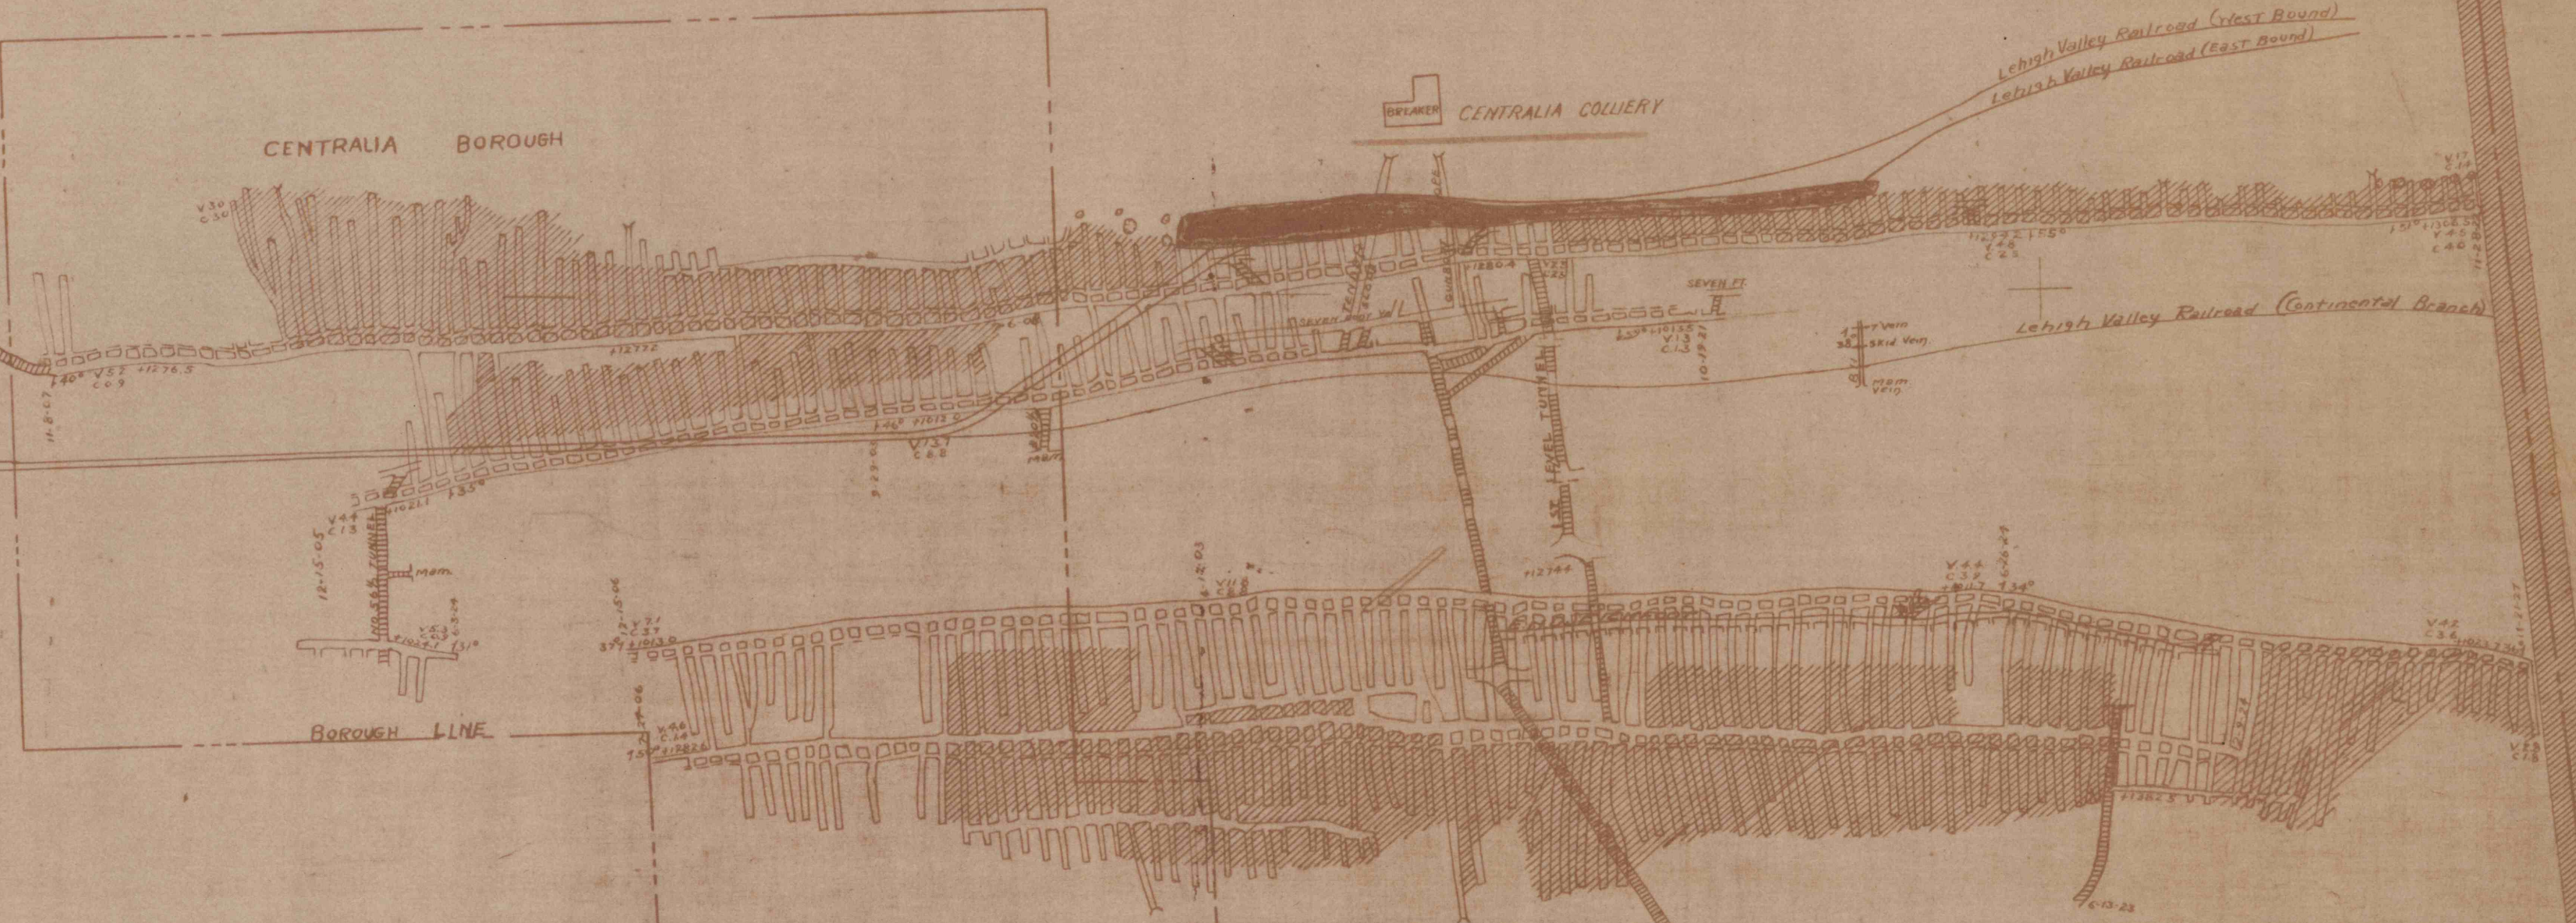

WESTERN MIDDLE FIELD
 NORTH CONYNGHAM TWP.
 COLUMBIA COUNTY, PA.
 SKIDMORE VEIN
 CENTRALIA COLLIERY
 Lehigh Valley COAL
 Collieries.

WEST MIDDLE FIELD
 NORTH CONYNGHAM TWP.
 COLUMBIA COUNTY, PA.
 SKIDMORE VEIN
 CENTRALIA COLLIERY
 Lehigh Valley COAL
 Collieries.