


NORTH
6-16-76

SECOND ST

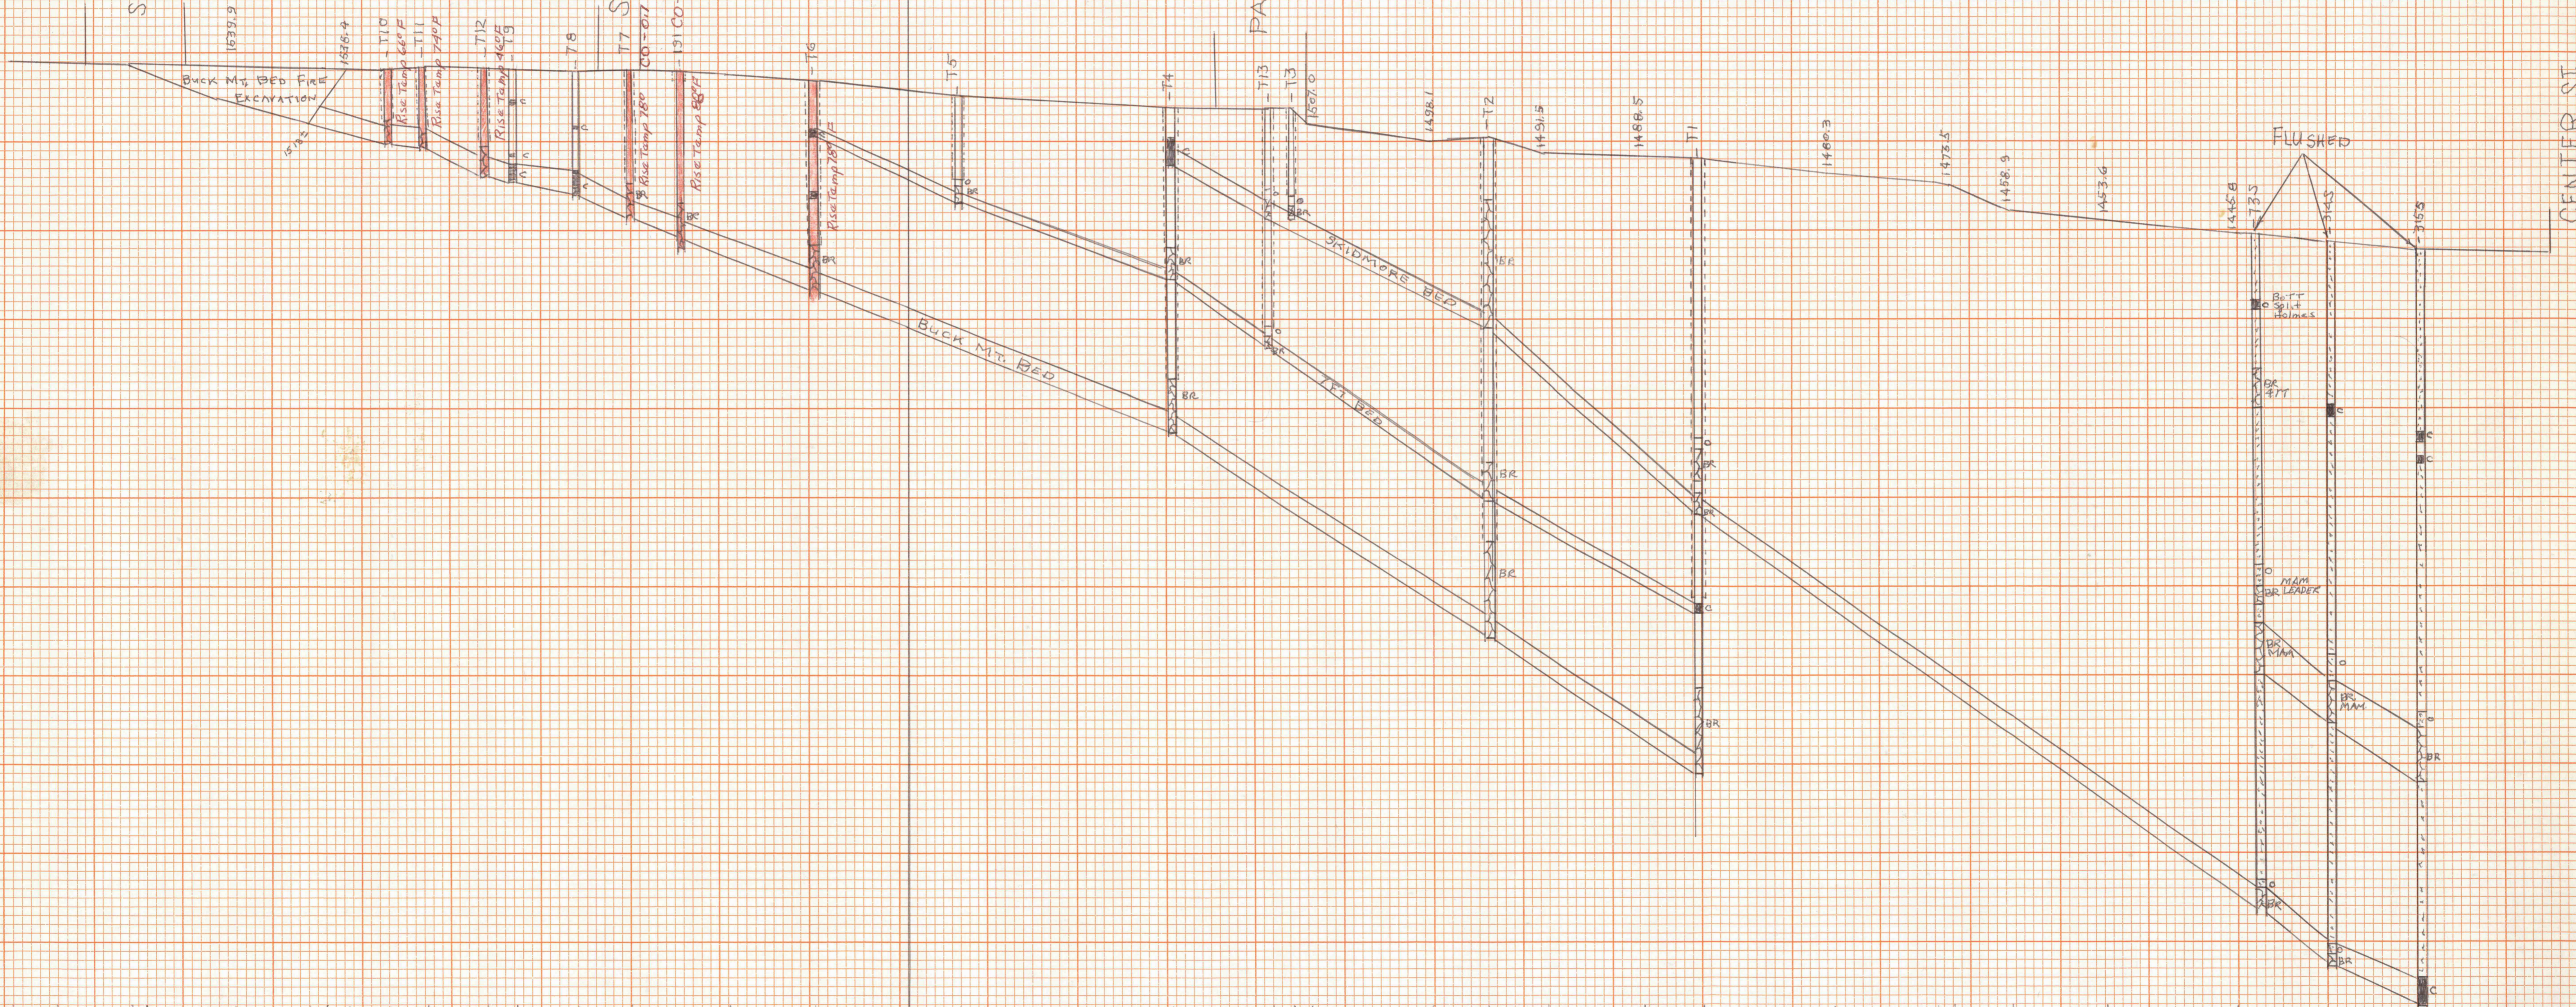

CENTER ST

DATUM +1000

SEC S1W
WOOD ST
CROSS-SECTION THRU MONITORING HOLES DRILLED
FOR
DETERMINING THE EFFECTIVENESS OF
THE FLUSH-FLY ASH BARRIER COMPLETED IN DEC. 1973

WATER
TABLE
1"=50'