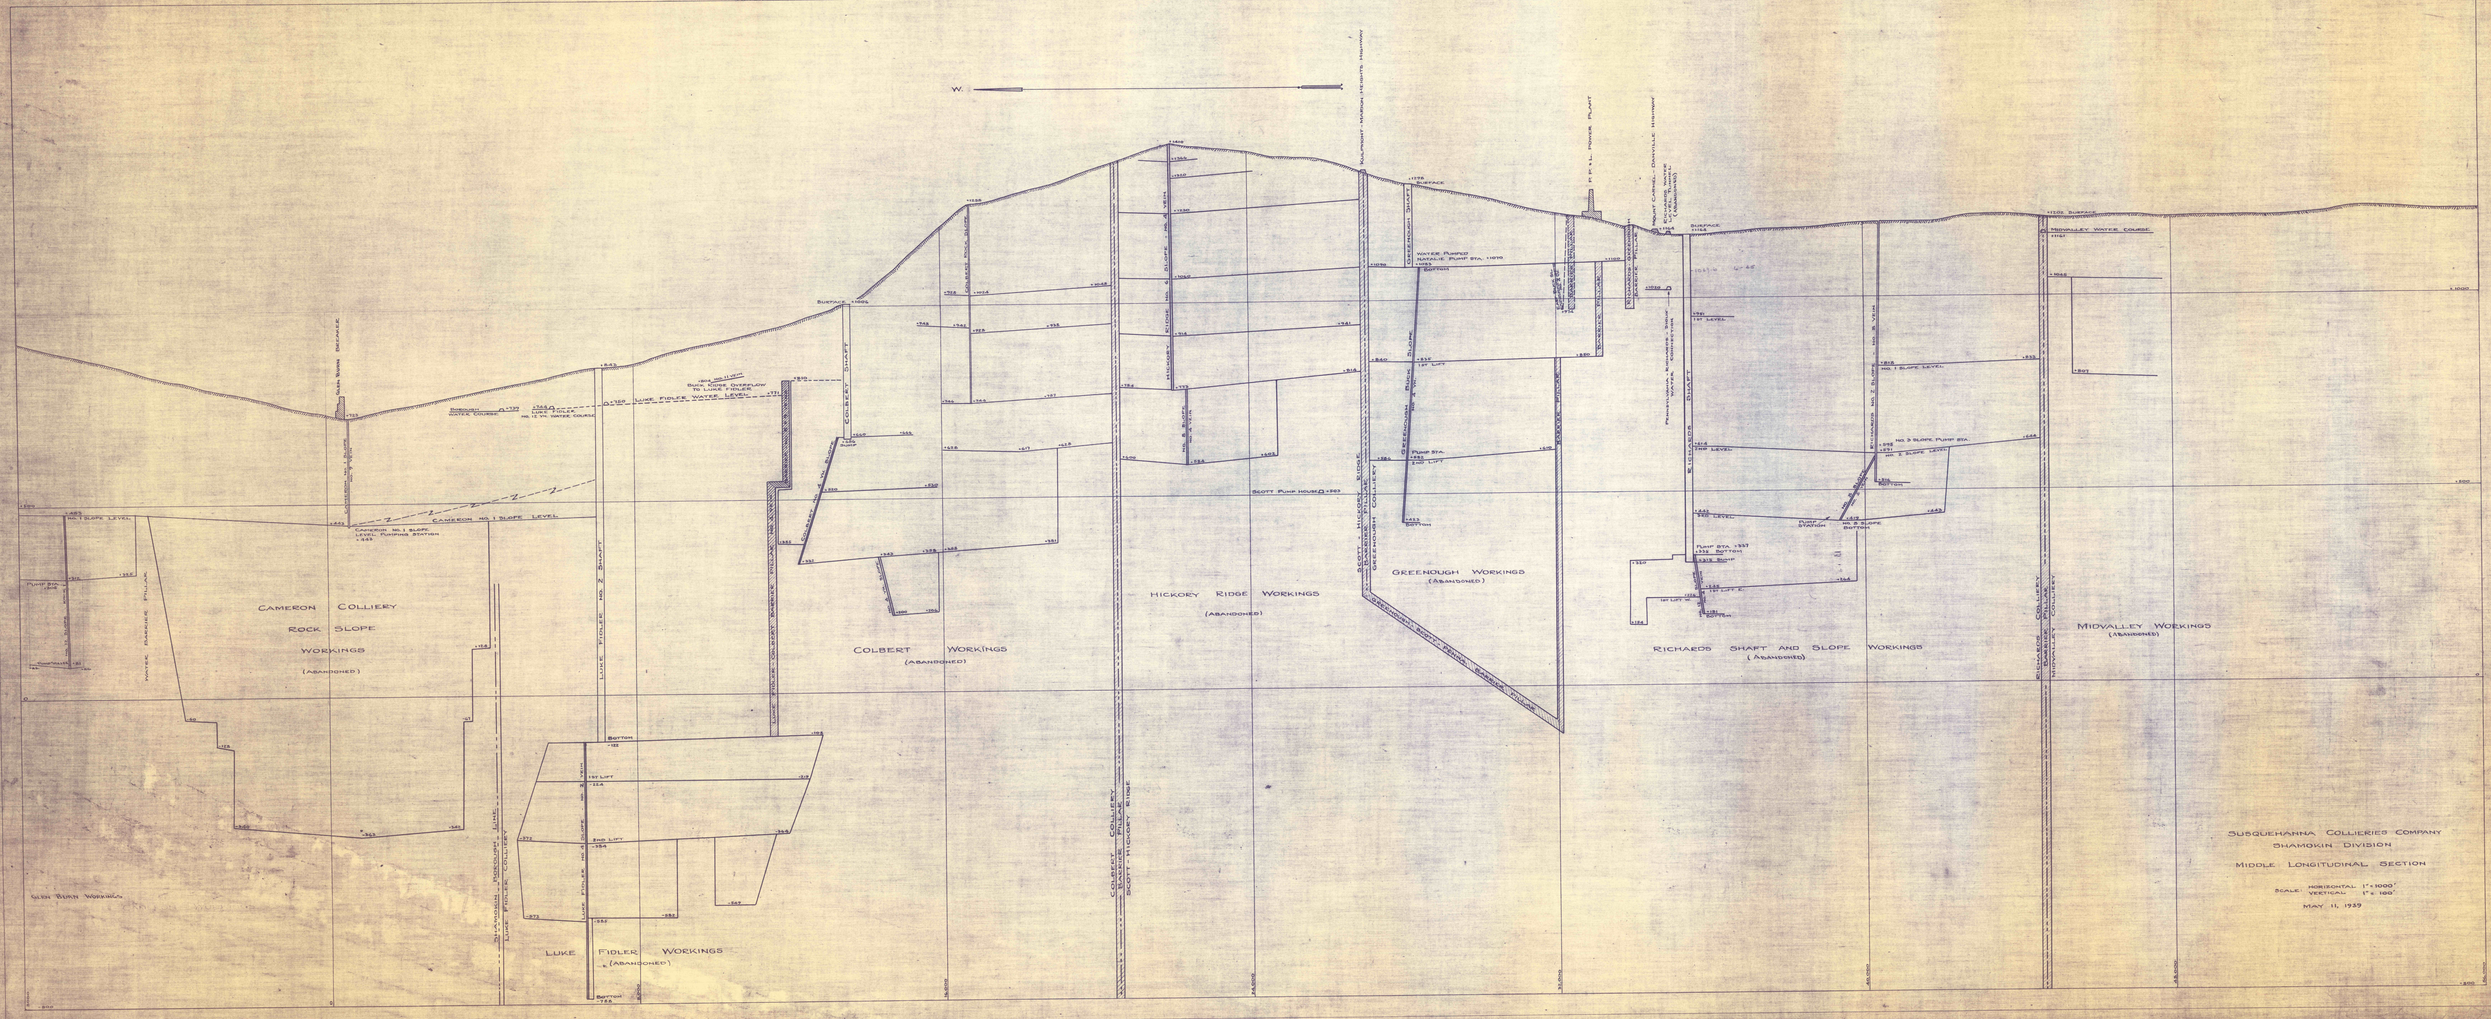
SUSQUEHANNA COLLIERIES COMPANY
SHAMOKIN DIVISION
MIDDLE LONGITUDINAL SECTION
SCALE: HORIZONTAL 1" = 1000'
VERTICAL 1" = 100'
MAY 11, 1939
CAMERON COLLIERY
ROCK SLOPE
WORKINGS
(ABANDONED)
COLBERT WORKINGS
(ABANDONED)
HICKORY RIDGE WORKINGS
(ABANDONED)
GREENOUGH WORKINGS
(ABANDONED)
RICHARDS SHAFT AND SLOPE WORKINGS
(ABANDONED)
MIDVALLEY WORKINGS
(ABANDONED)
LUKE FIDLER WORKINGS
(ABANDONED)
GLEN BURN WORKINGS
CAMERON NO. 1 SLOPE LEVEL
LUKE FIDLER WATER LEVEL
SURFACE
COLBERT SHAFT
LUKE FIDLER NO. 2 SHAFT
SCOTT PUMP HOUSE
PUMP STA.
1ST LIFT
2ND LIFT
BOTTOM
MIDVALLEY WATER COURSE
NO. 3 SLOPE PUMP STA.
NO. 3 SLOPE LEVEL
NO. 2 SLOPE BOTTOM
NO. 1 SLOPE LEVEL
PUMP STA. 1337
1312 BOTTOM
1313 SUMP
1ST LIFT W.
2ND LIFT E.
1ST LIFT W.
W.