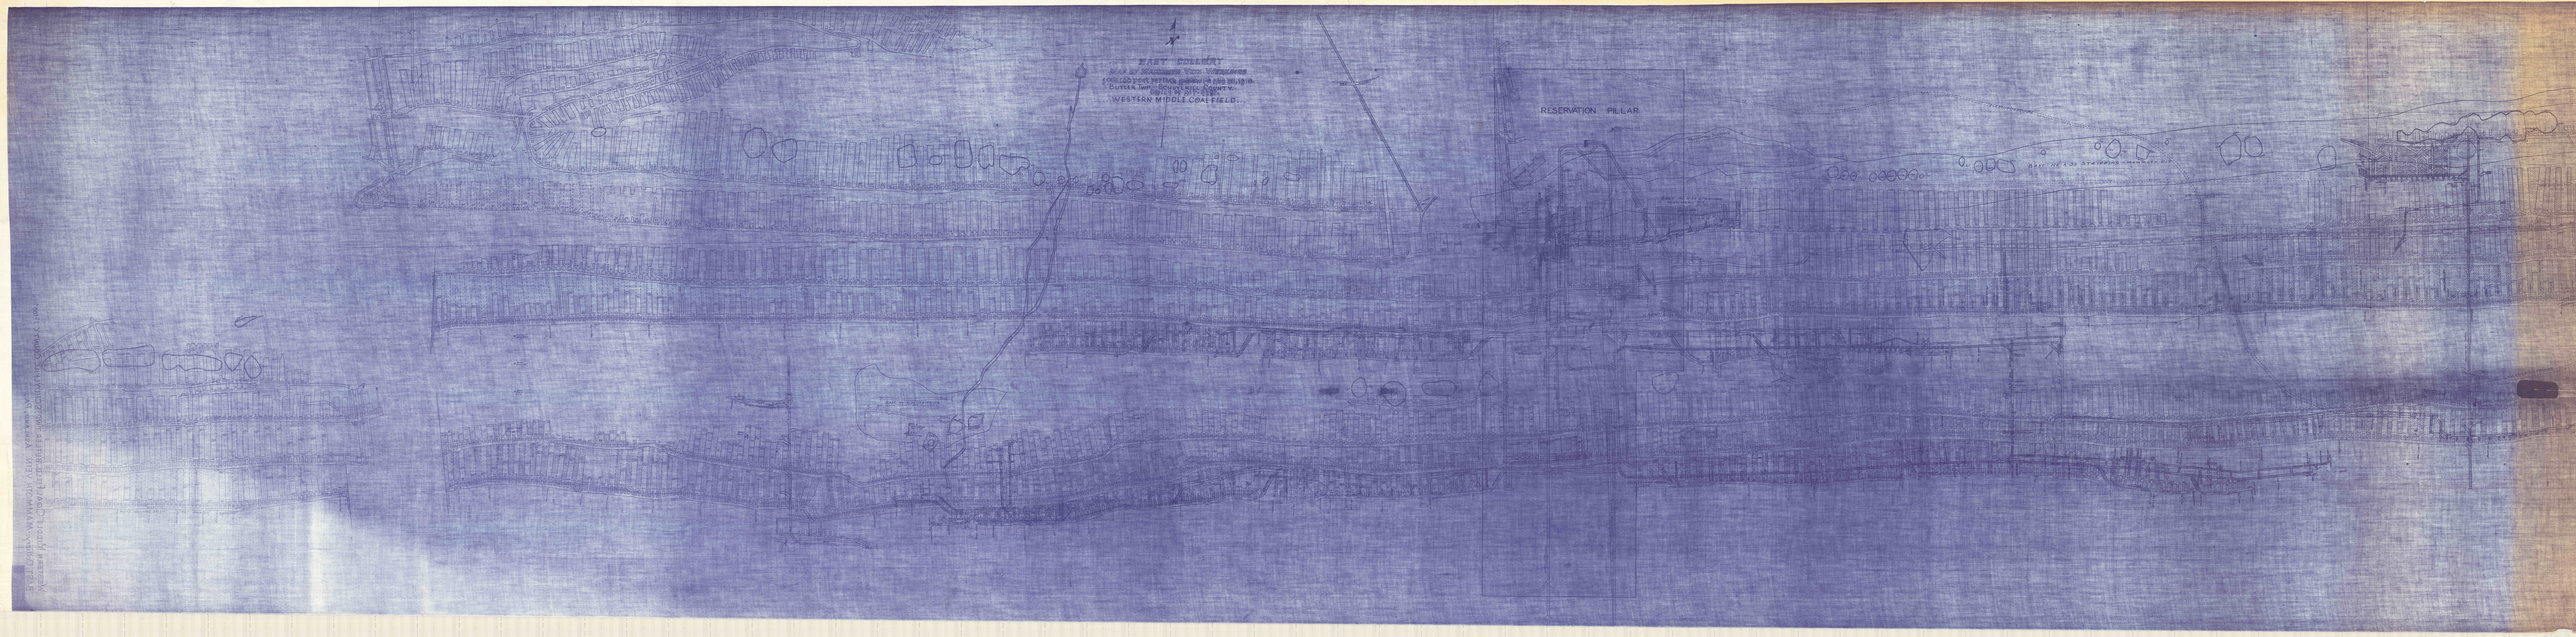

N
EAST COLLIERY
SURVEYED BY
WESTERN MIDDLE COAL FIELD.
RESERVATION PILLAR.