


BAST NO. A-35 STRIPPING
MAMMOTH PIT

A-35 HOLMES VEIN PIT

A-35 HOLMES VEIN PIT

A-35 HOLMES VEIN PIT

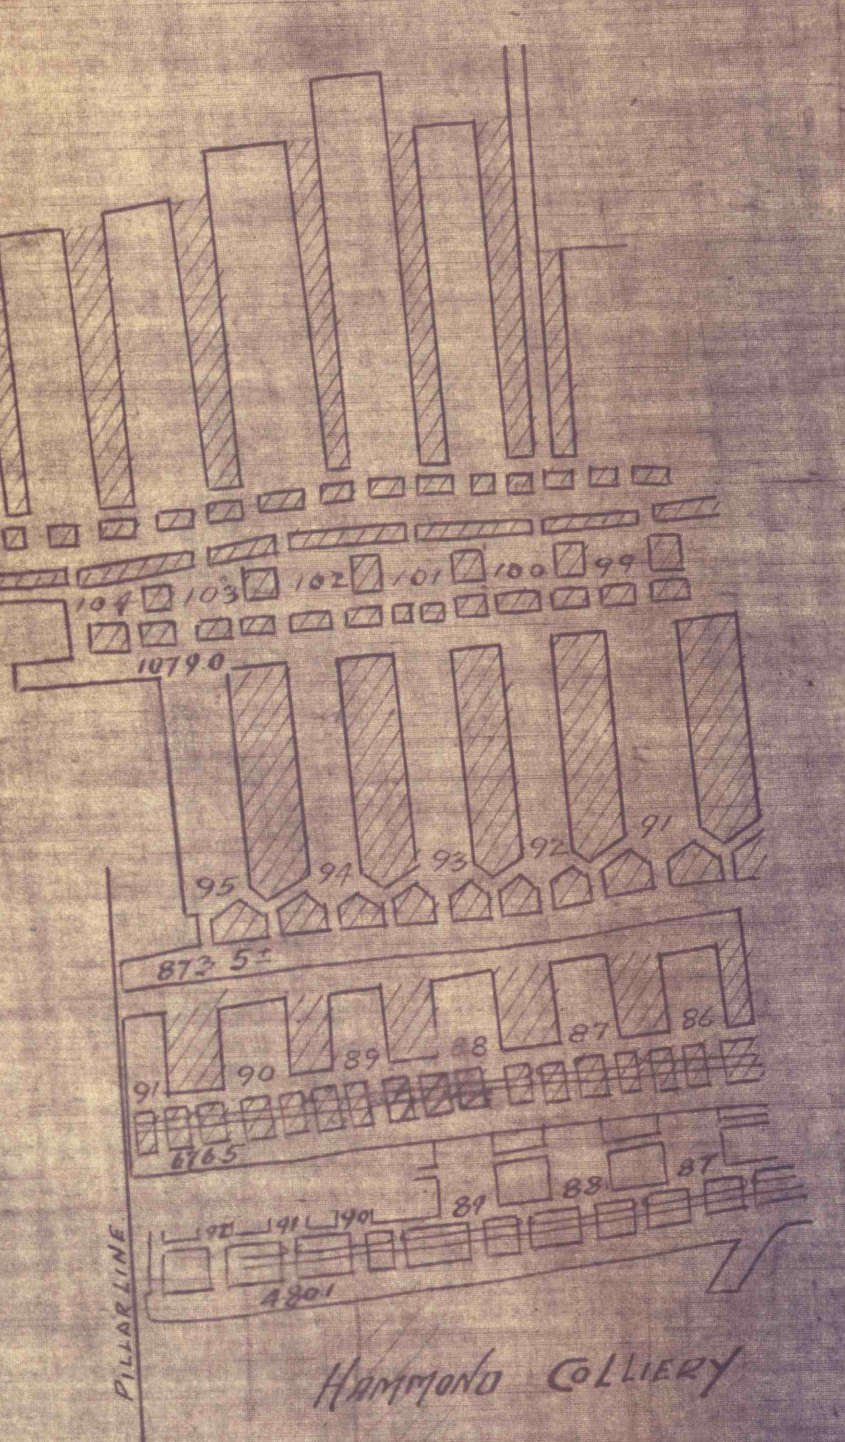

BAST COLLEGE 1100. MAMMOTH VEIN
WESTERN MIDDLE COAL FIELD BUTLER LAW
SHADE TOWNSHIP COLE COUNTY