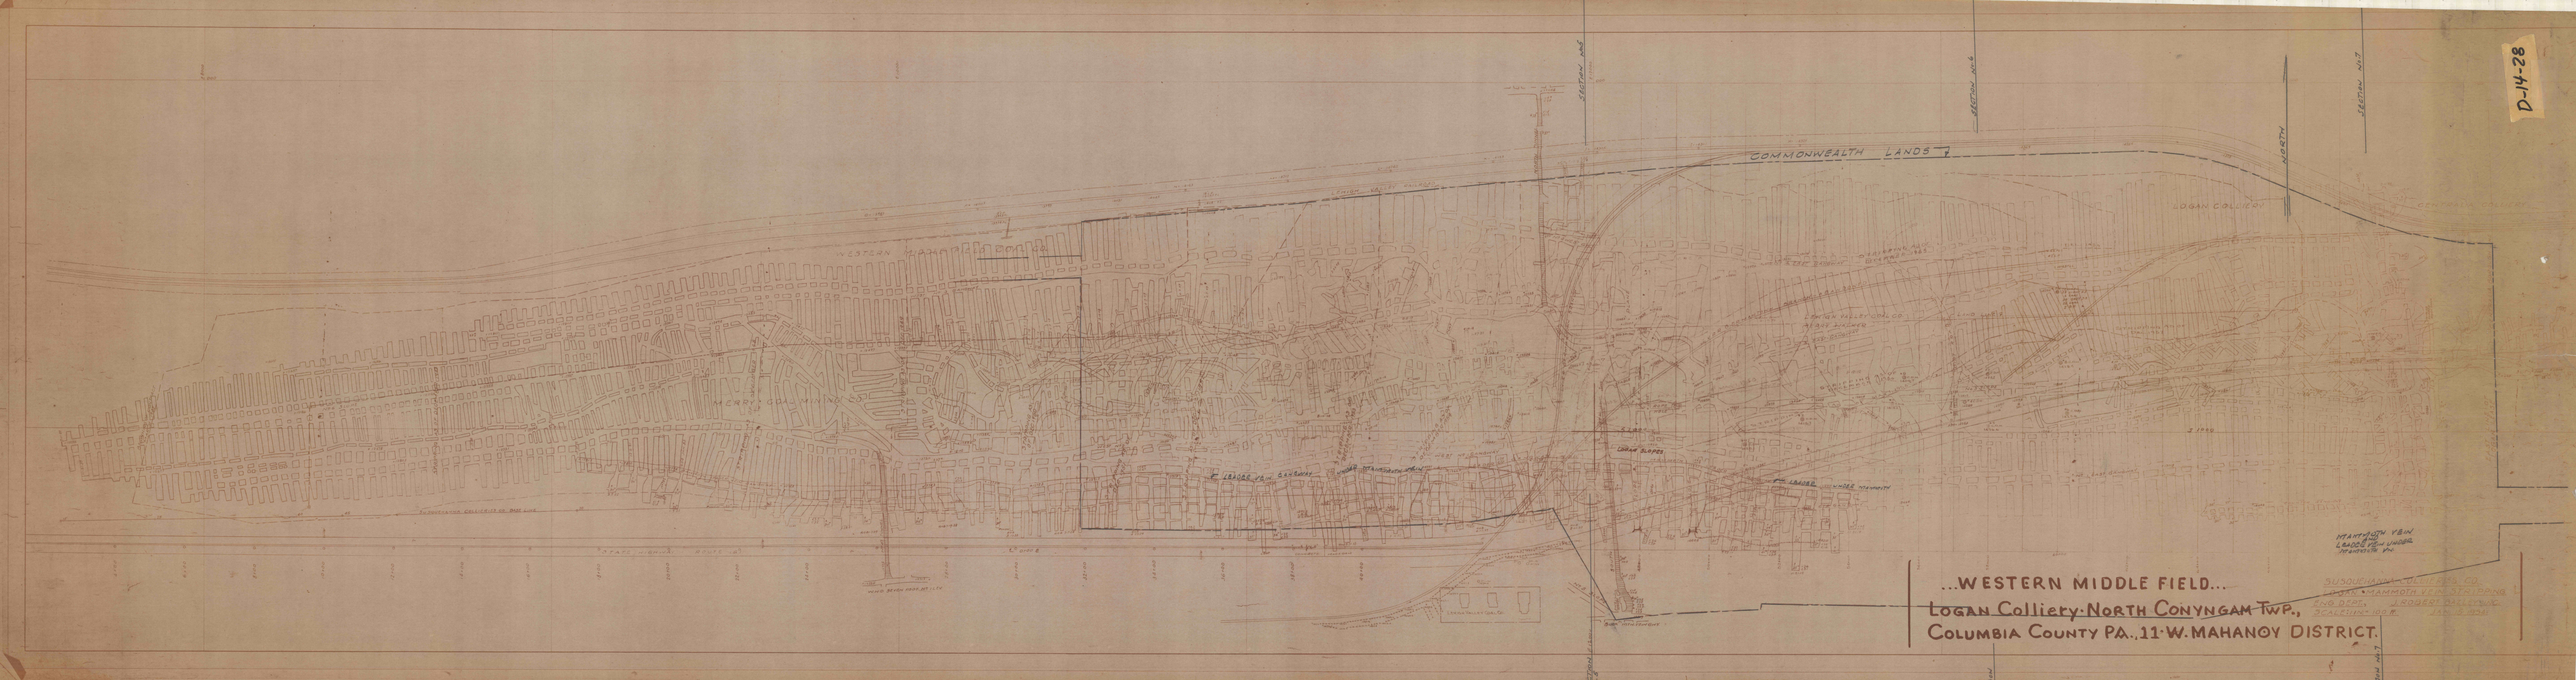
D-14-28
COMMONWEALTH LANDS
SECTION NO.5
SECTION NO.6
SECTION NO.7
NORTH
LOGAN COLLIERY
WESTERN
MORRIS COAL MINING CO.
LOGAN SLOPES
...WESTERN MIDDLE FIELD...
LOGAN COLLIERY-NORTH CONYNGAM TWP.,
COLUMBIA COUNTY PA., 11 W. MAHANOY DISTRICT.