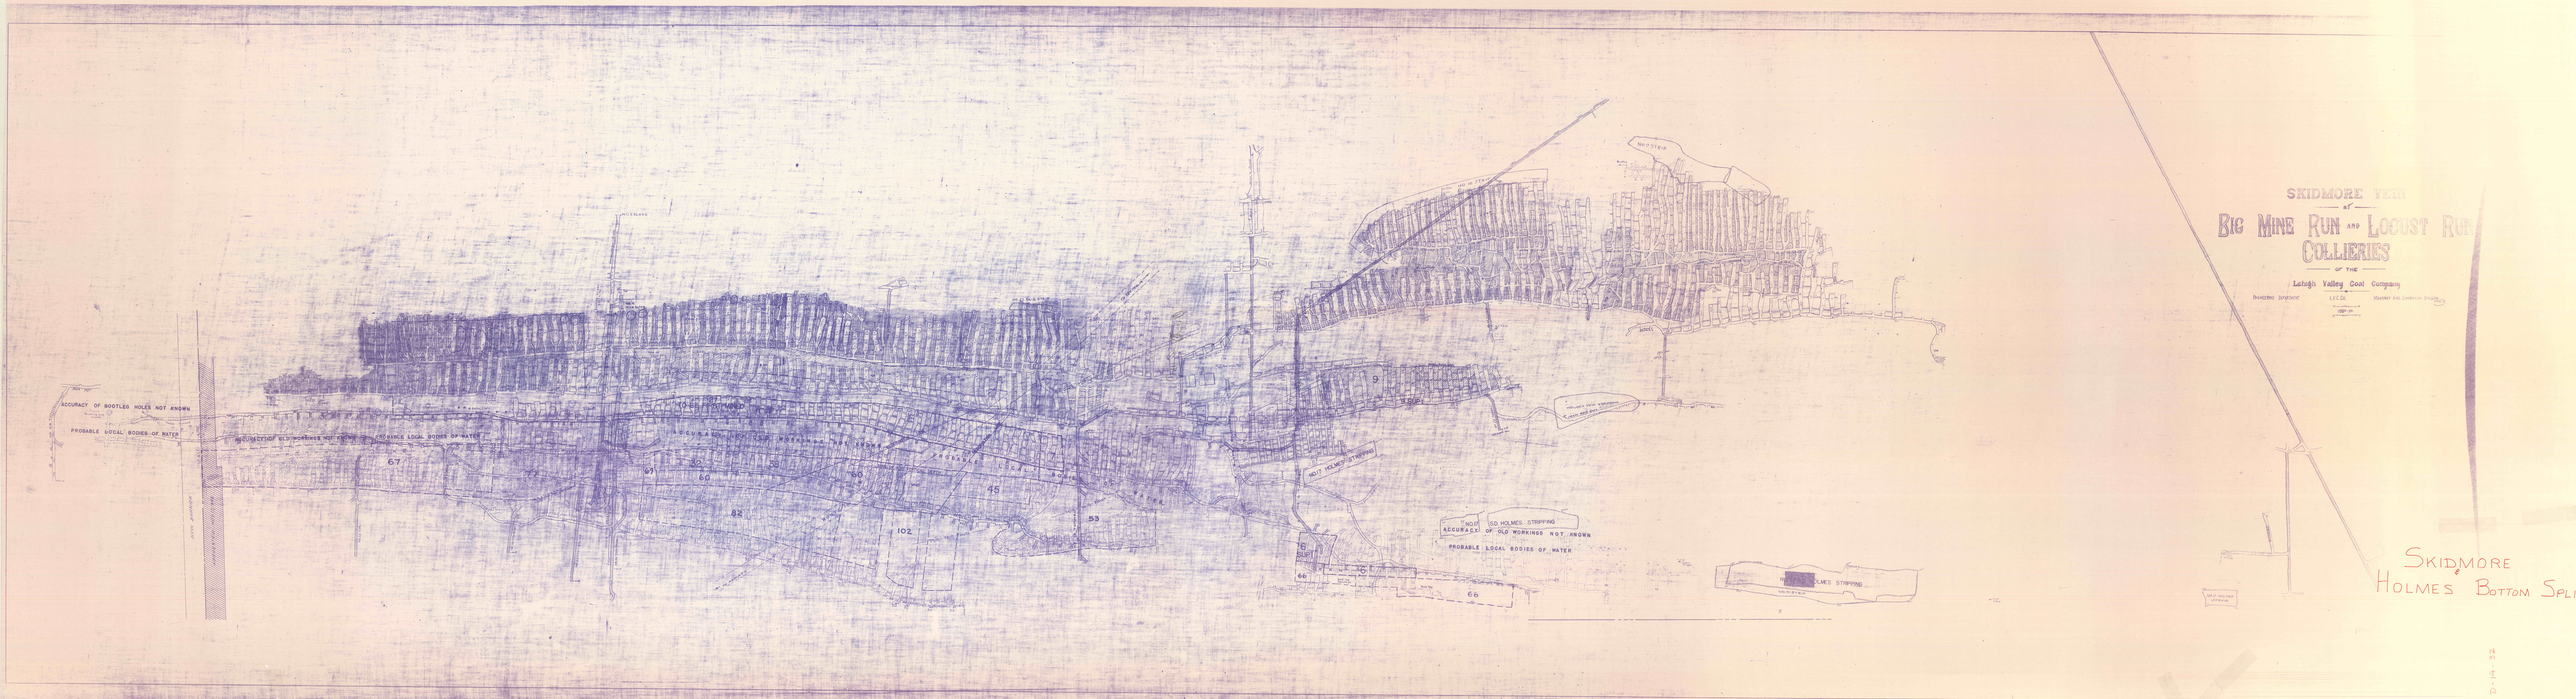
SKIDMORE VEIN
at
BIG MINE RUN AND LOCUST RUN
COLLIERIES
OF THE
Lehigh Valley Coal Company
DIAMOND DEPARTMENT
L.V.C.Co.
MAHANOY AND SHAMOKIN DIVISION
ACCURACY OF BOOTLEG HOLES NOT KNOWN
PROBABLE LOCAL BODIES OF WATER
ACCURACY OF OLD WORKINGS NOT KNOWN
PROBABLE LOCAL BODIES OF WATER
NO.17 HOLMES STRIPPING
NO.17 S.D. HOLMES STRIPPING
ACCURACY OF OLD WORKINGS NOT KNOWN
PROBABLE LOCAL BODIES OF WATER
SKIDMORE
HOLMES BOTTOM SPLI
D-14-32