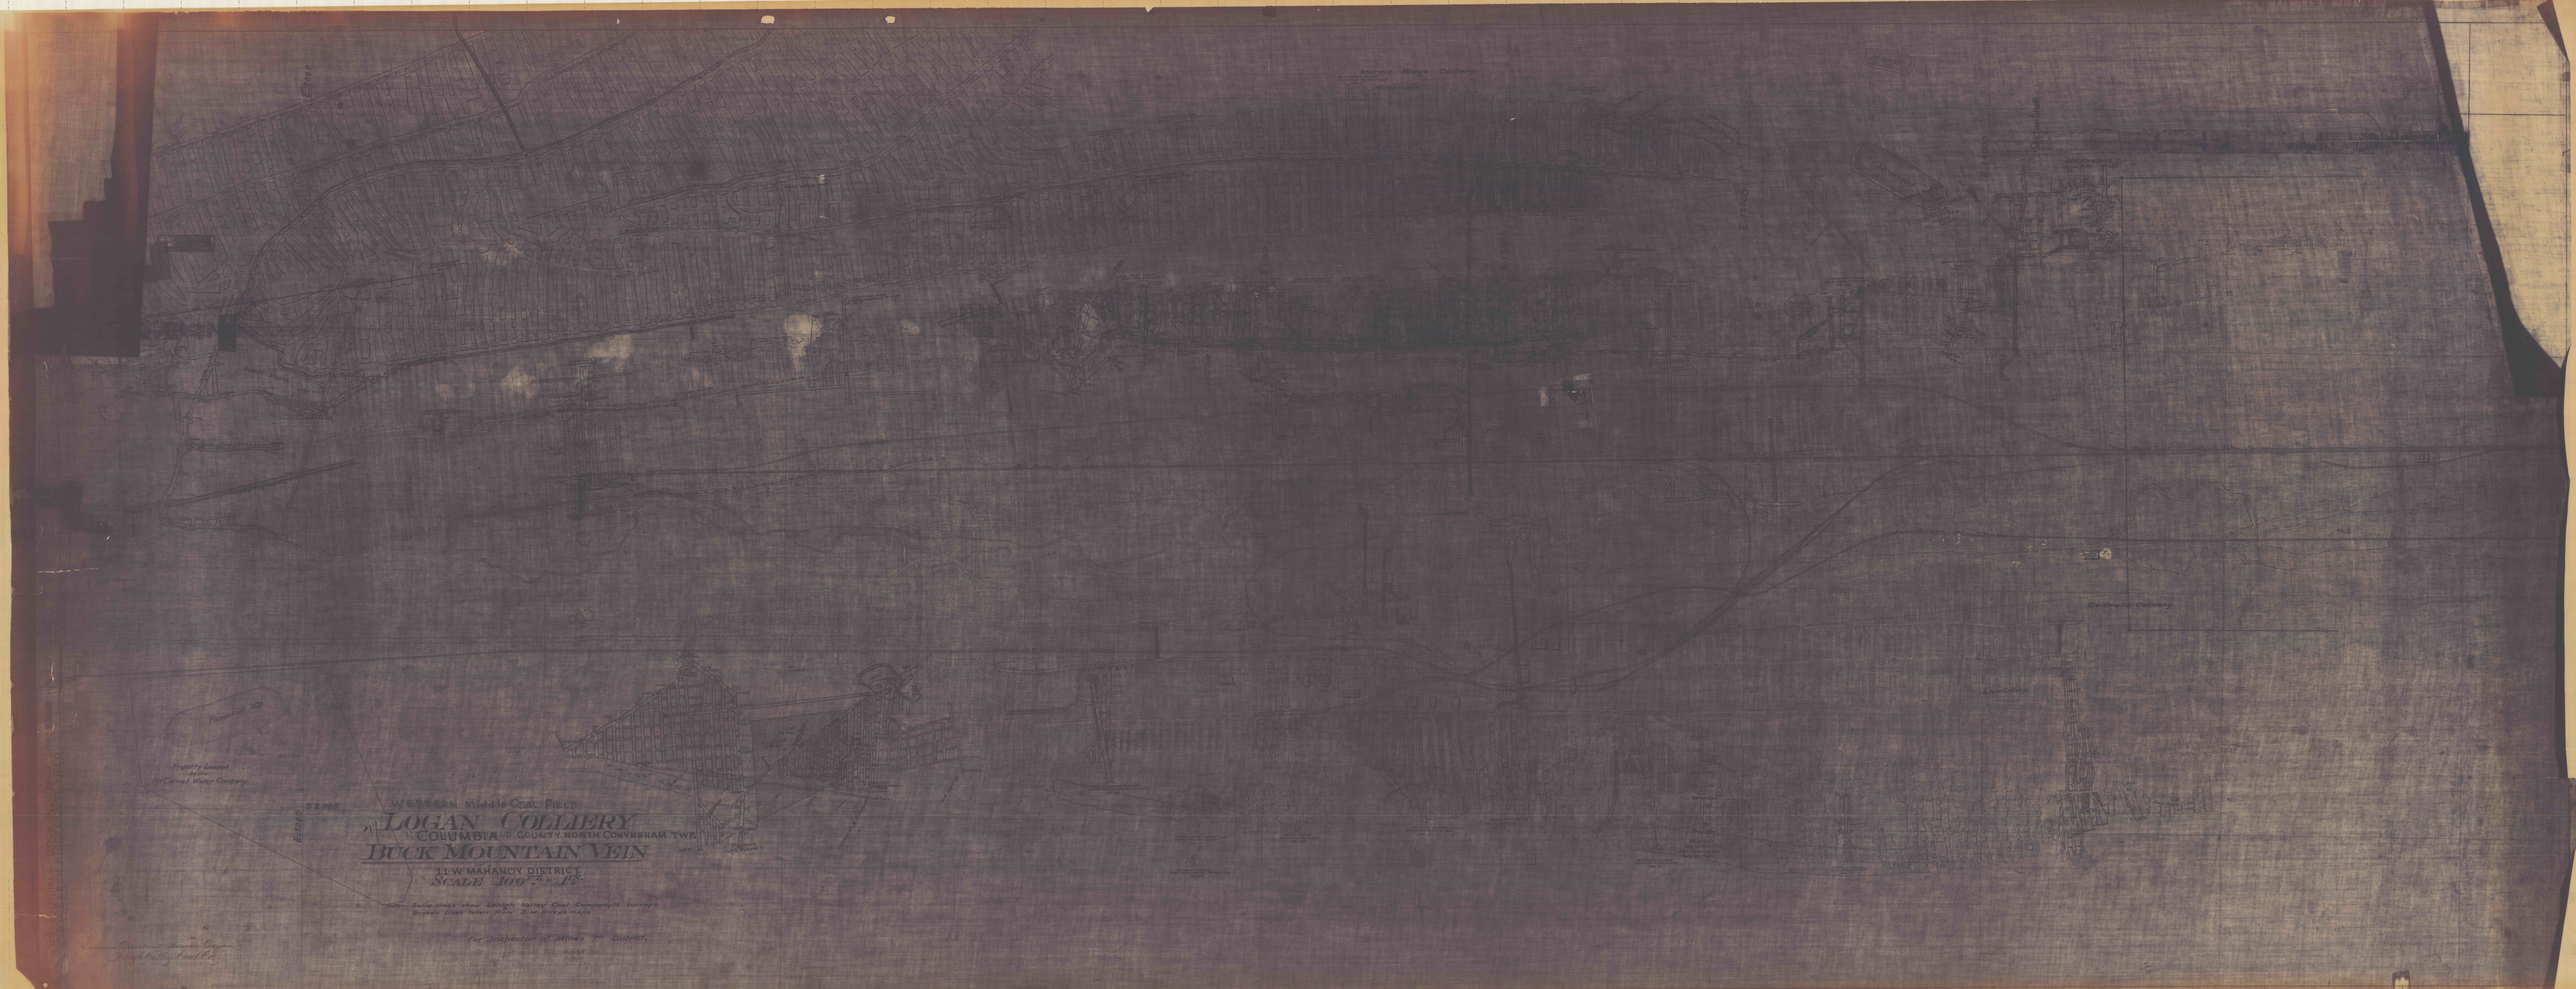
WESTERN Middle Coal Field.
LOGAN COLLIERY
COLUMBIA AND COUNTY. NORTH CONYNGHAM TWP.
BUCK MOUNTAIN VEIN
11 W MAHANOY DISTRICT
SCALE 100 Ft. = 1 In.
Note.—Solid lines show Lehigh Valley Coal Company's surveys
Broken lines taken from Sec. Ellwyn's maps
For Inspector of Mines 1st District.
Property leased from
Mt Carmel Water Company
Mountain Ridge Colliery
Locust Gap Colliery
Locust Gap
Coal Run
Mahanoy Creek
Mahanoy Creek
Mahanoy Creek