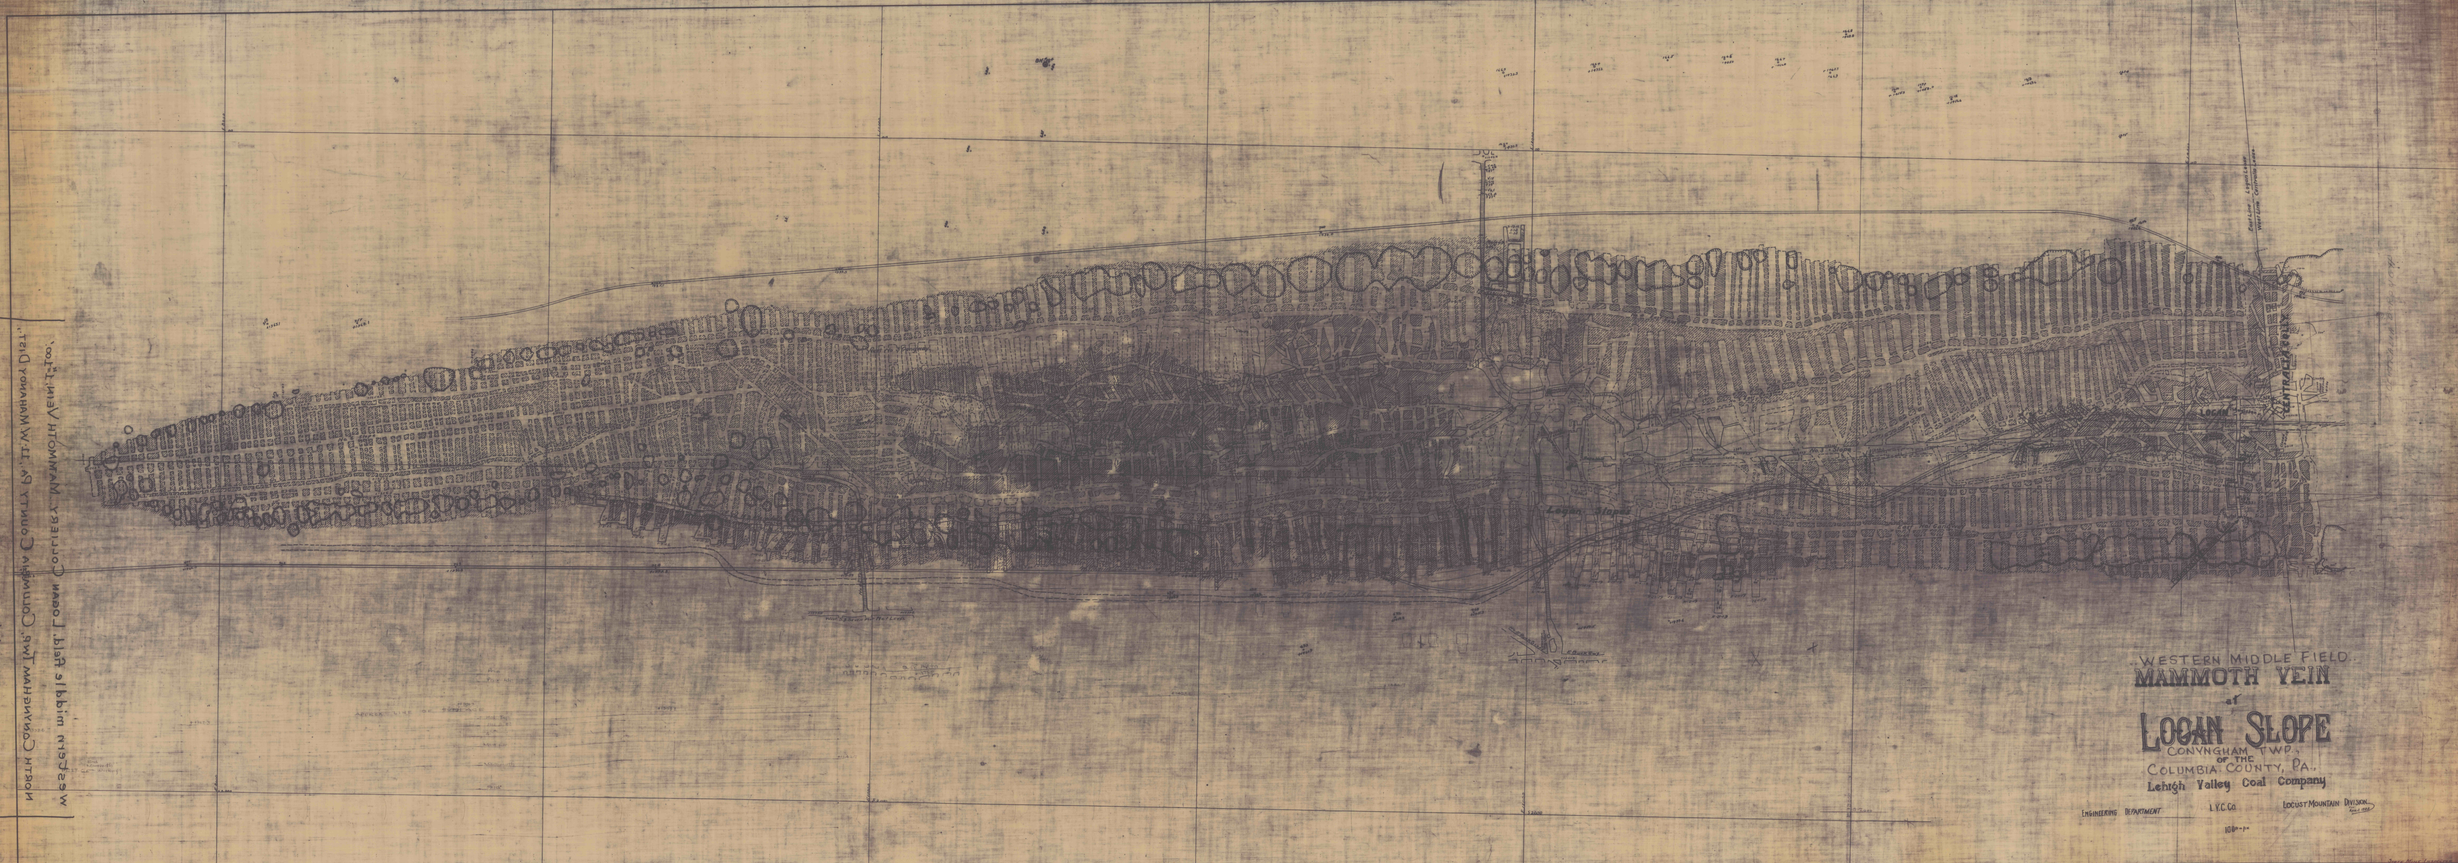
WESTERN MIDDLE FIELD
MAMMOTH VEIN
of
LOGAN SLOPE
CONYNGHAM TWP.
OF THE
COLUMBIA COUNTY, PA.
Lehigh Valley Coal Company
ENGINEERING DEPARTMENT
L.V.C.Co.
LOCUST MOUNTAIN DIVISION
100 ft = 1 in
NORTH
WESTERN MIDDLE FIELD, CONYNGHAM TWP. COLUMBIA COUNTY, PA.
MAMMOTH VEIN, LOGAN SLOPE
LEHIGH VALLEY COAL CO.