


LOCATION MAP
Scale: 1 in. = 9 mi.

▲ Work deleted on channels "O" and "P" per Addendum No. 2.

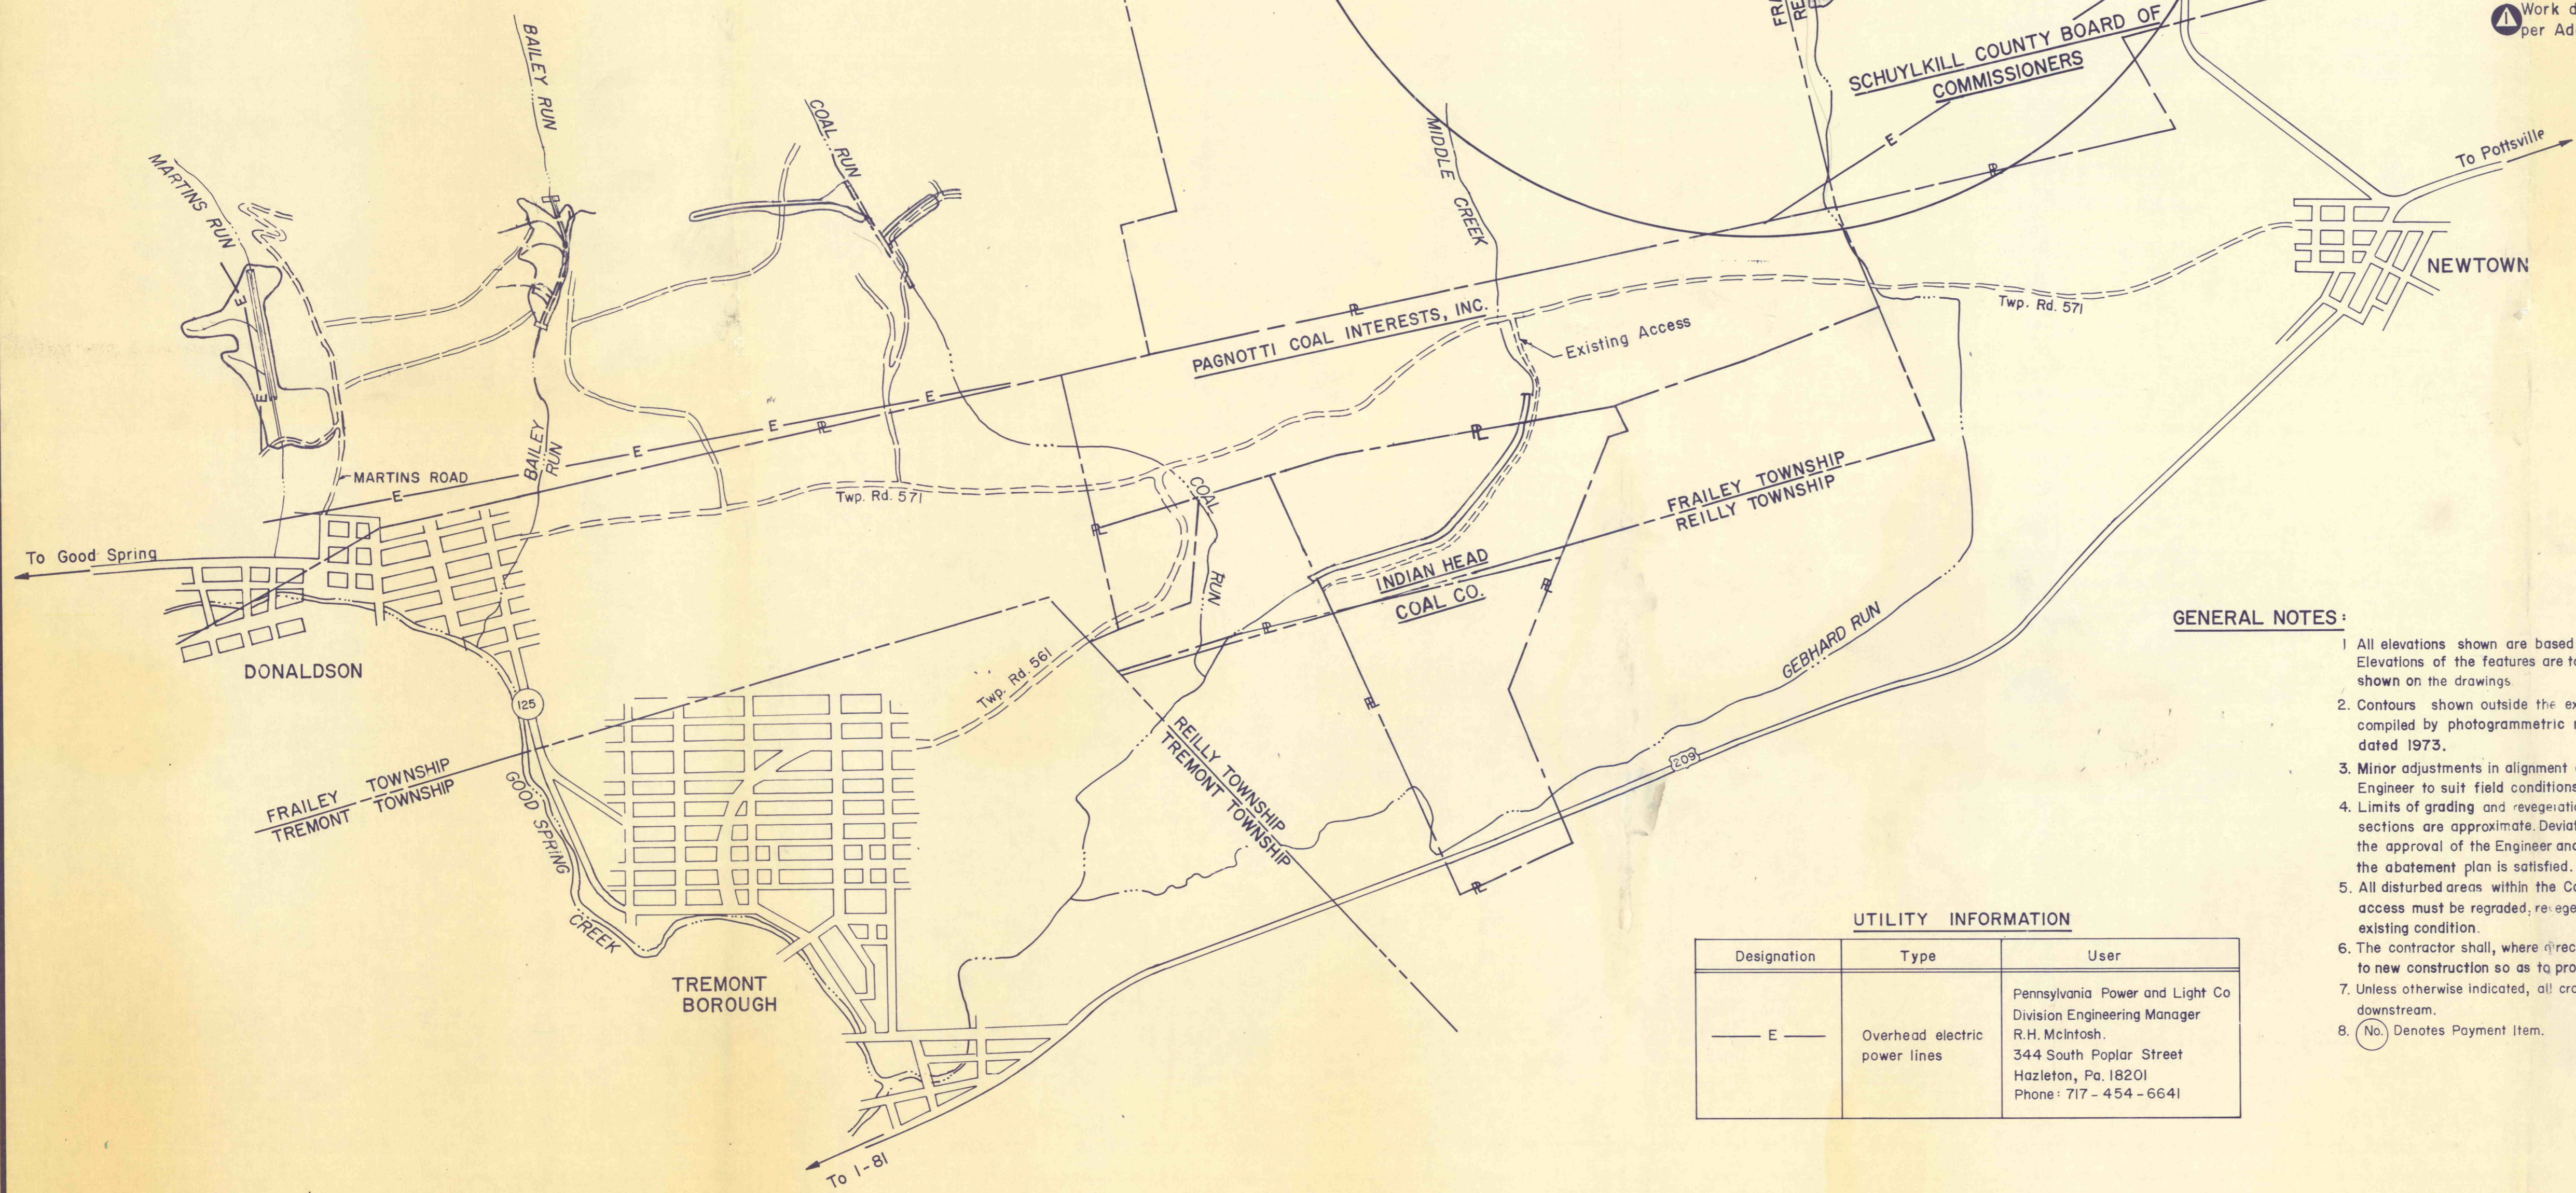

VICINITY MAP
Scale: 1 in. = 800 ft.

GENERAL NOTES:

1. All elevations shown are based on current U.S.G.S Datum. Elevations of the features are to be taken from the Bench Marks shown on the drawings.
2. Contours shown outside the existing grading limits have been compiled by photogrammetric methods from aerial photographs dated 1973.
3. Minor adjustments in alignment and grade may be made by the Engineer to suit field conditions.
4. Limits of grading and revegetation as shown on the plans and cross sections are approximate. Deviations may be permitted subject to the approval of the Engineer and provided that the full intent of the abatement plan is satisfied.
5. All disturbed areas within the Contractors Working Area and access must be regraded, revegetated and restored to at least the existing condition.
6. The contractor shall, where directed, fill and grade areas adjacent to new construction so as to provide positive surface runoff.
7. Unless otherwise indicated, all cross sections are shown looking downstream.
8. (No.) Denotes Payment Item.

UTILITY INFORMATION

Designation	Type	User
— E —	Overhead electric power lines	Pennsylvania Power and Light Co Division Engineering Manager R.H. McIntosh 344 South Poplar Street Hazleton, Pa. 18201 Phone: 717 - 454 - 6641

▲	62078	Work deleted per Addendum No. 2	APPR.
NO.	DATE	REVISION	APPR.
SUBMITTED	B. Rao PROJECT CO-ORDINATOR		
APPROVED	Albert A. Rainey CHIEF - DIVISION OF MINE RECLAMATION		
APPROVED	Robert A. Bailer DIRECTOR - BUREAU OF DESIGN		
COMMONWEALTH OF PENNSYLVANIA DEPARTMENT OF ENVIRONMENTAL RESOURCES OFFICE OF RESOURCES MANAGEMENT			
CONTRACT NO. SL 126 - 2 - 7/9 F MINE DRAINAGE POLLUTION ABATEMENT REMEDIAL WORK SWATARA CREEK WATERSHED FRAILEY AND REILLY TOWNSHIPS, SCHUYLKILL CO., PA.			
LOCATION AND VICINITY MAPS			
DRAWN BY	DATE	DRAWING NO.	
B. Rao	25 May 78	2 of 7	
CHECKED BY	SCALE		
668	As shown		