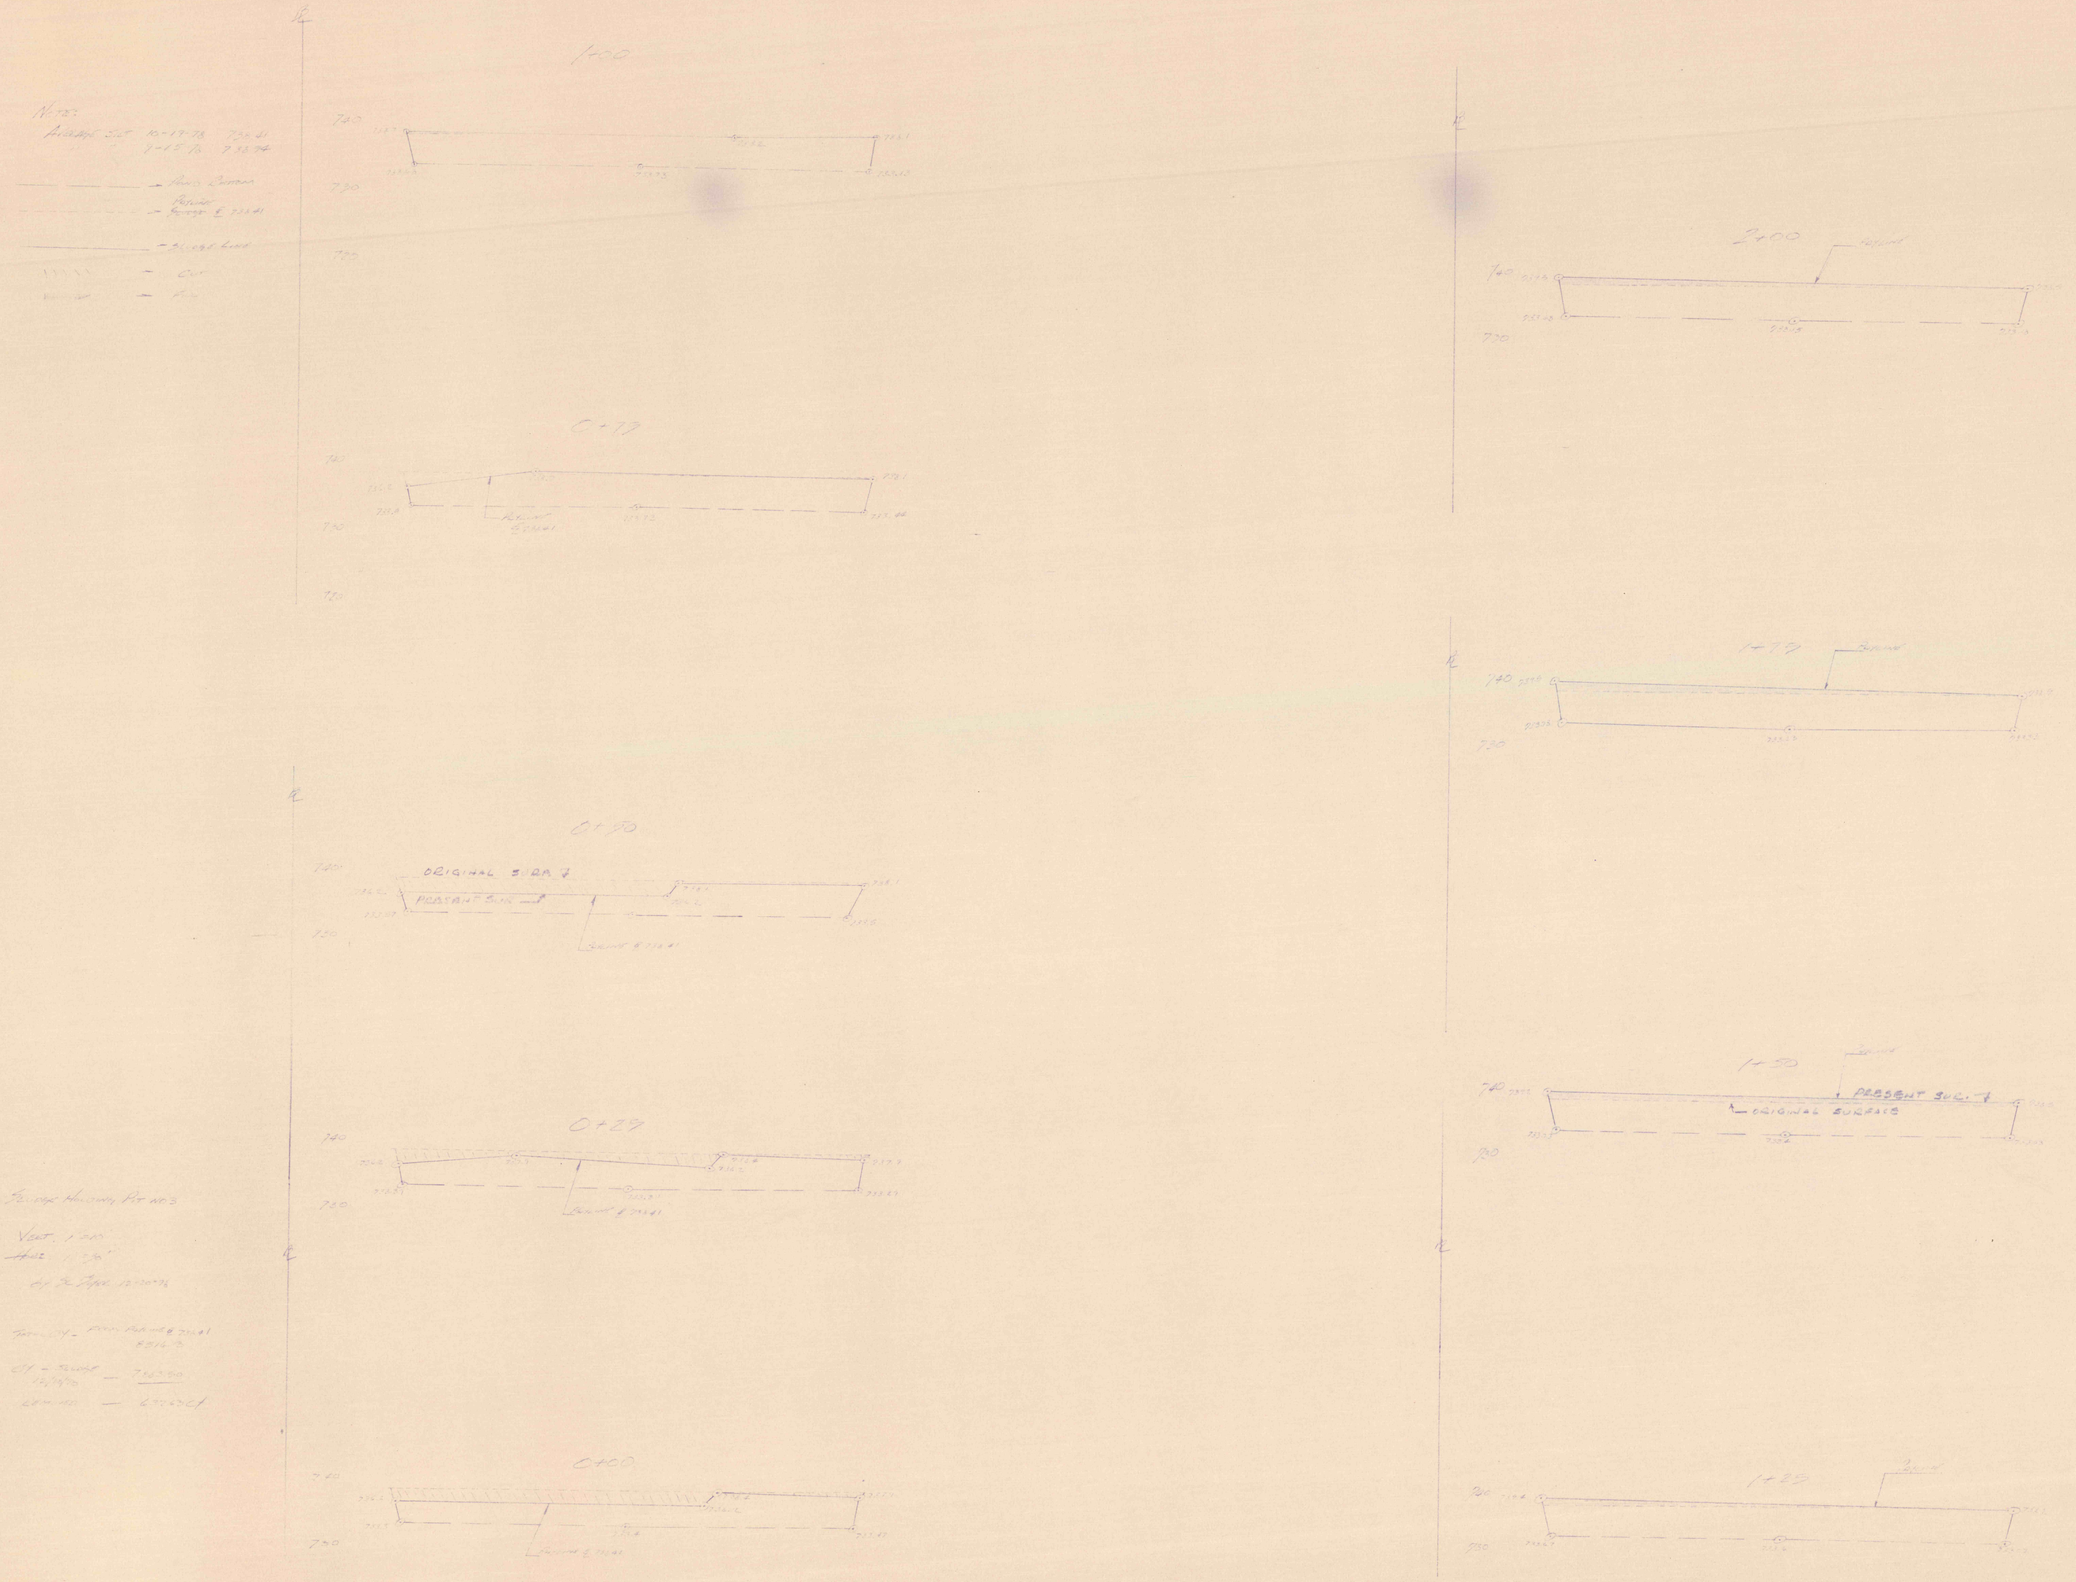

Sludge Holding Pit No 3

Vert. 1"=10'

Horz. 1"=30'

by [illegible] 12-20-78

Total CY - Pond Bottom @ 738.41 = 8516.13

CY - Sludge 12/19/78 — 7363.50

Remained — 632.63 CY