

*5268A
Bush Co
Borshole*


A.M.S. V831
Type F (AMS 1), 1947.

Prepared under the direction of the Chief of Engineers by the Army Map Service (AM), War Department, Washington, D. C. Redrawn in 1947 from Pennsylvania, 1:62,500, C.E. Lykens, 1943. Planimetric detail revised from aerial photography by photo planimetric methods. Aerial photography by Army Map Service, 1946. Planimetry field edited, 1947. Horizontal and vertical control by USGS and USC&GS.

LEGEND

Tint indicates built up areas in which only landmark buildings are shown

Hard surface, heavy duty road, more than two lanes wide	Loose surface, graded and drained, or narrow hard surface road
Hard surface, heavy duty road, two lanes wide; Federal route marker	Improved dirt road
Hard surface, medium duty road, more than two lanes wide	Unimproved dirt road
Hard surface, medium duty road, two lanes wide; State route marker	Trail
RAILROADS	Horizontal control point
Standard gauge	Bench mark, monumented
Narrow gauge	Bench mark, non-monumented
Railroad in street	Spot elevation in feet

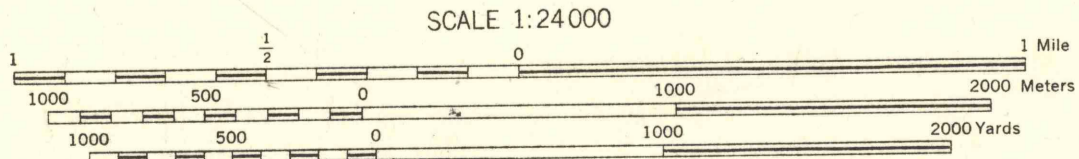

CONTOUR INTERVAL 20 FEET
DATUM IS MEAN SEA LEVEL
TRANSVERSE MERCATOR PROJECTION
1927 NORTH AMERICAN DATUM

INDEX TO BOUNDARIES

INDEX TO ADJOINING SHEETS

TOWER CITY, PENNSYLVANIA

1.4 MI. TO PENN. 72
INDIANTOWN GAP L.S. MI.

ARMY MAP SERVICE CORPS OF ENGINEERS WAR DEPARTMENT 600417
1947

A. Schuylkill County
1. Hallow Township
2. Hayes Township
3. Porter Township
4. Tower City Borough (incorporated)
5. Trumbull Township
6. Pine Grove Township
B. Dauphin County

Sheet 5665 II SE falls within NK 18-10
AMS V831 1:24,000