


# MAP OF SCHUYLKILL COUNTY

SCALE 0 1 2 3 MILES

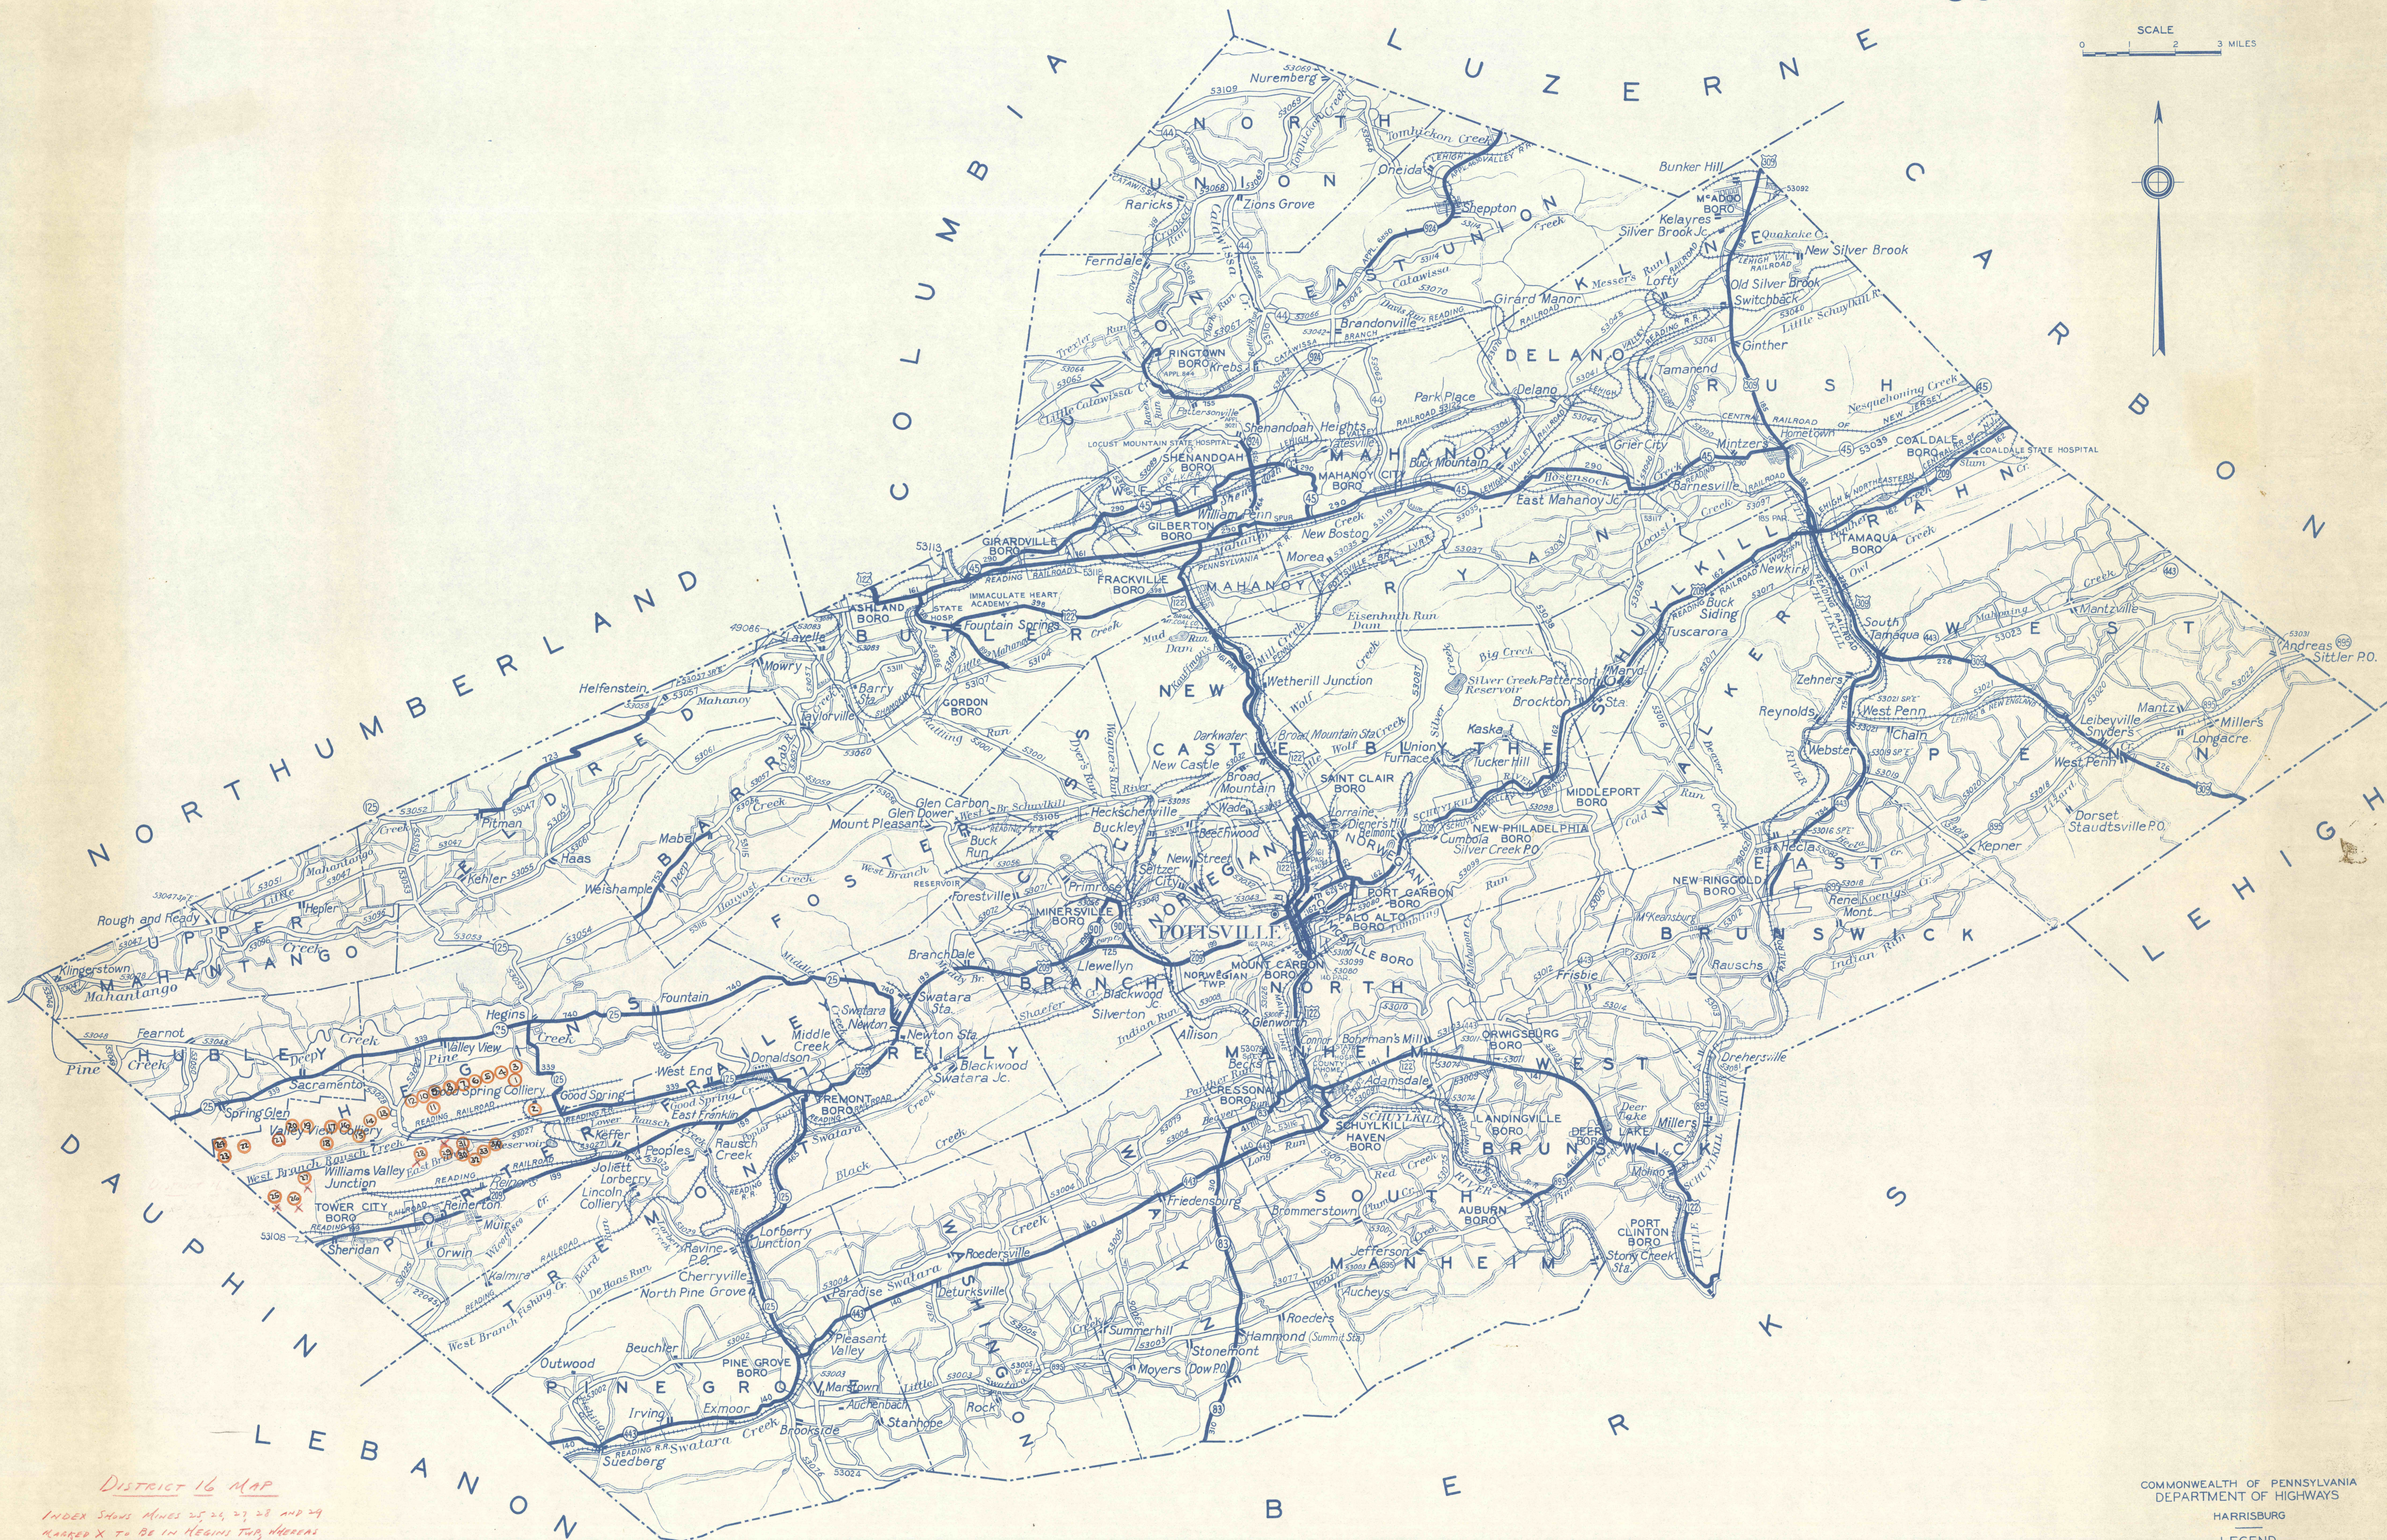

*District 16 Map*  
 ON THIS MAP THEY ARE LOCATED IN PORTAL TOP

- COMMONWEALTH OF PENNSYLVANIA  
 DEPARTMENT OF HIGHWAYS  
 HARRISBURG
- LEGEND
- STATE HIGHWAYS - OLD SYSTEM
  - STATE HIGHWAYS RURAL ROUTE SYSTEM
  - TOWNSHIP ROADS
  - U.S. AND STATE HIGHWAY TRAFFIC ROUTE NUMBERS
  - STATE HIGHWAY LEGISLATIVE ROUTE NUMBERS

REVISED  
 APRIL 1958