7400 Drag (short boom) off job
May 22, 1973

May 1-31, 1973

Mt. Carmel Estimate

May 1-15 in blue
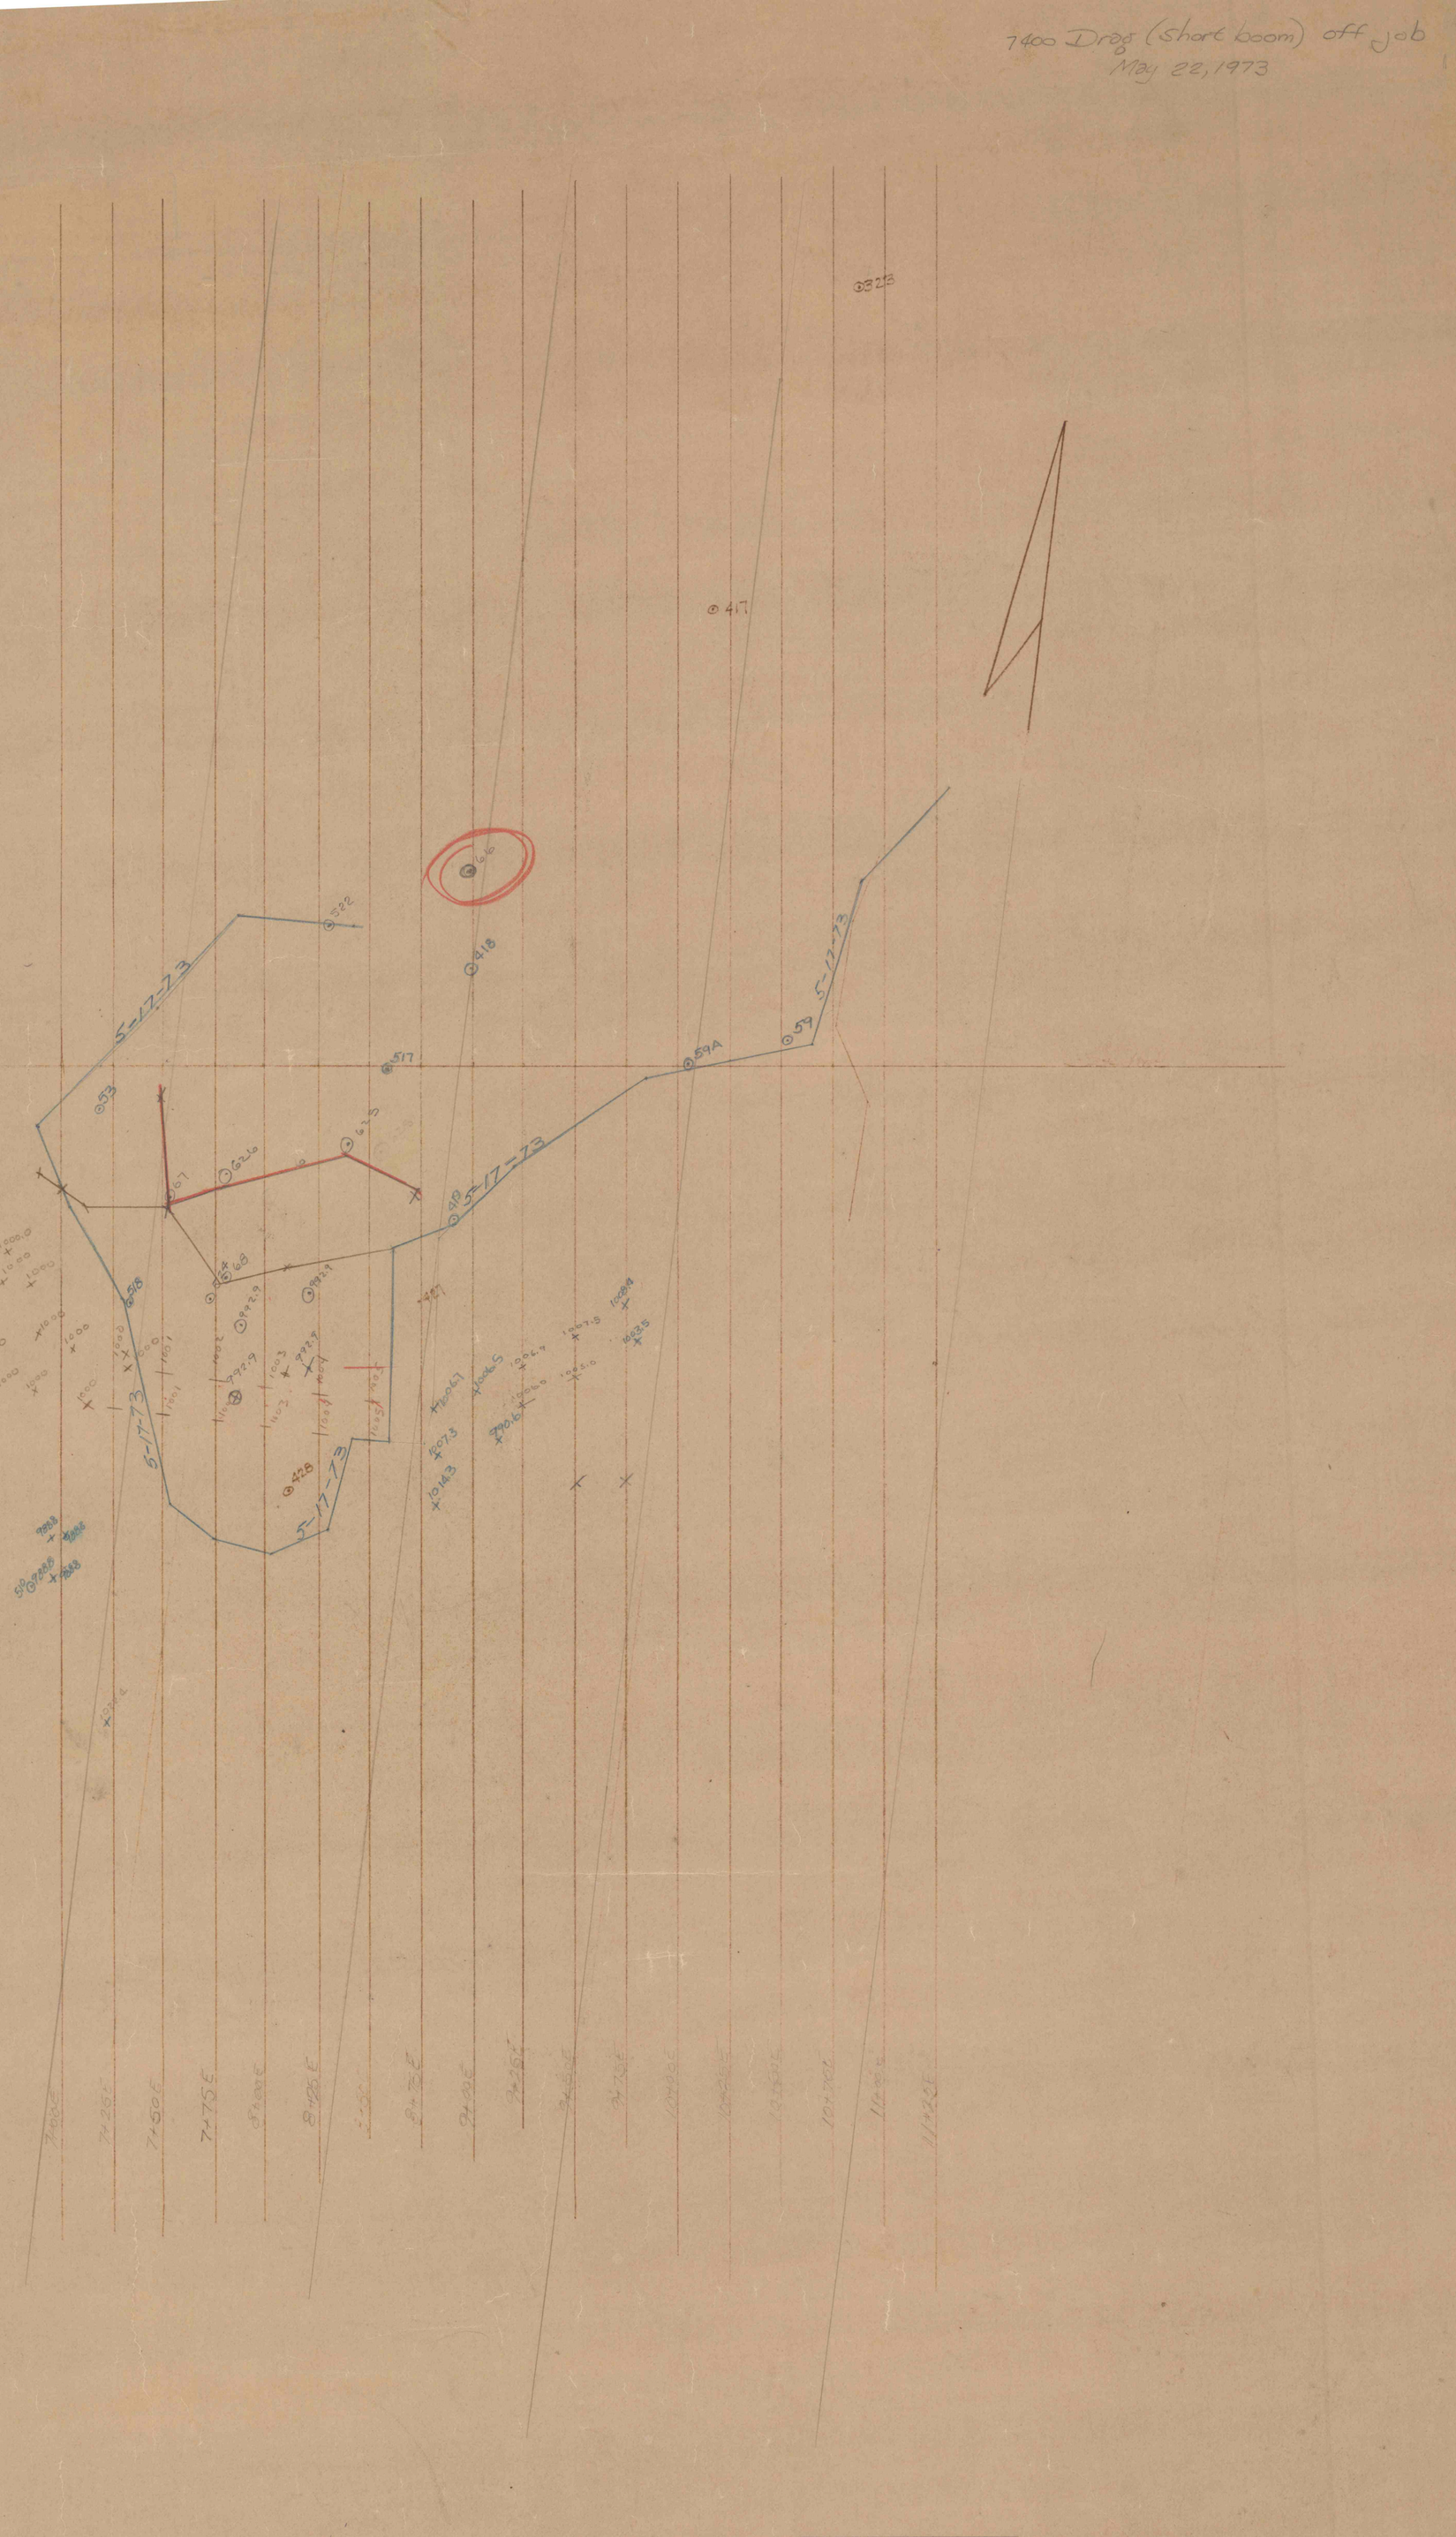
May 15-31 in brown