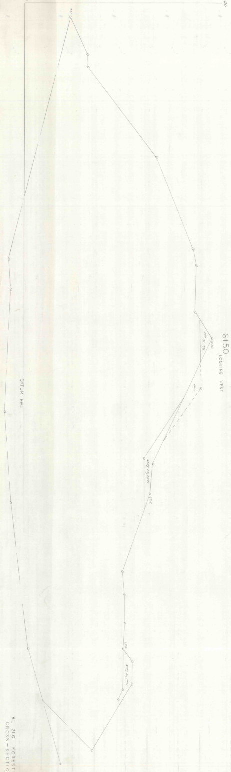
0+20
6+50
LOOKING WEST
DATUM 860

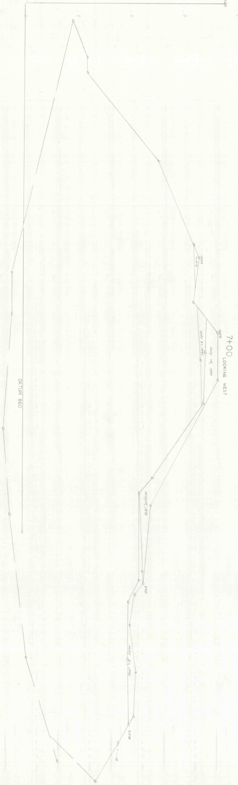
0+40
7+00
LOOKING WEST
DATUM 860

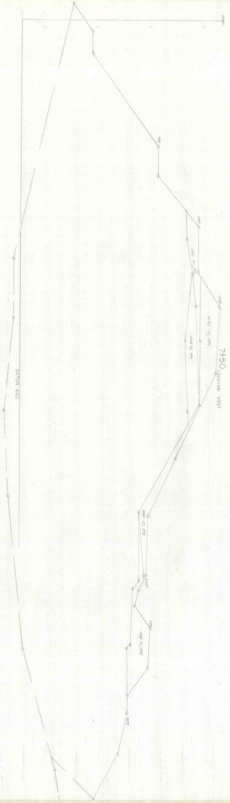
0+40
7+50
LOOKING WEST
DATUM 860

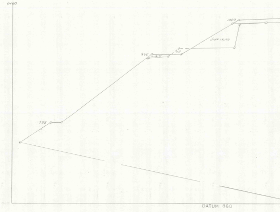
0+60
993
1027
DATUM 860

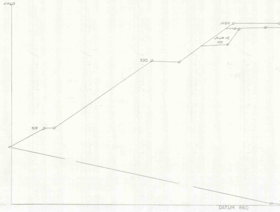
0+60
928
930
1024
June 15, 1991
DATUM 860

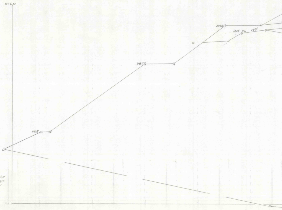
0+60
983
987
1020
MAR 26 1991

SL 210 FORESTVILLE
CROSS-SECTIONS
SCALE 1" = 20'

SL 210 FORESTVILLE
CROSS-SECTIONS

9+00 LOOKING WEST

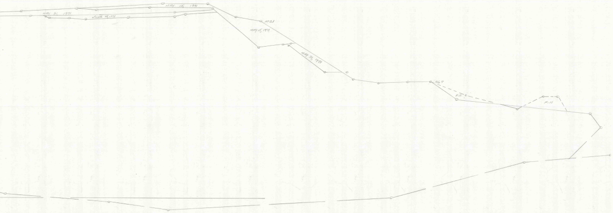
MAY 15, 1971
MAY 31, 1971
JUNE 18, 1971
1021
MAY 15, 1971
MAY 31, 1971
967
FILL
FILL

10+50 LOOKING WEST

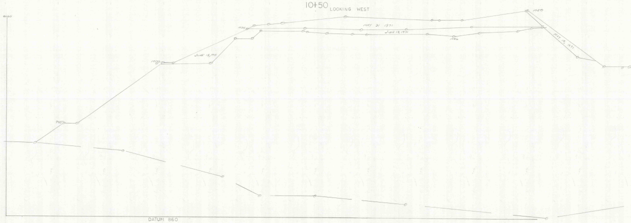
0+60
1050
MAY 31 1971
JUNE 18, 1971
1026
MAY 15, 1971
1024
JUNE 18, 1971
1000
945
DATUM 860

8+50 LOOKING WEST

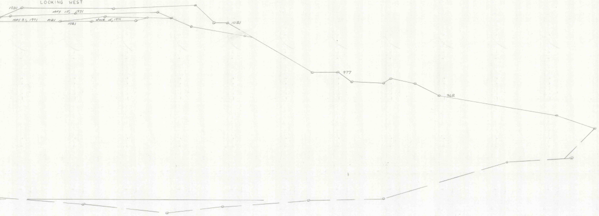
1031
MAY 15, 1971
MAY 31, 1971
1021
1021
JUNE 15, 1971
1021
977
962

10+00 LOOKING WEST

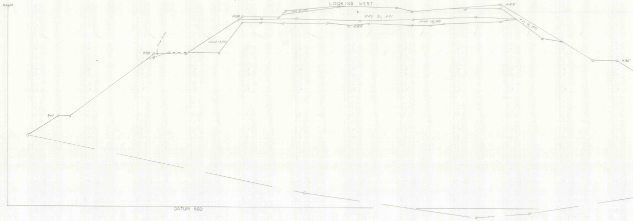
0+60
1044
MAY 15, 1971
MAY 31, 1971
JUNE 18, 1971
1032
1024
MAY 15, 1971
JUNE 18, 1971
998
941
995
DATUM 860

8+00 LOOKING WEST

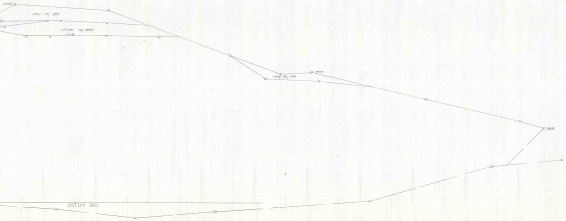
1040
MAY 15, 1971
JUNE 18, 1971
1012
MAY 31, 1971
979
988
DATUM 860

9+50 LOOKING WEST

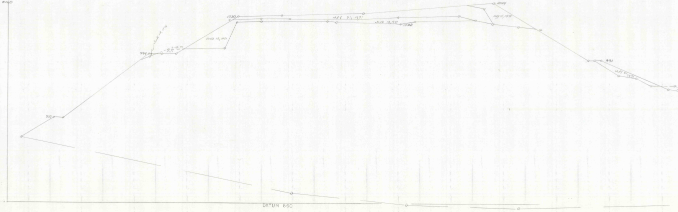
0+60
1044
MAY 15, 1971
1030
MAY 31, 1971
JUNE 18, 1971
1022
JUNE 18, 1971
994
FILL
937
991
MAY 31 1971
DATUM 860

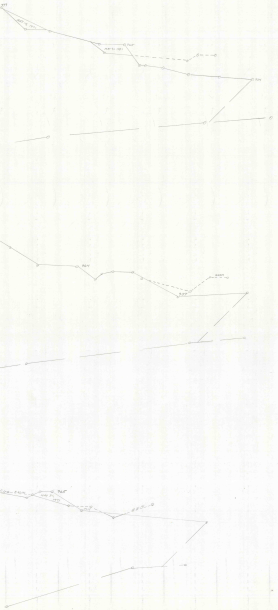
999
MAY 15, 1971
MAY 31 1971
965
934
964
937
BERM
6-21-71
965
MAY 31,
1971
Fill
5-31-71

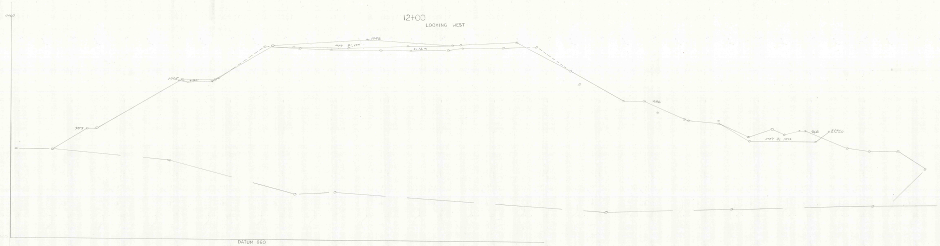
12+00
LOOKING WEST
1060
959
1005
6-18-71
1042
MAY 31, 1971
6-18-71
986
968
MAY 31, 1970
BERM
860
DATUM 860

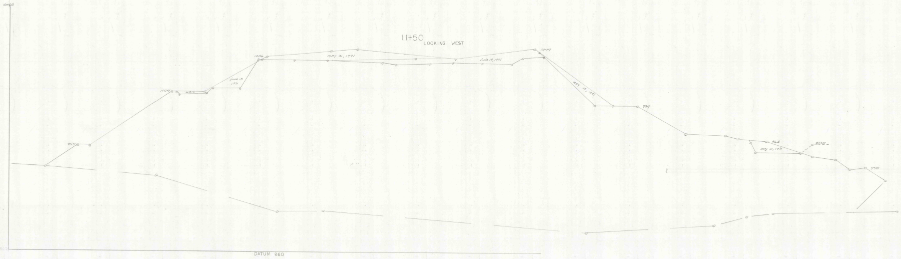
11+50
LOOKING WEST
1060
955
1004
6-18-71
June 18
1971
1036
MAY 31, 1971
June 18, 1971
1044
MAY 15, 1971
994
963
MAY 31, 1971
BERM
940
860
DATUM 860

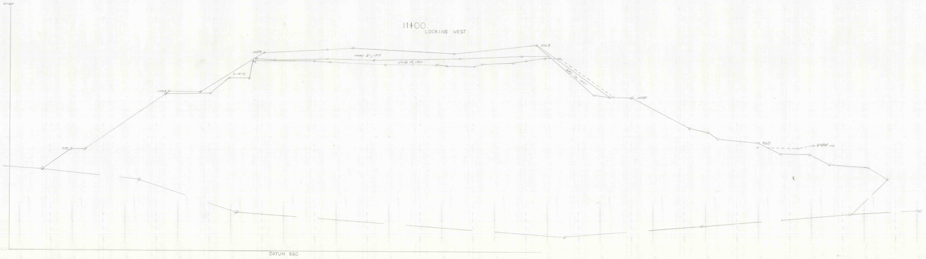
11+00
LOOKING WEST
1060
970
1003
6-18-71
1059
MAY 31, 1971
June 18, 1971
1069
MAY 15, 1971
1000
960
BERM
860
DATUM 860

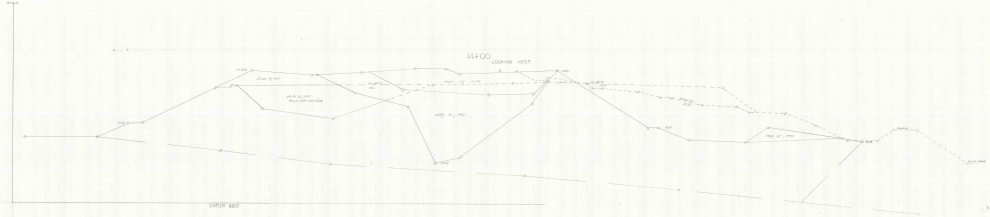
14+00 LOOKING WEST
1020
June 18, 1971
972
6-18-71 Fill
MAY 15 1971
June 21, 1971 Paid in First Half June
MAY 31, 1971
937
1021
6-18-71 Fill
5-21-71 Fill
970
MAY 31, 1971
958
BERM
SILT DAM
DATUM 900

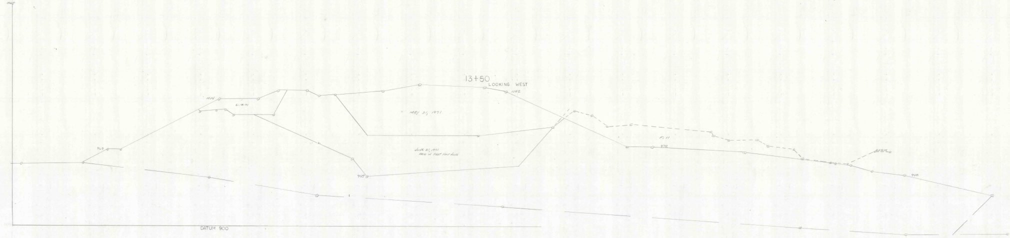
13+50 LOOKING WEST
1014
6-18-71
969
MAY 31, 1971
1082
June 21, 1971 Paid in First Half June
945
Fill
978
BERM
948
DATUM 900

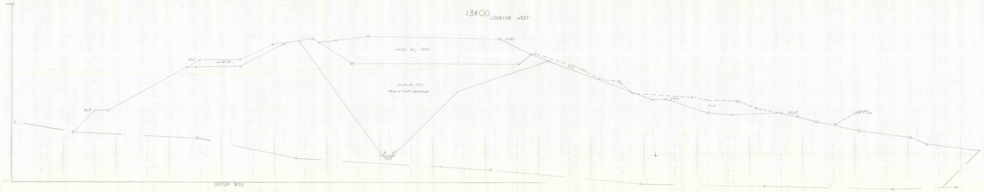
13+00 LOOKING WEST
1011
6-18-71
965
MAY 21, 1971
1031
June 21, 1971 Paid in First Half June
925
Fill
977
Fill
965
BERM
DATUM 900

14+50 LOOKING WEST

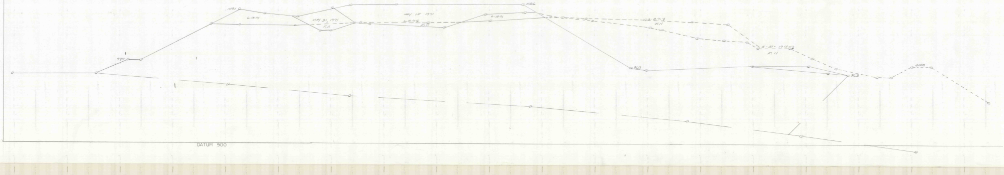
975
1021
6-18-71
MAY 31, 1971
Fill
MAY 15 1971
6-18-71
Fill
6-18-71
1086
6-8-71
Fill
969
5-31-1971
Fill
963
BERM
DATUM 900