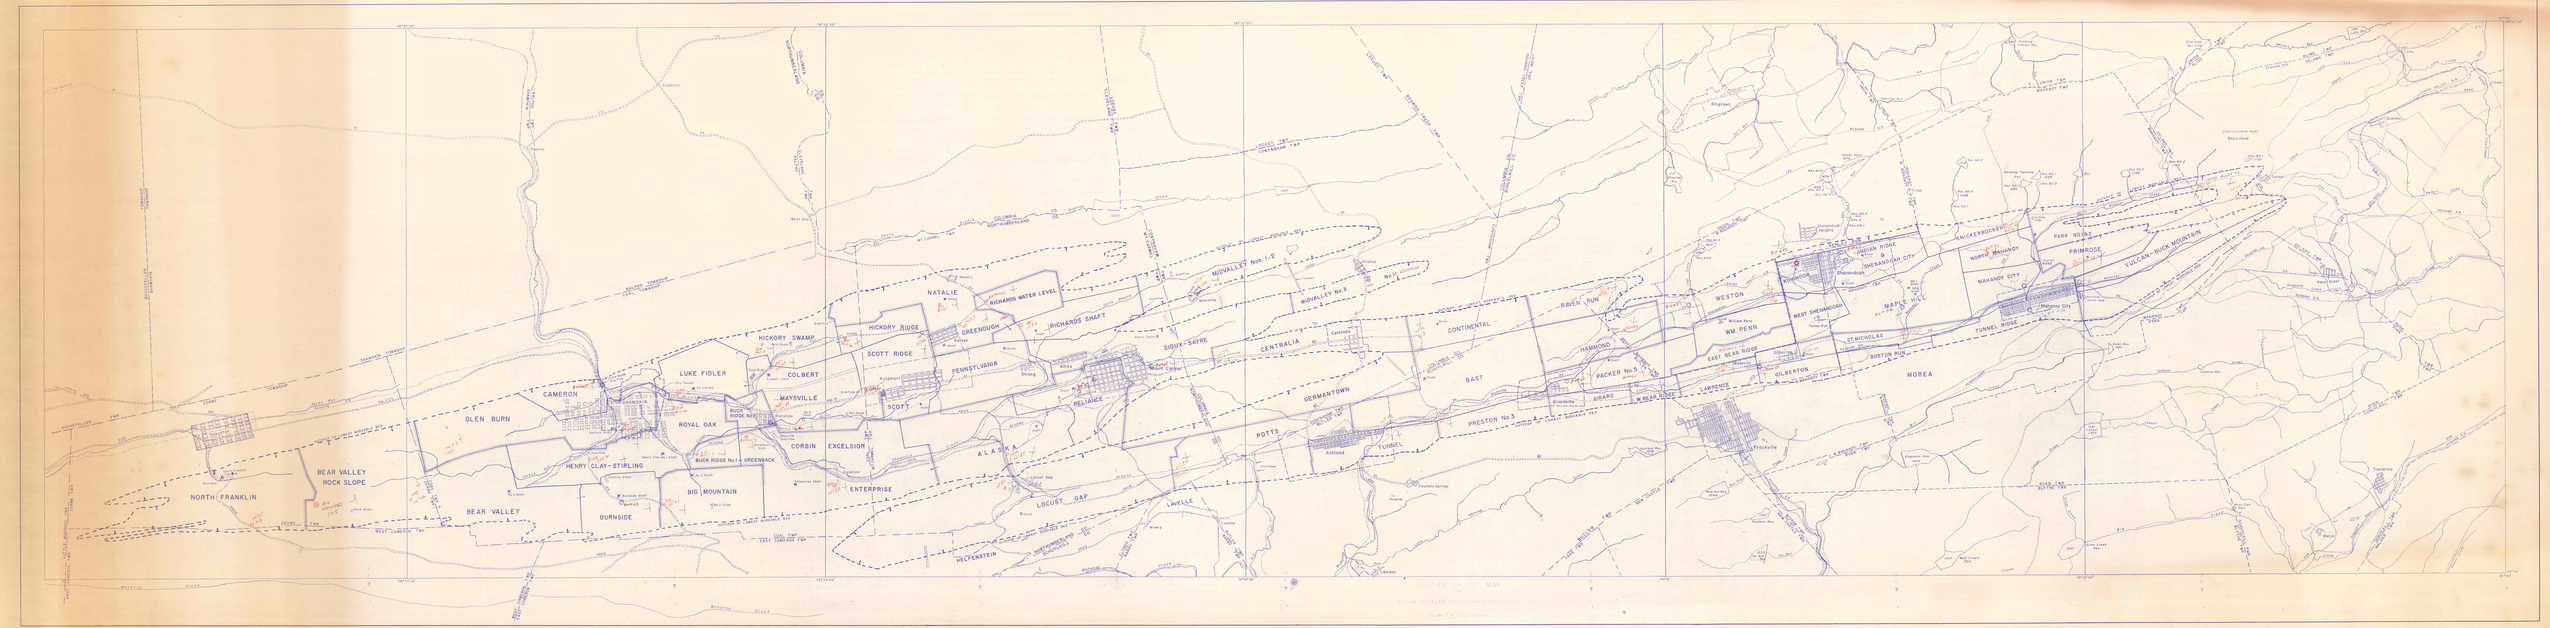
NORTH FRANKLIN
BEAR VALLEY ROCK SLOPE
BEAR VALLEY
GLEN BURN
CAMERON
HENRY CLAY-STIRLING
BURNSIDE
LUKE FIDLER
ROYAL OAK
BIG MOUNTAIN
HICKORY SWAMP
COLBERT
MAYSVILLE
BUCK RIDGE No.1
BUCK RIDGE No.1-GREENBACK
CORBIN
EXCELSIOR
ENTERPRISE
HICKORY RIDGE
SCOTT RIDGE
SCOTT
GREENOUGH
NATALIE
RICHARDS WATER LEVEL
PENNSYLVANIA
RELIANCE
RICHARDS SHAFT
ALASKA
LOCUST GAP
HELFENSTEIN
LAVELLE
MIDVALLEY Nos.1-2
MIDVALLEY No.3
SIOUX-SAYRE
CENTRALIA
GERMANTOWN
POTTS
TUNNEL
CONTINENTAL
BAST
PRESTON No.3
RAVEN RUN
HAMMOND
PACKER No.5
SIGARD
W. BEAR RIDGE
LAWRENCE
WESTON
WM. PENN
EAST BEAR RIDGE
GILBERTON
CROSS CREEK
INDIAN RIDGE
DOE & SHENANDOAH CITY
WEST SHENANDOAH
MAPLE HILL
ST. NICHOLAS
BOSTON RUN
MOREA
KNICKERBOCKER
NORTH MAHANOY
MAHANOY CITY
PARK No.2
PRIMROSE
TUNNEL RIDGE
VULCAN-BUCK MOUNTAIN