



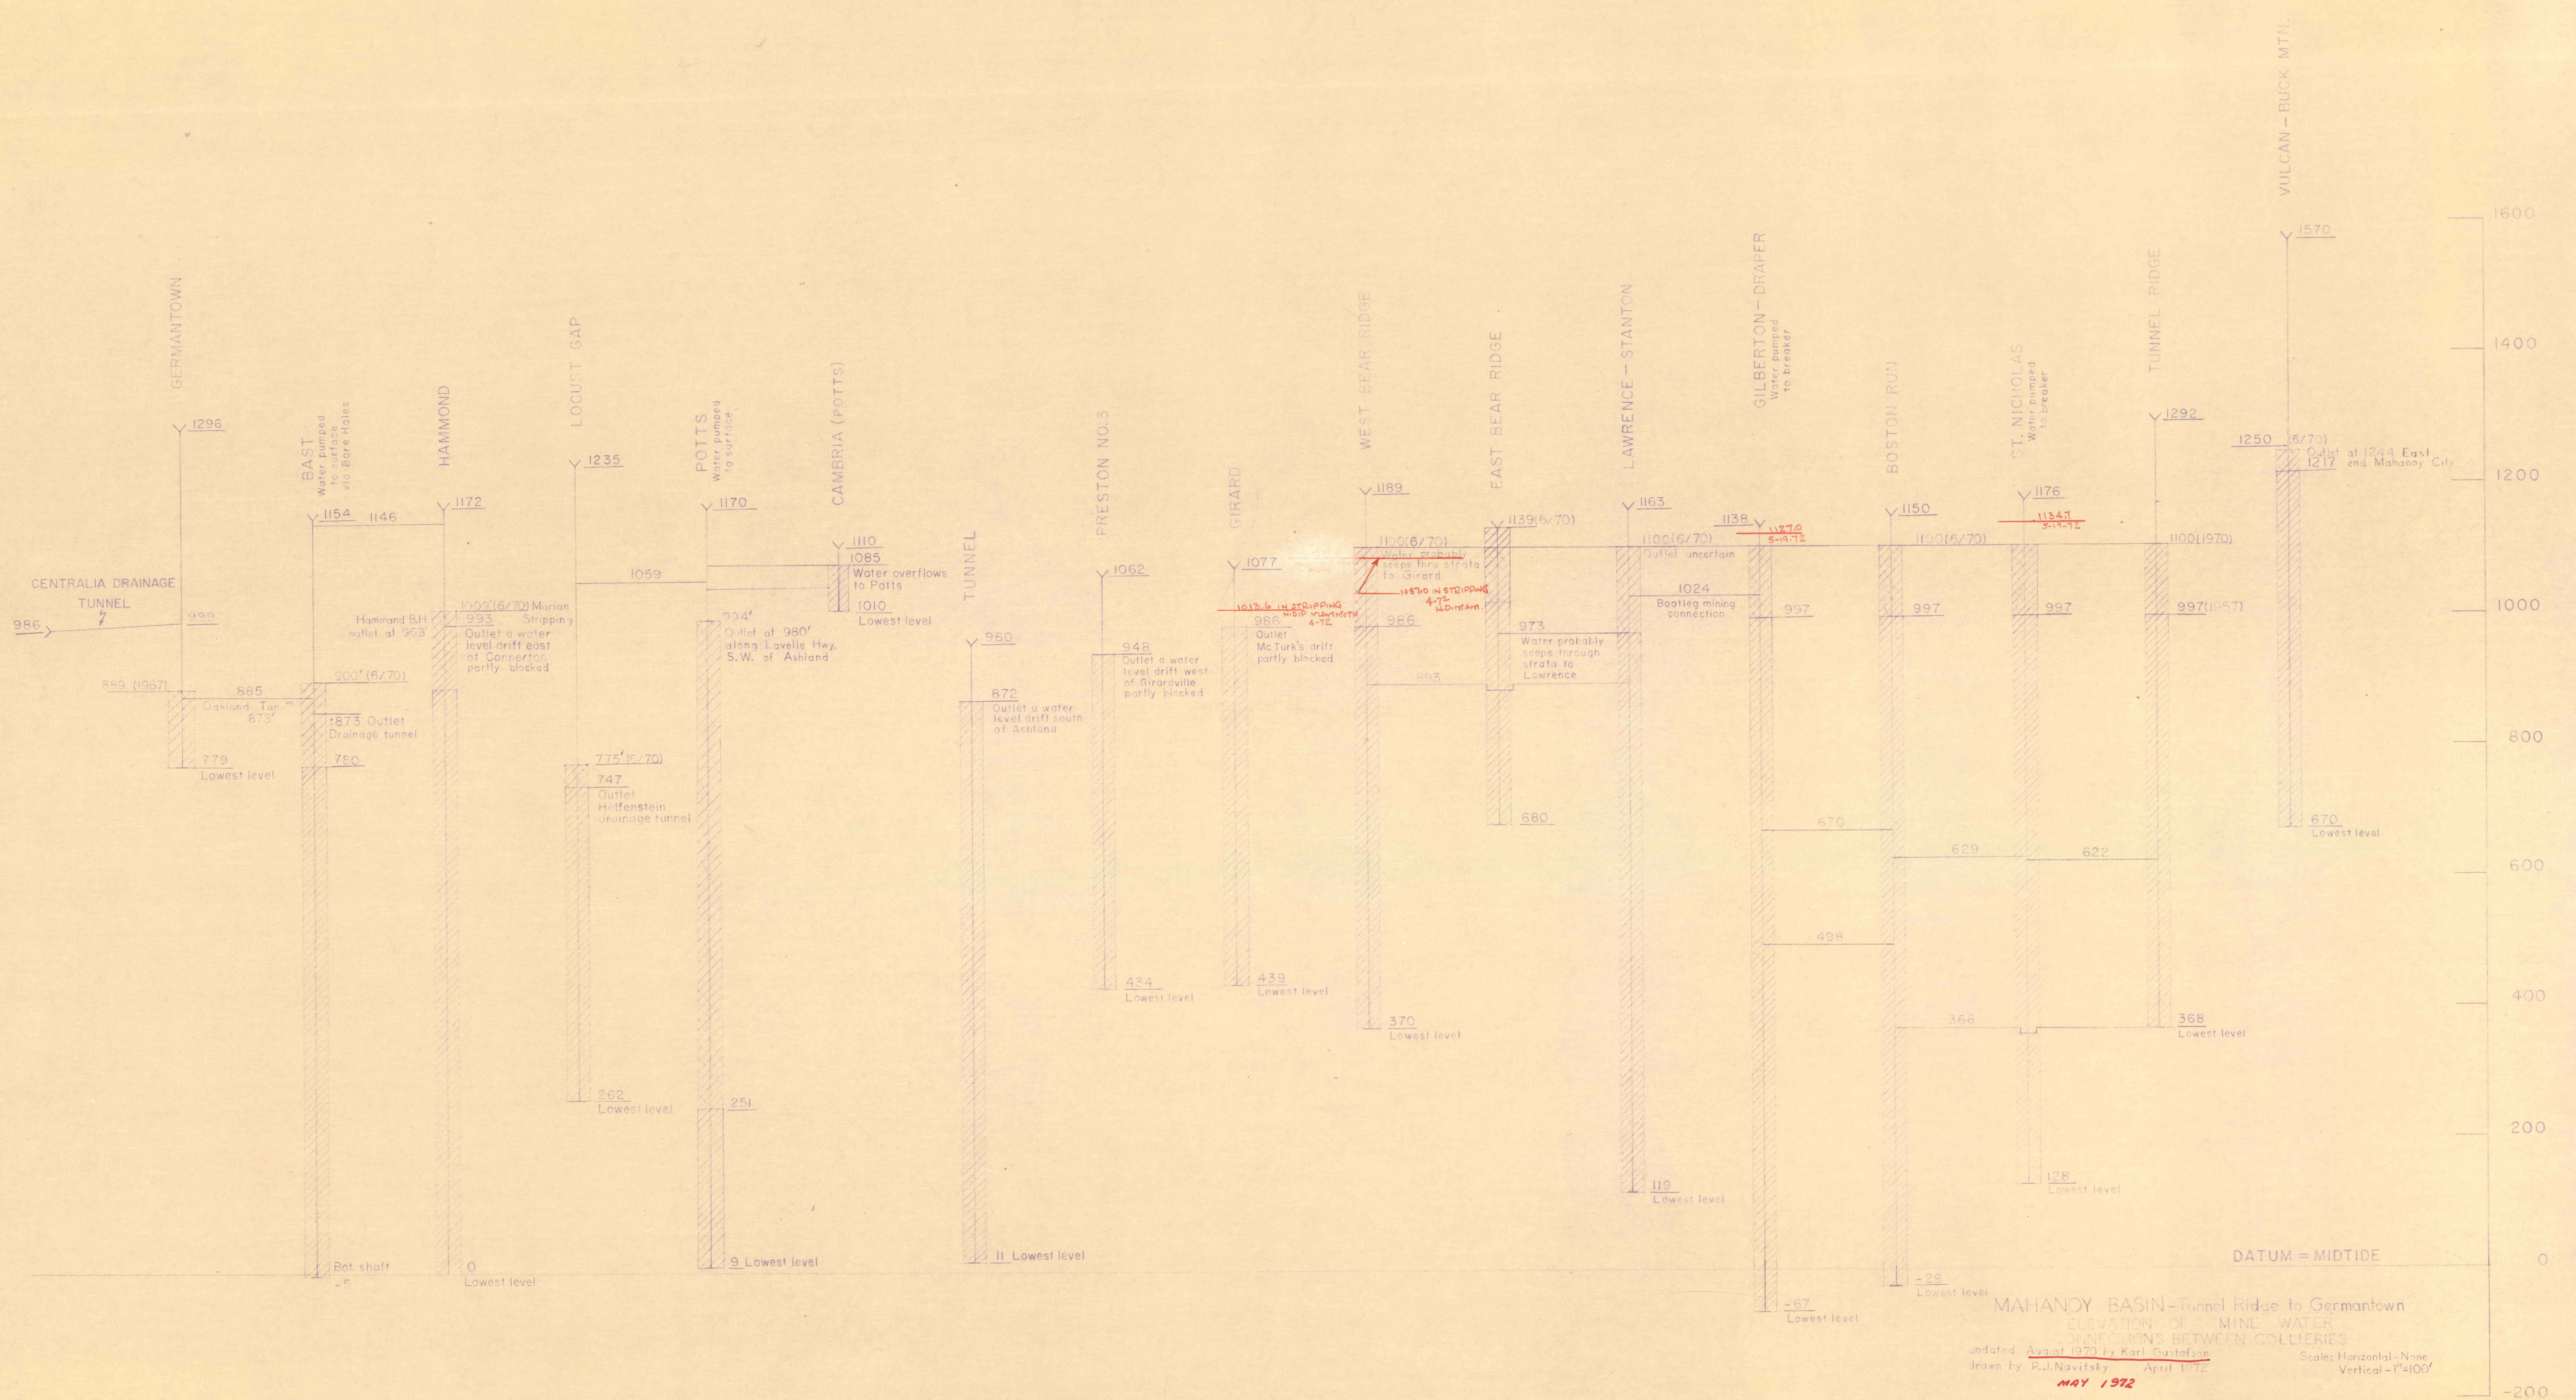

MAHANOY BASIN - Tunnel Ridge to Germantown  
 ELEVATION OF MINE WATER  
 CONNECTIONS BETWEEN COLLIERIES  
 updated August 1970 by Karl Gustafson  
 drawn by R.J. Navitsky April 1972  
 Scale: Horizontal - None  
 Vertical - 1"=100'

MAY 1972

