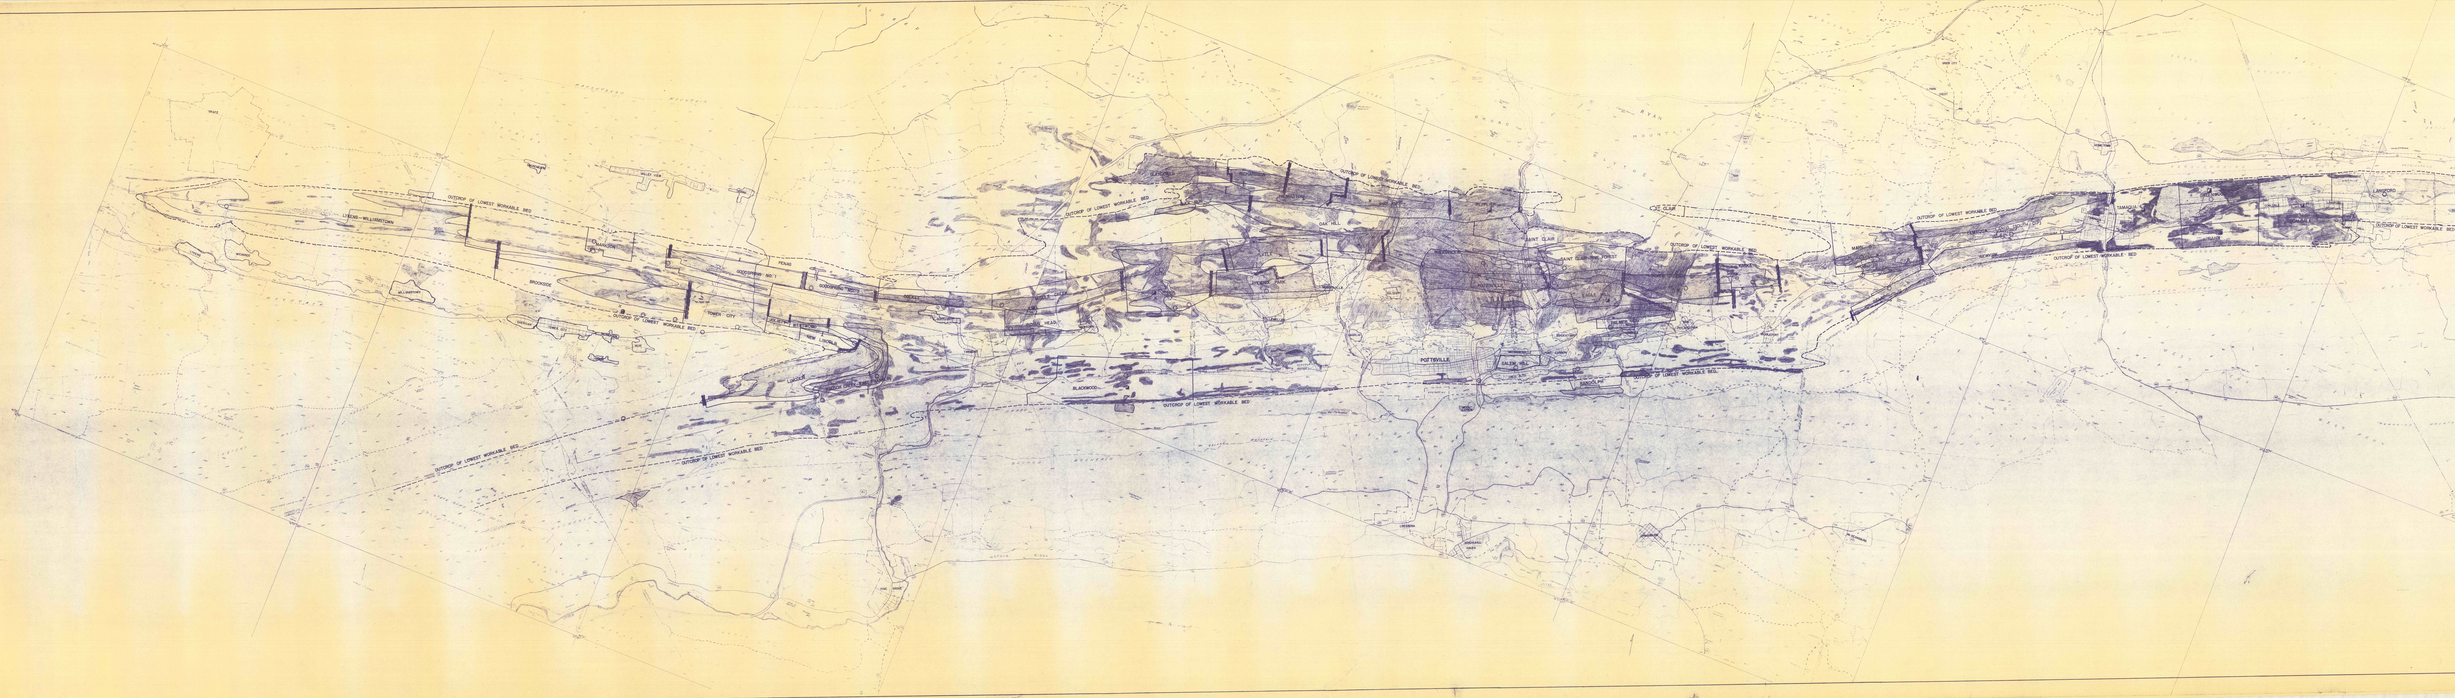
OUTCROP OF LOWEST WORKABLE BED
TOWER CITY
