RECORD OF SECTION IN No 2 SHAFT

Scale 20'-1"

LOOKING WEST

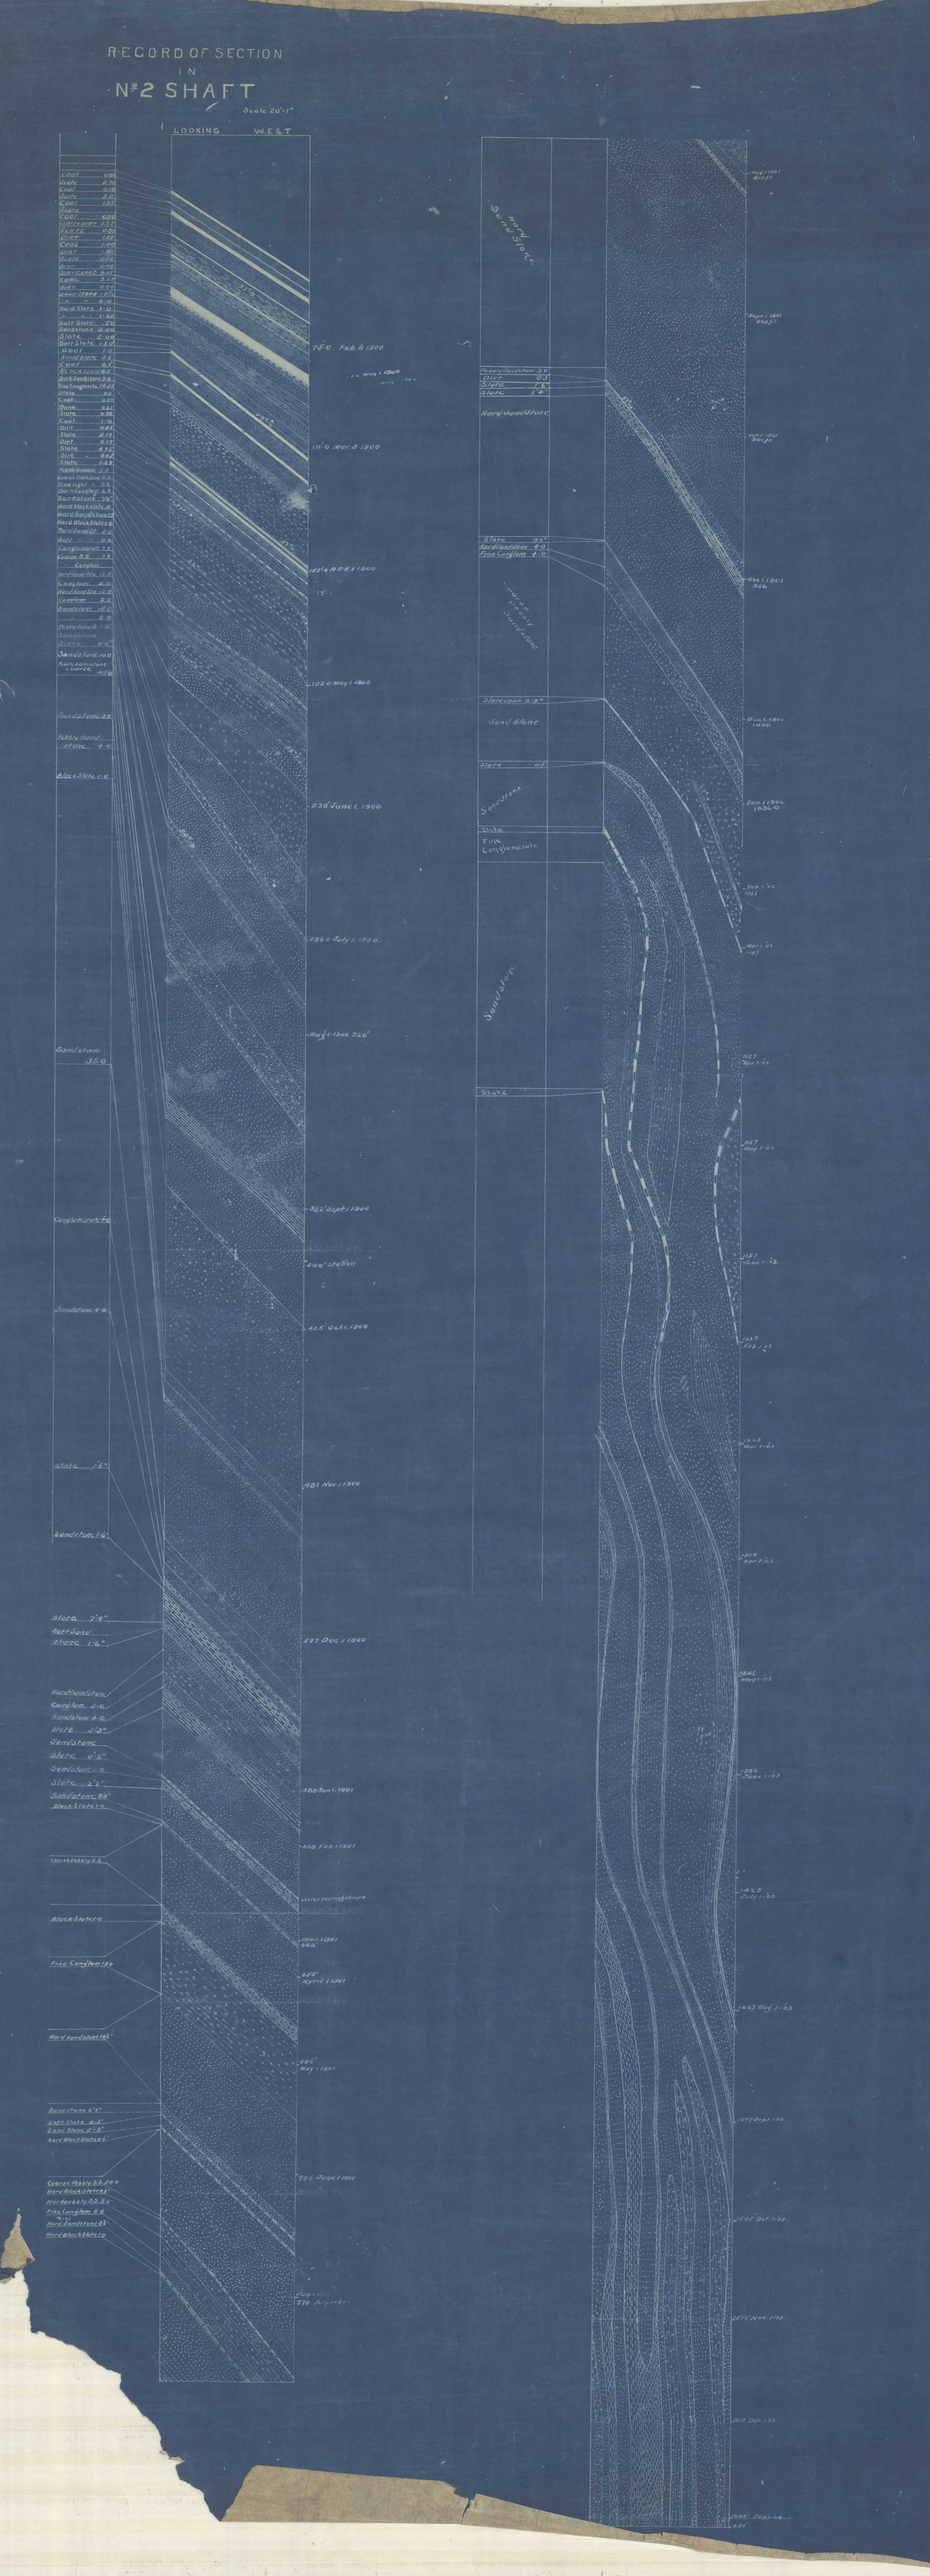
Coal 0.8
Shale 6.10
Coal 0.6
Shale 2.2
Coal 1.2
Shale
Coal 6.2
Fireclay 1.10
Coal 0.8
Shale 1.6
Coal 1.0
Shale 0.8
Sandstone 6.0
Coal 3.2
Shale 0.6
Sandstone 2.0
Coal 0.7
Shale 1.6
Hard Slate 1.0
Shale 1.6
Soft Slate 0.8
Sandstone 8.06
Slate 2.04
Soft Slate 1.6
Coal 1.0
Fireclay 2.6
Coal 0.7
Fireclay 9.6
Dark Sandstone 2.0
Fine Conglom. 6.8
Slate 0.2
Coal 0.2
Stone 2.2
Slate 4.10
Coal 1.9
Dirt 0.6
Slate 4.11
Dirt 4.11
Slate 4.12
Dirk 4.6
Slate 4.2
Fine Conglom. 2.3
Coarse Conglom. 2.3
Fine Light 0.6
Dark Conglom. 6.8
Sandstone 19.0
Hard black slate 4.
Hard Sandstone 2
Hard Black Slate 9
Blackband 2.6
Slate 0.6
Conglomerate 1.6
Coarse 2.6
Conglom
Hard Slate 12.8
Slate Slate 4.6
Hard Sandstone 12.0
Conglom. 3.2
Sandstone 18.6
2.0
Hard Sandstone 2.0
Sandstone
Slate 8.6
Sandstone
Hard Sandstone
Slate 8.0
Sandstone 35.0
Hard Sandstone 9.6
Black Slate 1.0
Sandstone 3.0
Conglomerate 6.6
Sandstone 4.0
Slate 1.6"
Sandstone 6.6
Slate 7'6"
Soft Slate
Stone 1'6"
Hard Sandstone
Conglom. 3'6"
Sandstone 4'0
Slate 2'3"
Sandstone
Slate 0'2"
Sandstone 1'0
Slate 4'2"
Sandstone 0'8"
Black Slate 1'0
Coarse Pebbly 2.3
Fine Conglom 12.6
Black Slate
Fine Conglom 12.6
Hard Sandstone 12.6
Sandstone 18.0
Hard Sandstone 2.6
Sandstone
Coarse Pebbly 28.0
Hard Black Shales
Pebbly 33.3.6
Fine Conglom 2.6
Hard Sandstone 3.3
Hard black shales
75'0 Feb. 6 1900
111'0 March 1900
123'6 April 1900
1123'0 May 1 1900
238' June 1, 1900.
288'0 July 1, 1900.
Rock 1300 328'
362' Sept 1900
400' Station
425' Oct. 1, 1900
481' Nov. 1 1900
537 Dec. 1 1900
780 Jan. 1 1901
808 Feb 1 1901
Water Bearing Strata
Water 1901
466'
April 1 1901
646'
May 1 1901
726' June 1 1901
776 July 1901
Sand Stone
Hard Slate
Hard Sandstone 3.0
Slate 0.6
Sandstone 1.0
Slate 0.2
