

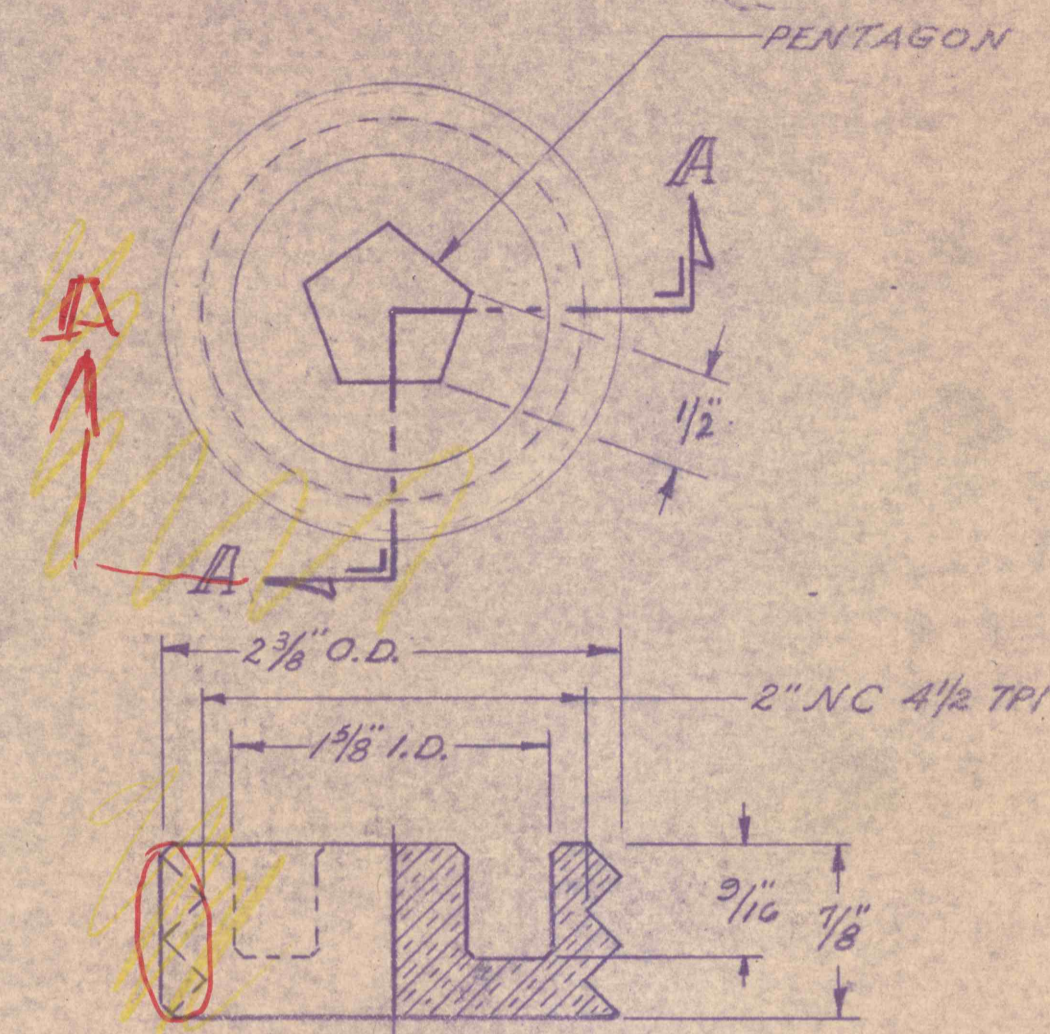


NOTES:
1. PROVIDE 3 PENTAGON KEYS 4" LONG & 3 KEYS 18" LONG ✓
2. ALL BRAZING & WELDING TO BE AIRTIGHT ✓



SCALE:
DETAIL - 1

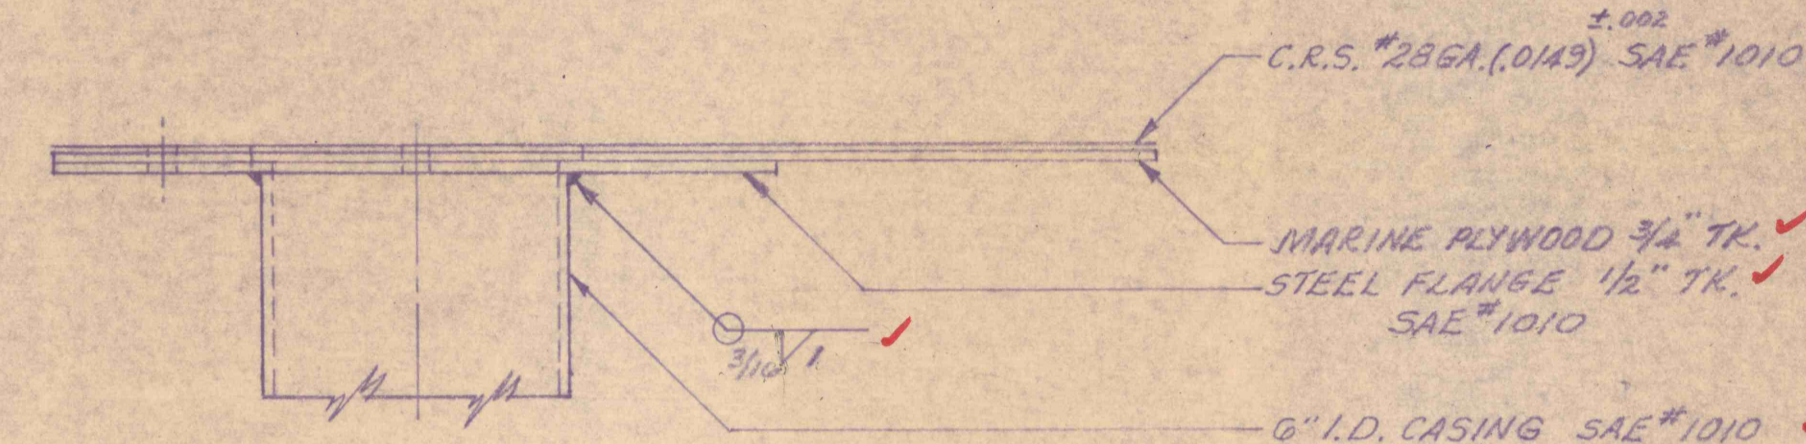





SECTION A-A
SCALE - FULL
MATERIAL BRASS SAE #41 ✓
DETAIL - 2

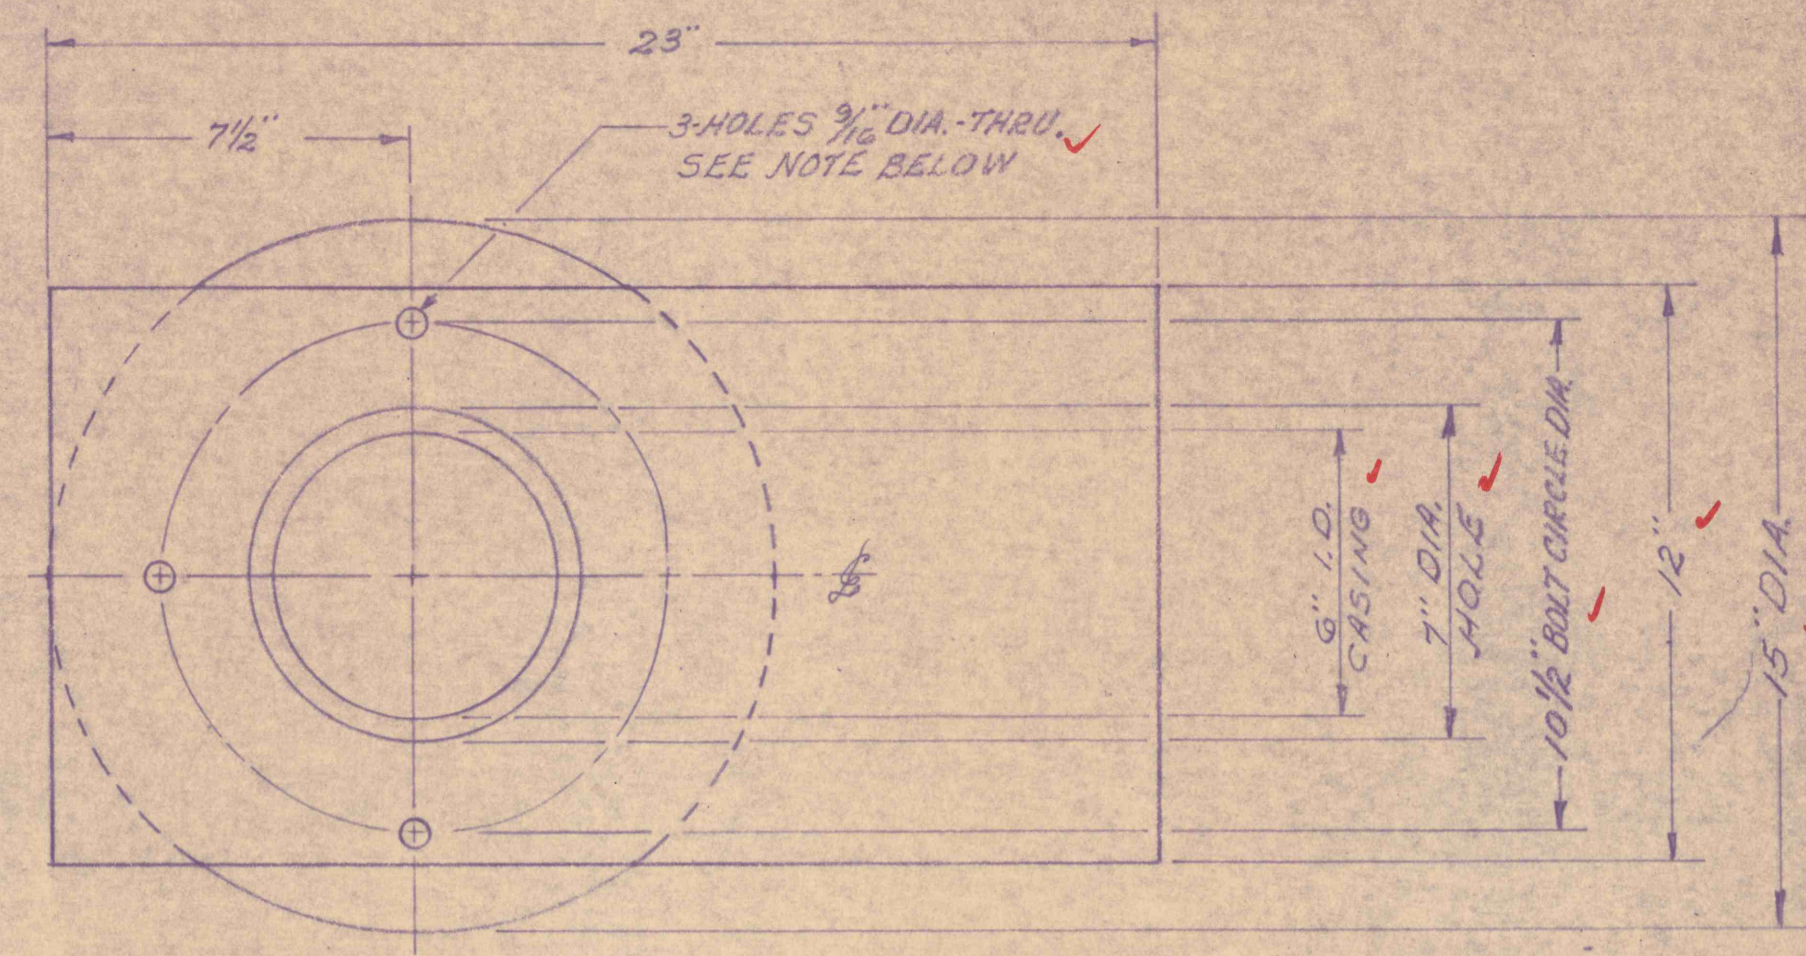

DETAIL - 3
SCALE: ?

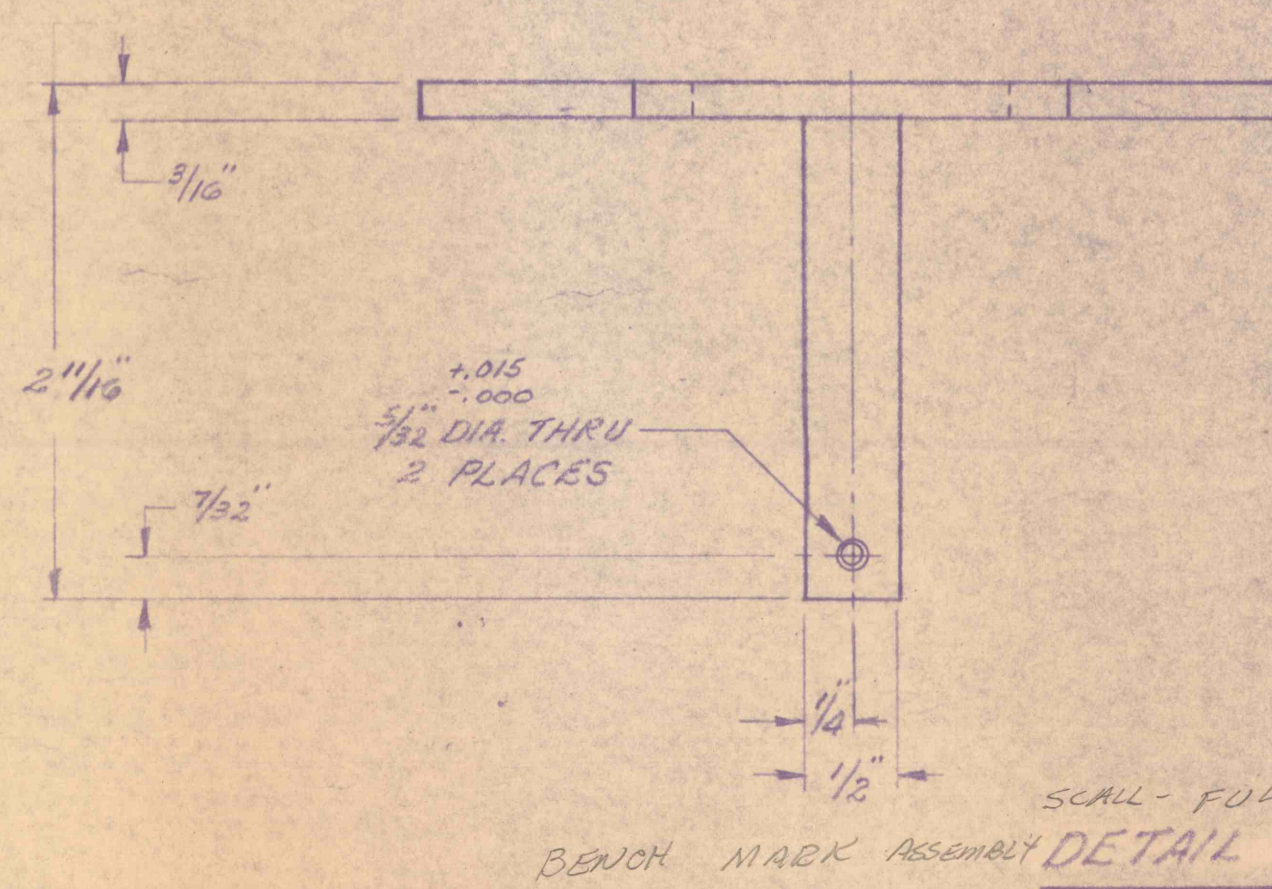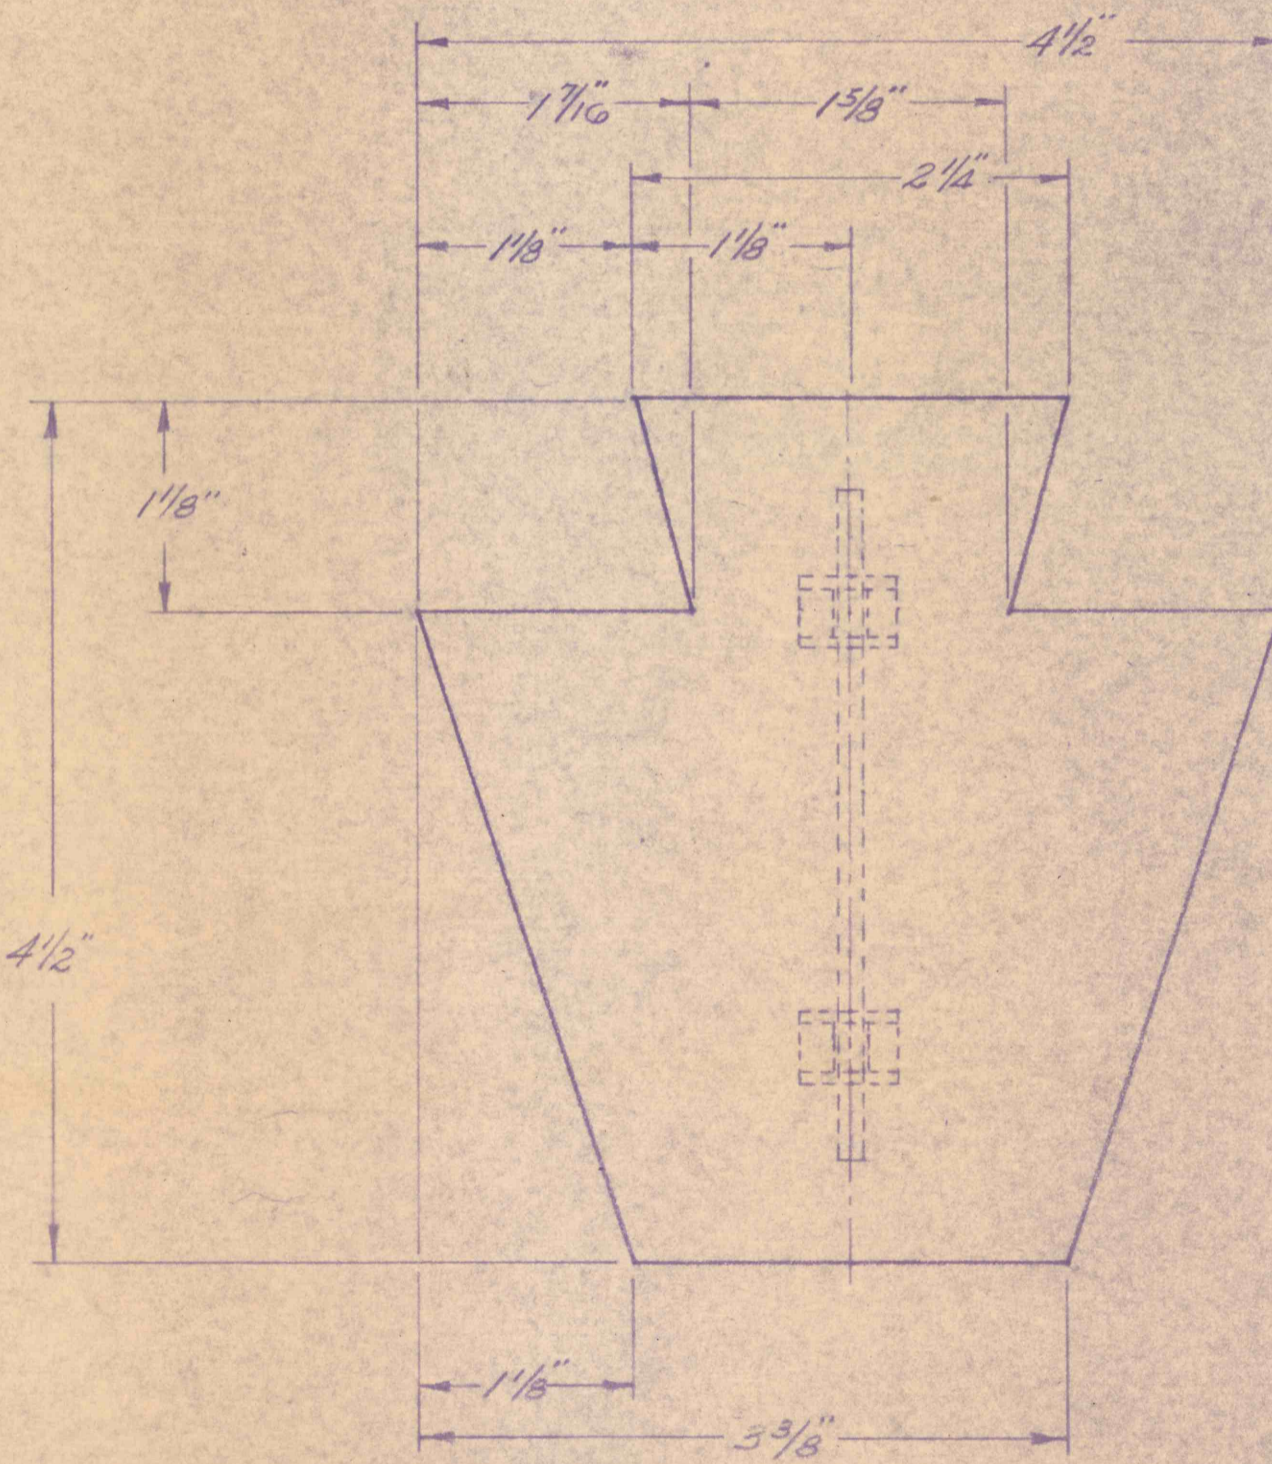

SCALE - FULL
BENCH MARK ASSEMBLY **DETAIL - 4**

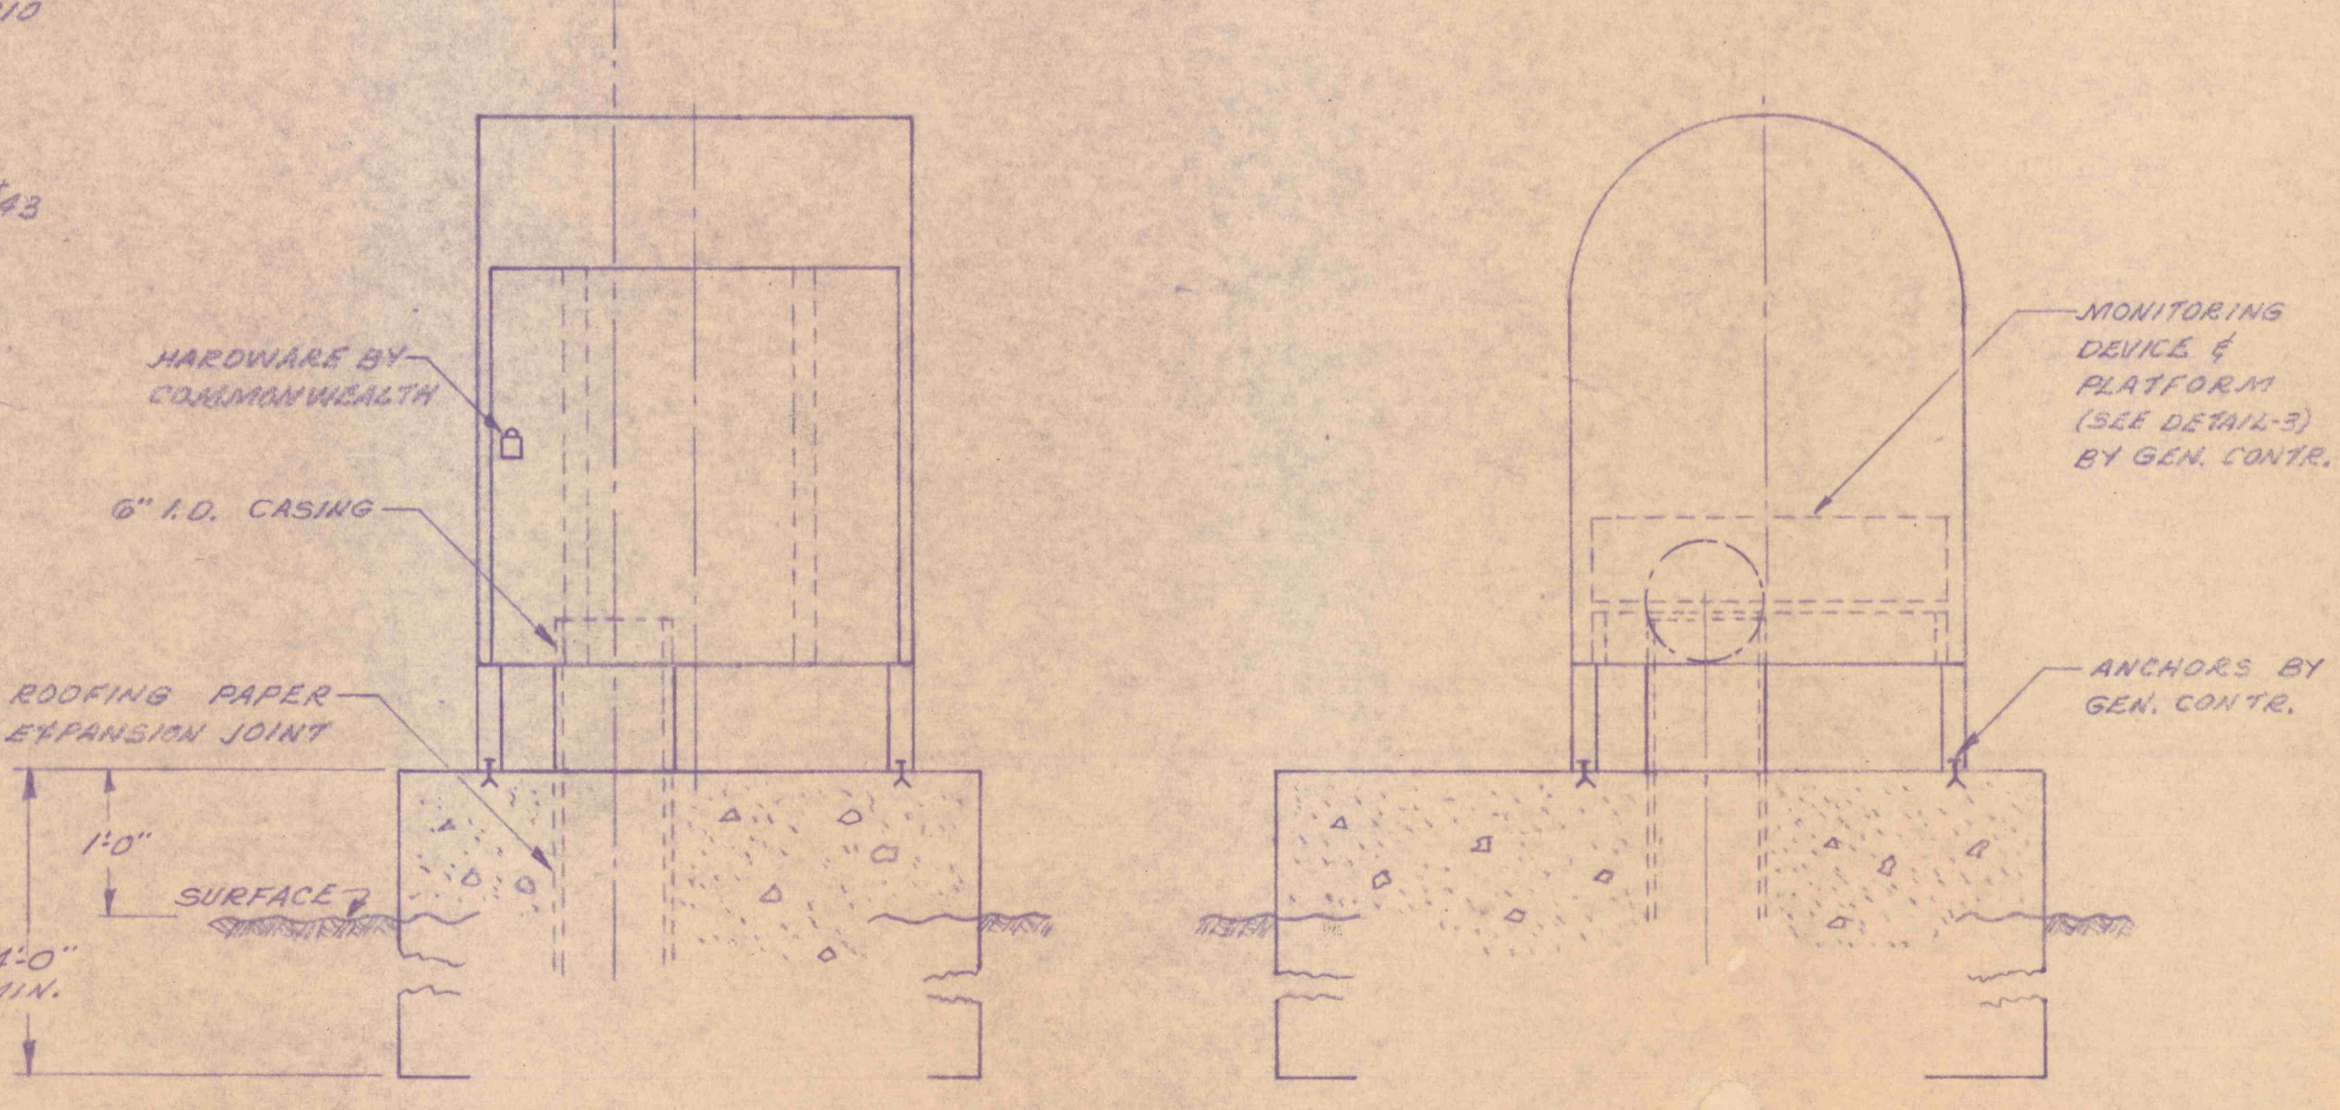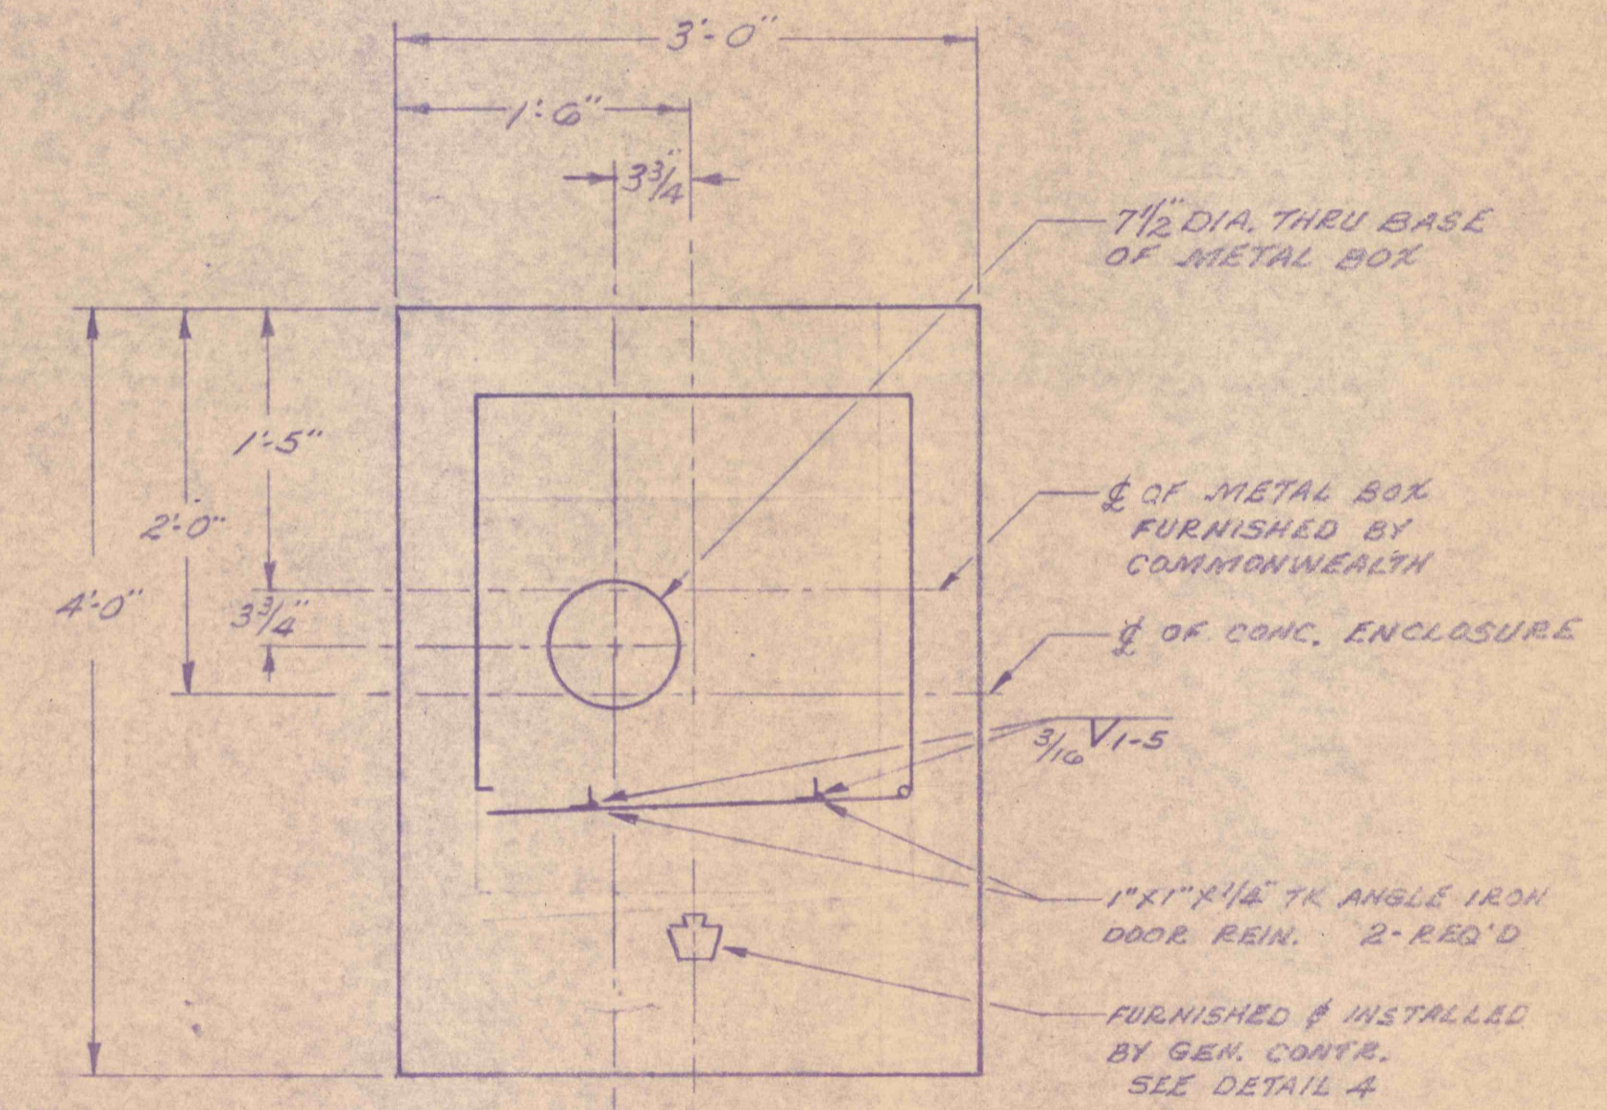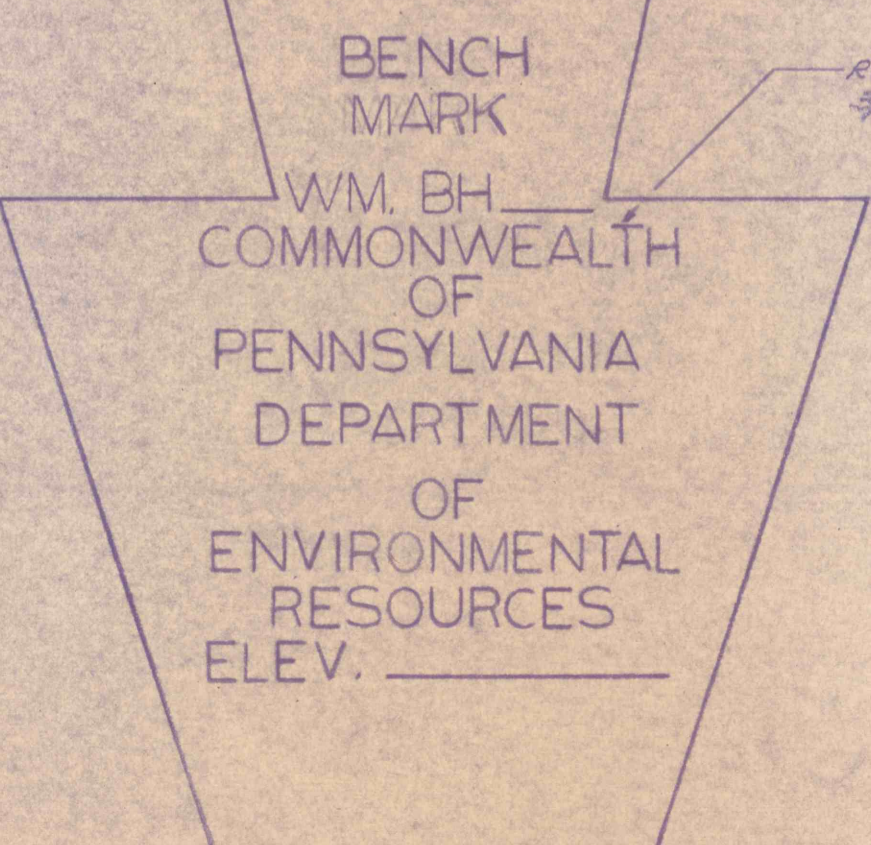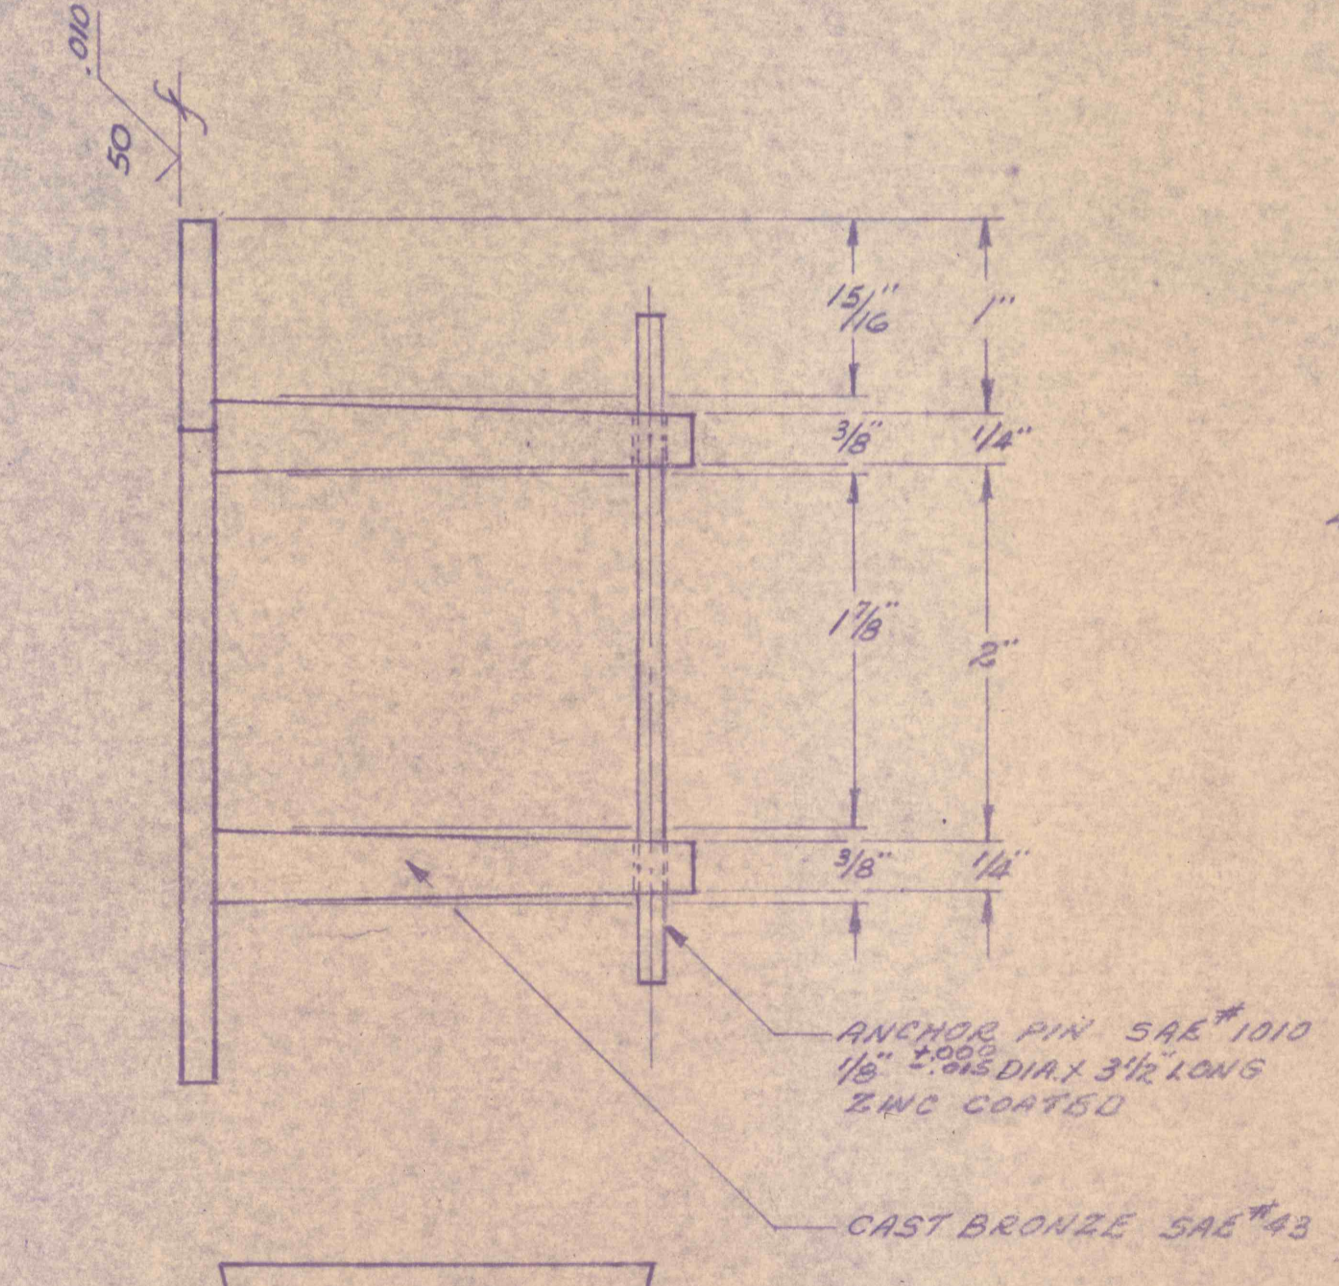

DETAIL - 5

NO.	DATE	REVISION	APPR.
COMMONWEALTH OF PENNSYLVANIA DEPARTMENT OF ENVIRONMENTAL RESOURCES OFFICE OF RESOURCES MANAGEMENT			
PROJECT NO. MWC, No.46, PHASE E			
CONSTRUCTION OF MINE WATER POOL MONITORING STATIONS DAUPHIN, CARBON AND SCHUYLKILL CO. PENNSYLVANIA			
DRAWN BY	DATE	DRAWING NO.	
CHECKED BY	SCALE	AS SHOWN	