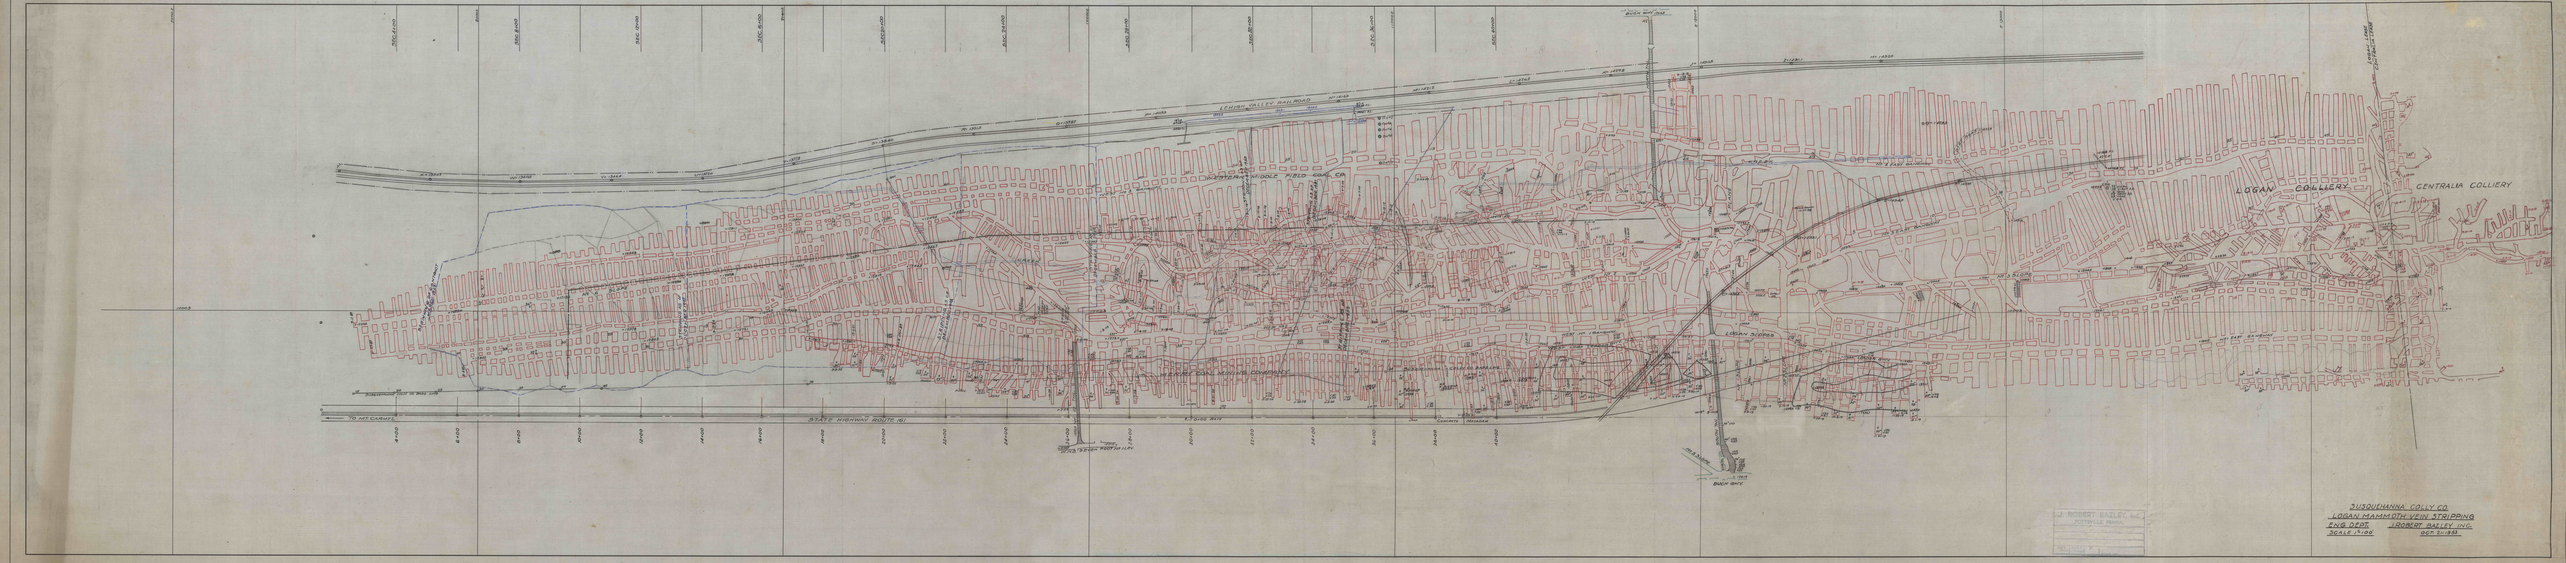
LEHIGH VALLEY RAILROAD
NORTHERN MIDDLE FIELD COAL CO.
LOGAN COLLIERY
CENTRALIA COLLIERY
LOGAN SLOPES
STATE HIGHWAY ROUTE 161
TO MT. CARMEL
SUSQUEHANNA COLLY CO.
LOGAN MAMMOTH VEIN STRIPPING
ENG. DEPT.
SCALE 1"=100'
J. ROBERT BAZLEY, INC.
OCTOBER 1933