
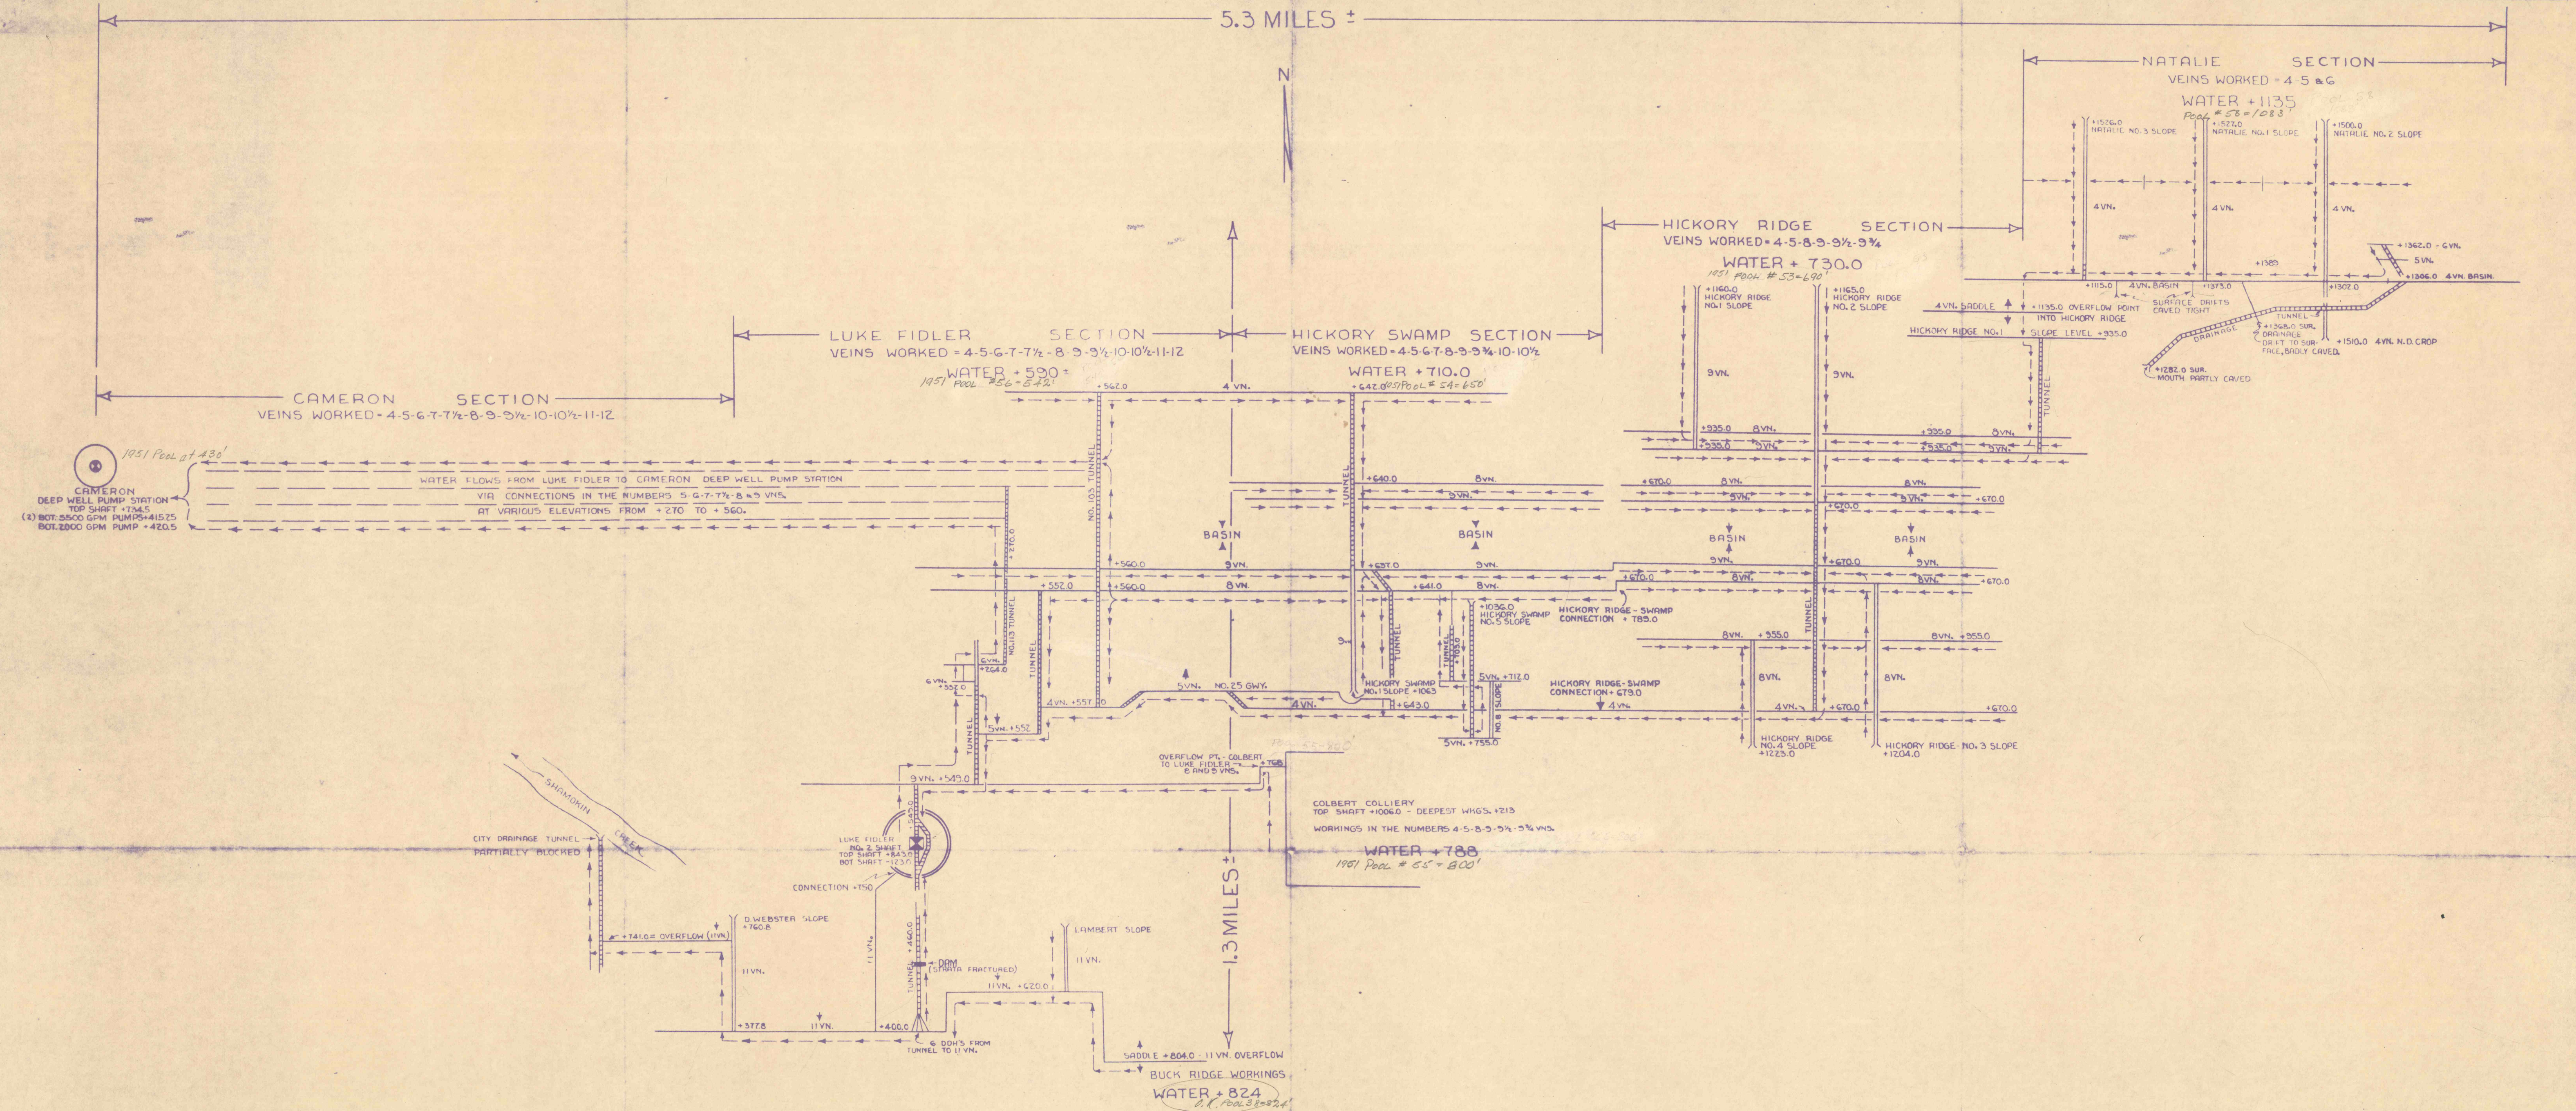


5.3 MILES ±

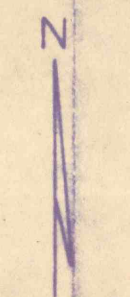

SUSQUEHANNA COLLIERIES DIVISION
 THE M.A.HANNA COMPANY
 GLEN BURN COLLIERY
 SHAMOKIN, PA.

SCHEMATIC MAP SHOWING INTERCONNECTED ABANDONED MINES AND WATER FLOW AFFECTING CAMERON DEEP WELL PUMPING STATION

5-8-56
 NO SCALE