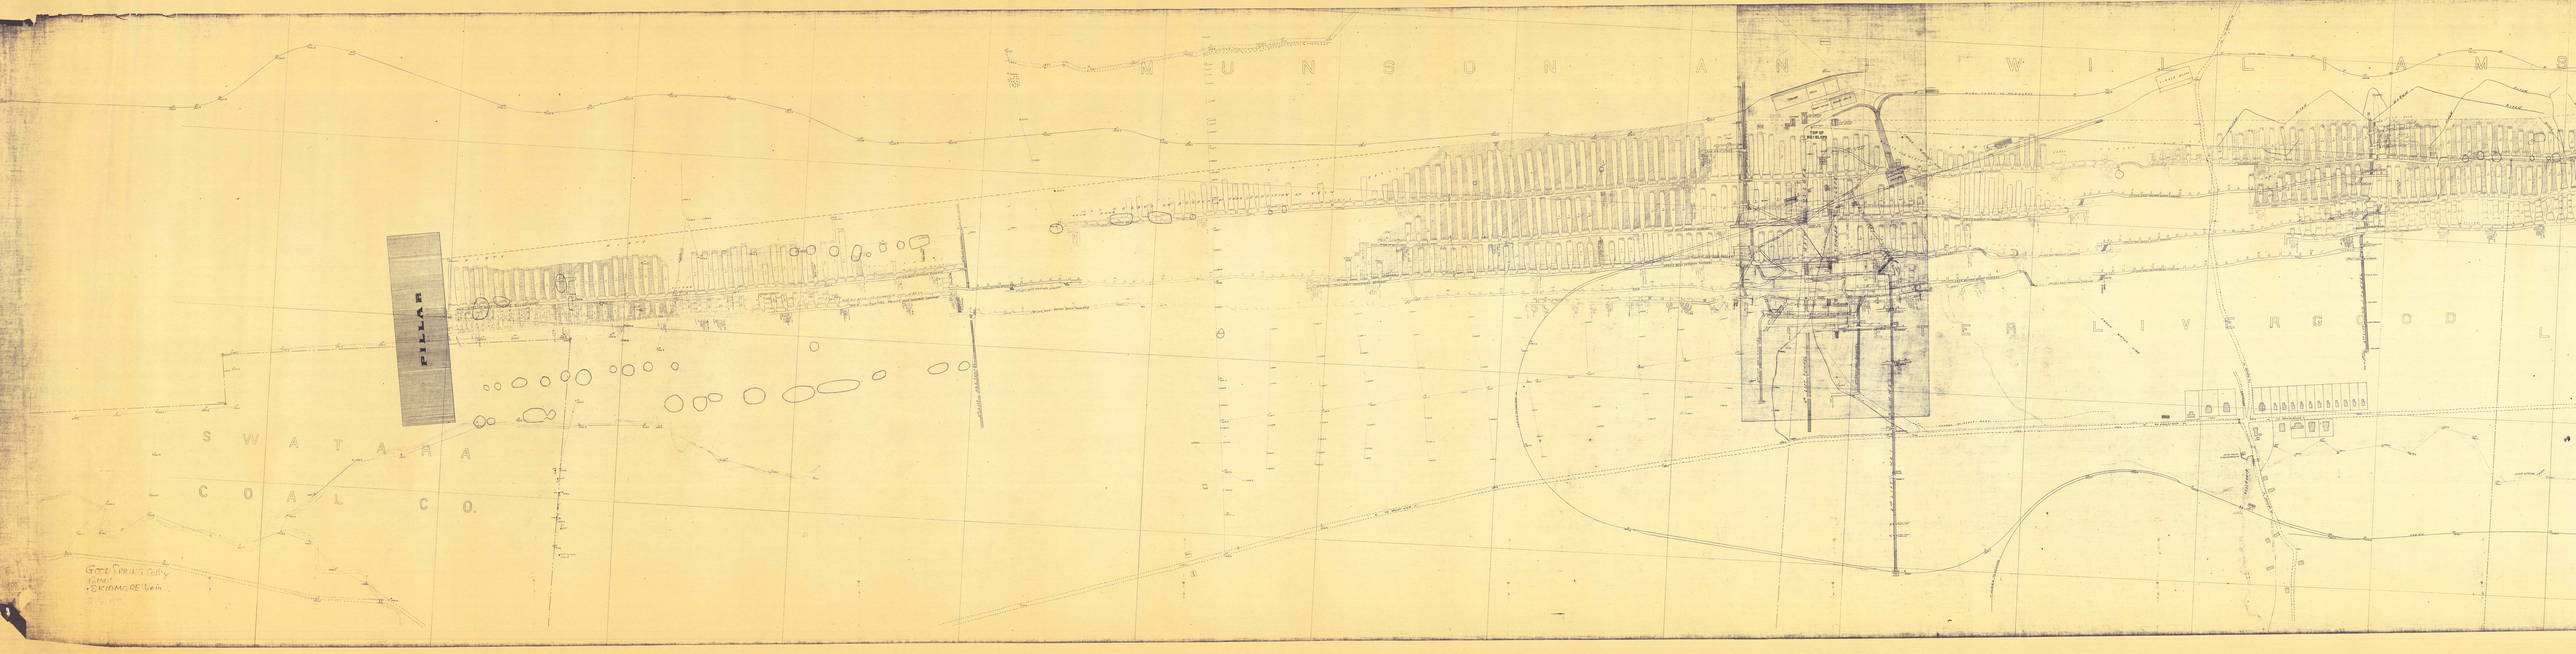

MUNSON AND WILLIAMS
SWATARA
COAL CO.
PILLAR
Good Spring Coal
Intec
SKIDMORE Vein