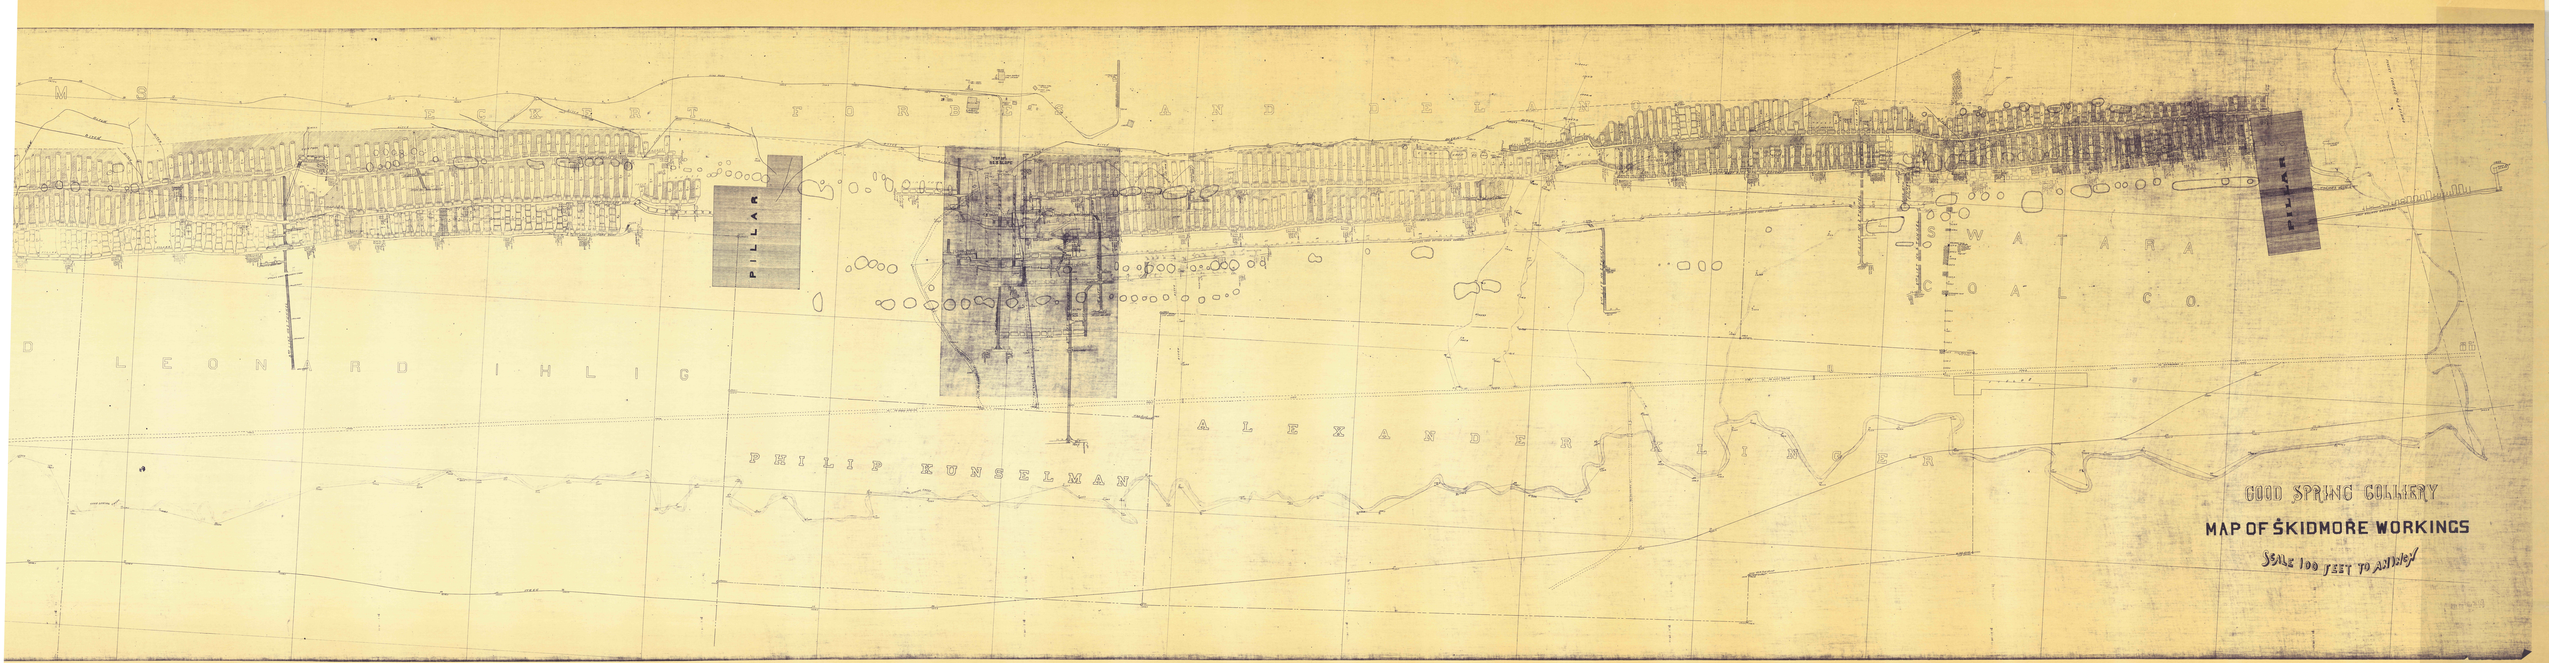

M S ECKERT FORBES AND DELANO
PILLAR
PILLAR
SWATARA COAL CO.
D LEONARD IHLIG
ALEXANDER KLINGER
PHILIP KUNSELMAN
GOOD SPRING COLLIERY
MAP OF SKIDMORE WORKINGS
SCALE 100 FEET TO AN INCH