Project 46-D

Monitoring Boreholes (Ph. IV)

Resident Eg. M.
Surveyor S. Berger
Inspector W. Newton

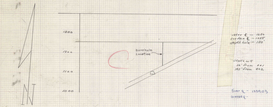

Borehole No. 3
Vol. 2 - Series 400
East Mahanoy City
Scale 1"=100'
DRAWN BY RH

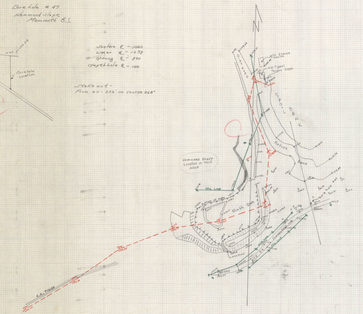
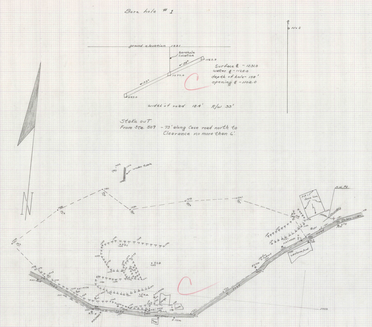
Borehole No. 47
Location - Tandaw Slope
Vol. 2 - Series 1000
West Mahanoy Twp.
Scale 1"=100'
DRAWN BY RH