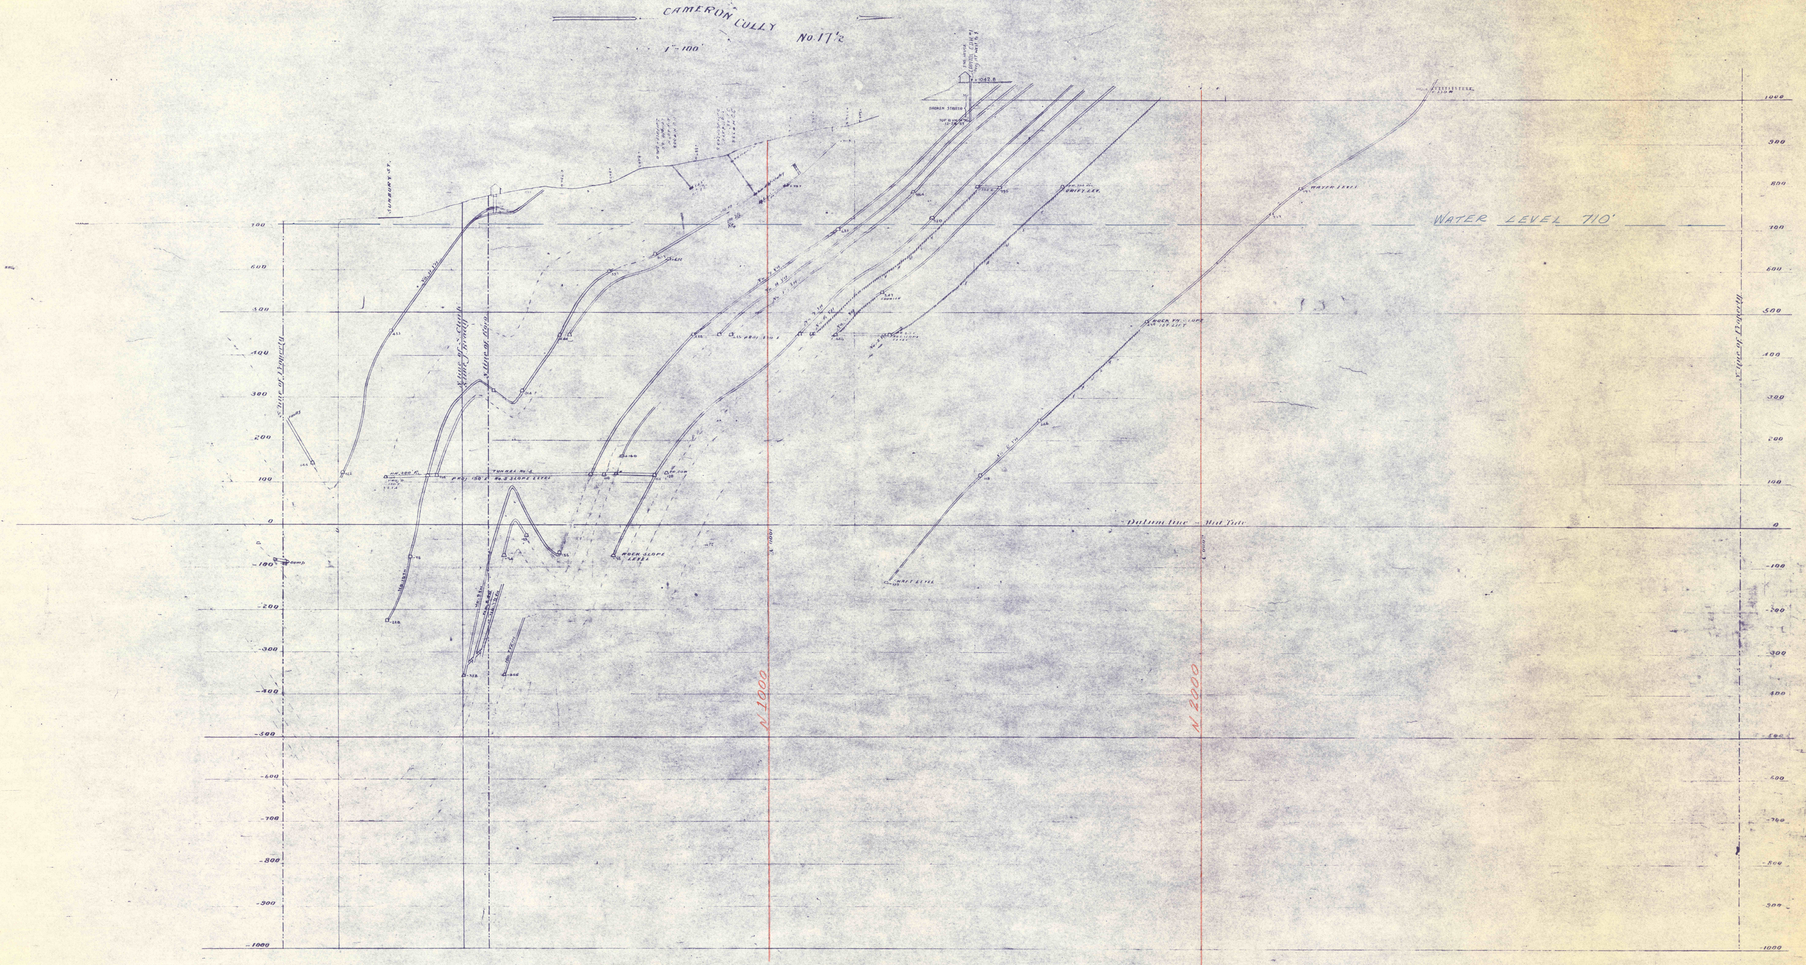
CAMERON CULLY
No. 17½
1" = 100'
WATER LEVEL 710'
Datum line = Mid Tide
N 1000
N 2000

No. 17½