


Cameron Colly Section No. 19  
1" = 100'

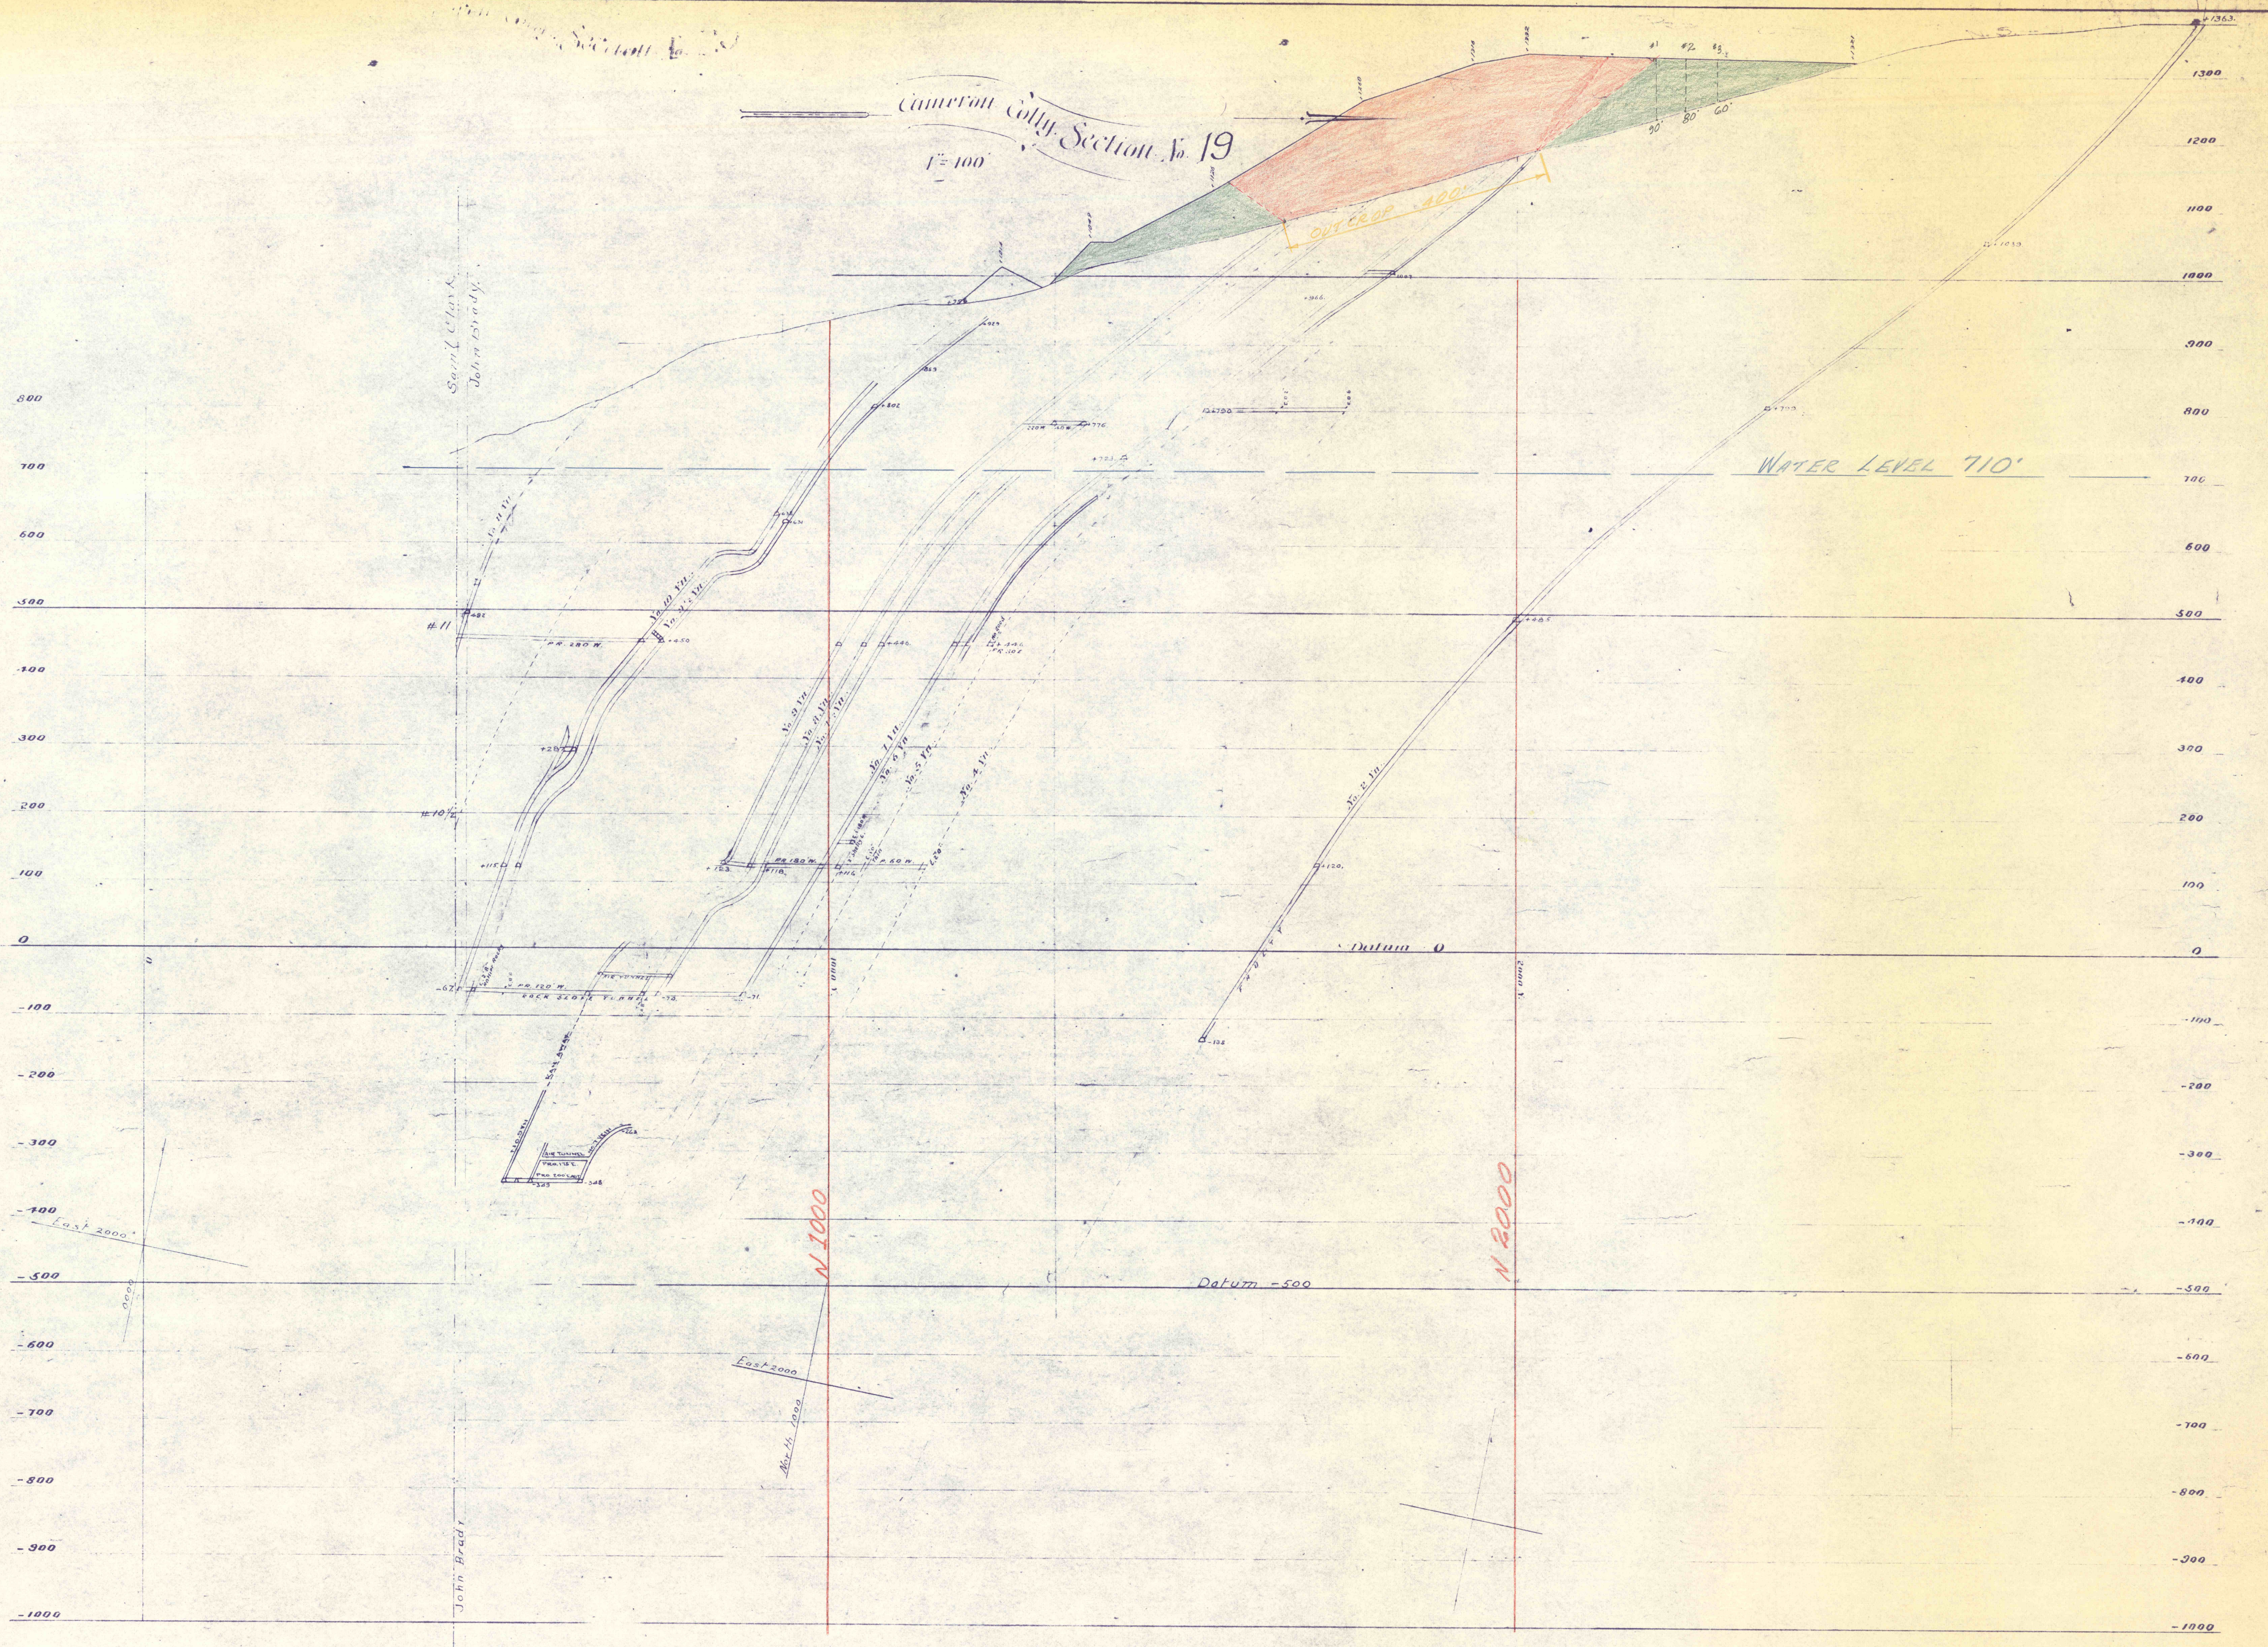

pl 21