


No S3

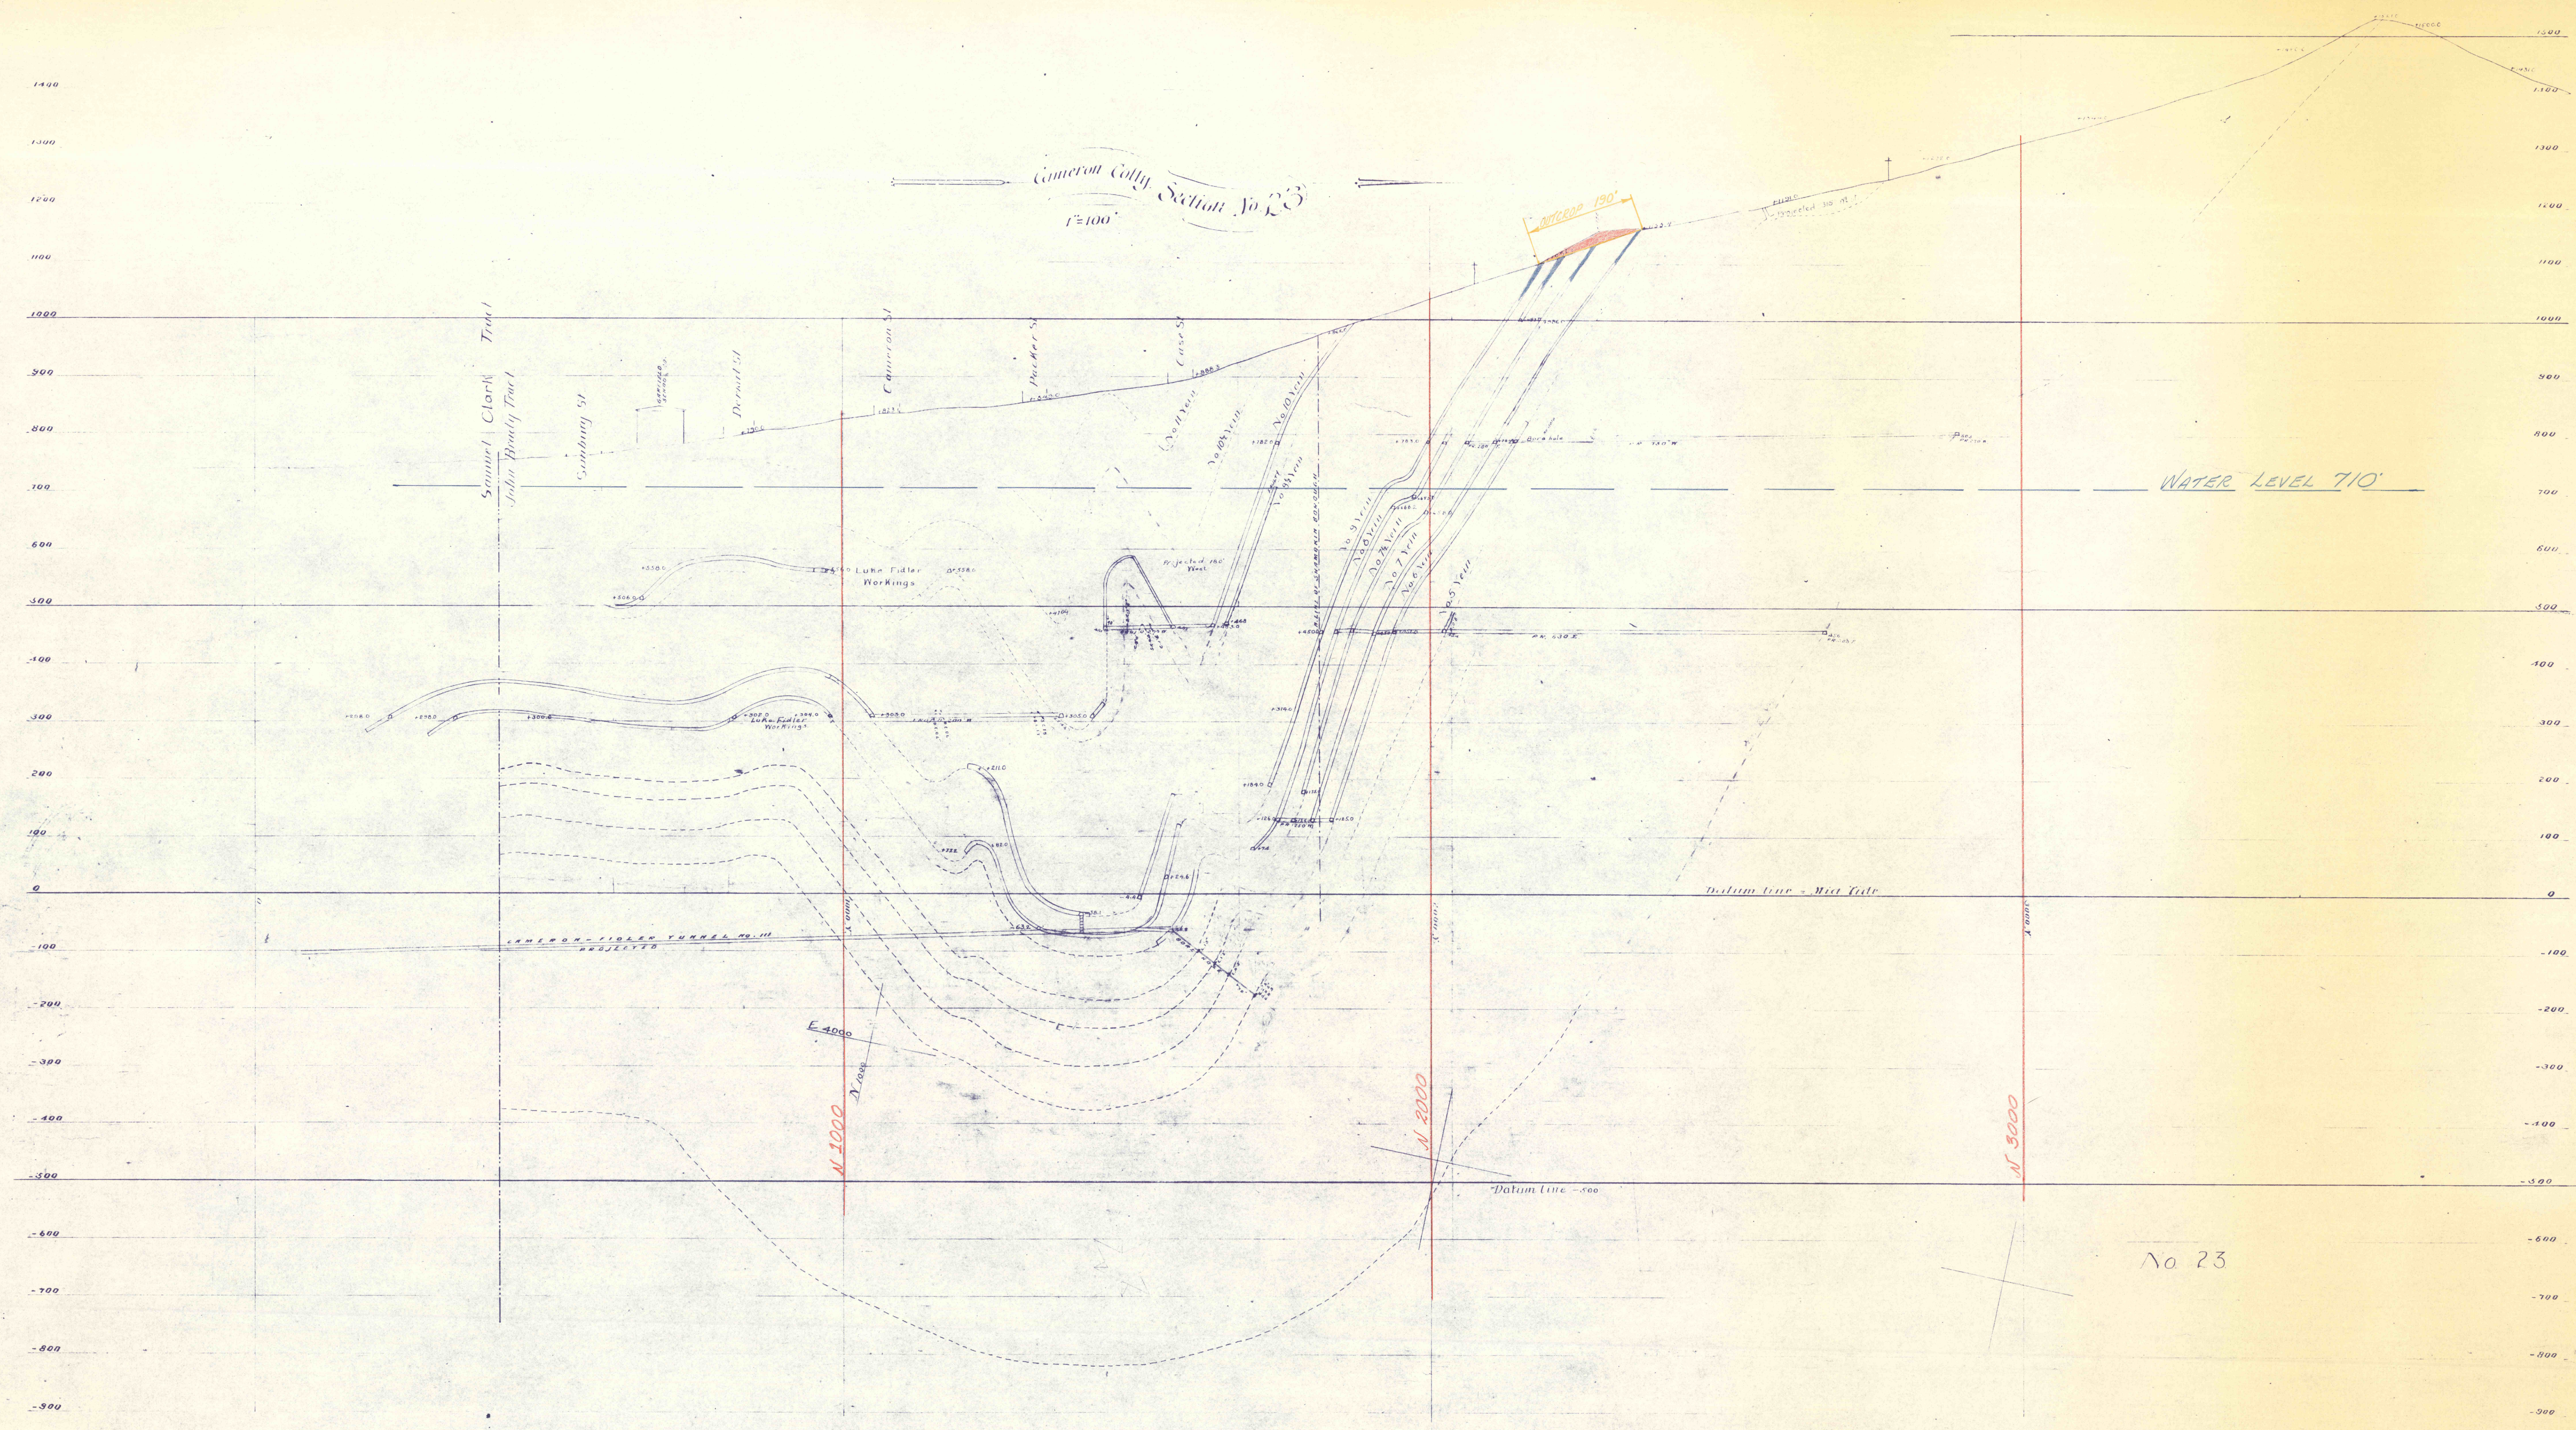

No. 23

No. 23