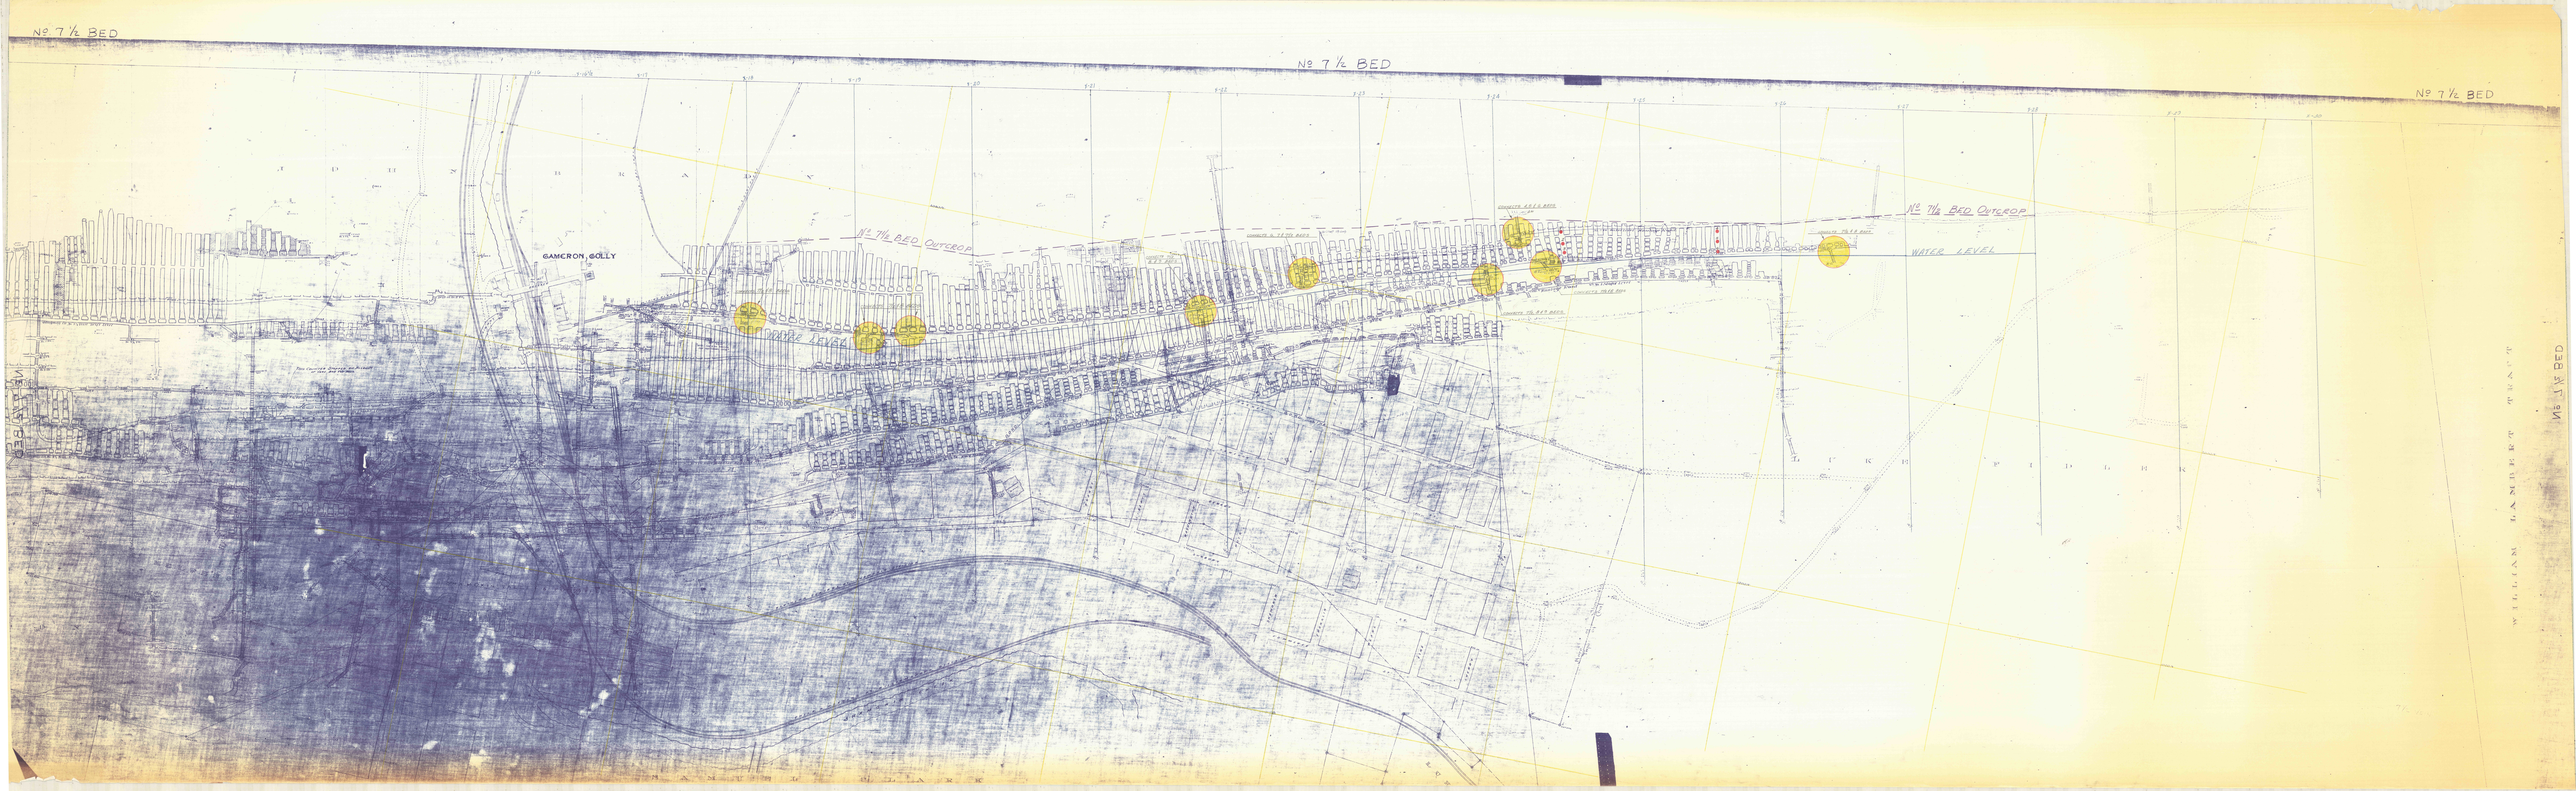

No. 7½ BED
No. 7½ BED
No. 7½ BED
No. 7½ BED OUTCROP
No. 7½ BED OUTCROP
WATER LEVEL
GAMCRON COLLY
WILLIAM LAMBERT TRACT
No. 1½ BED