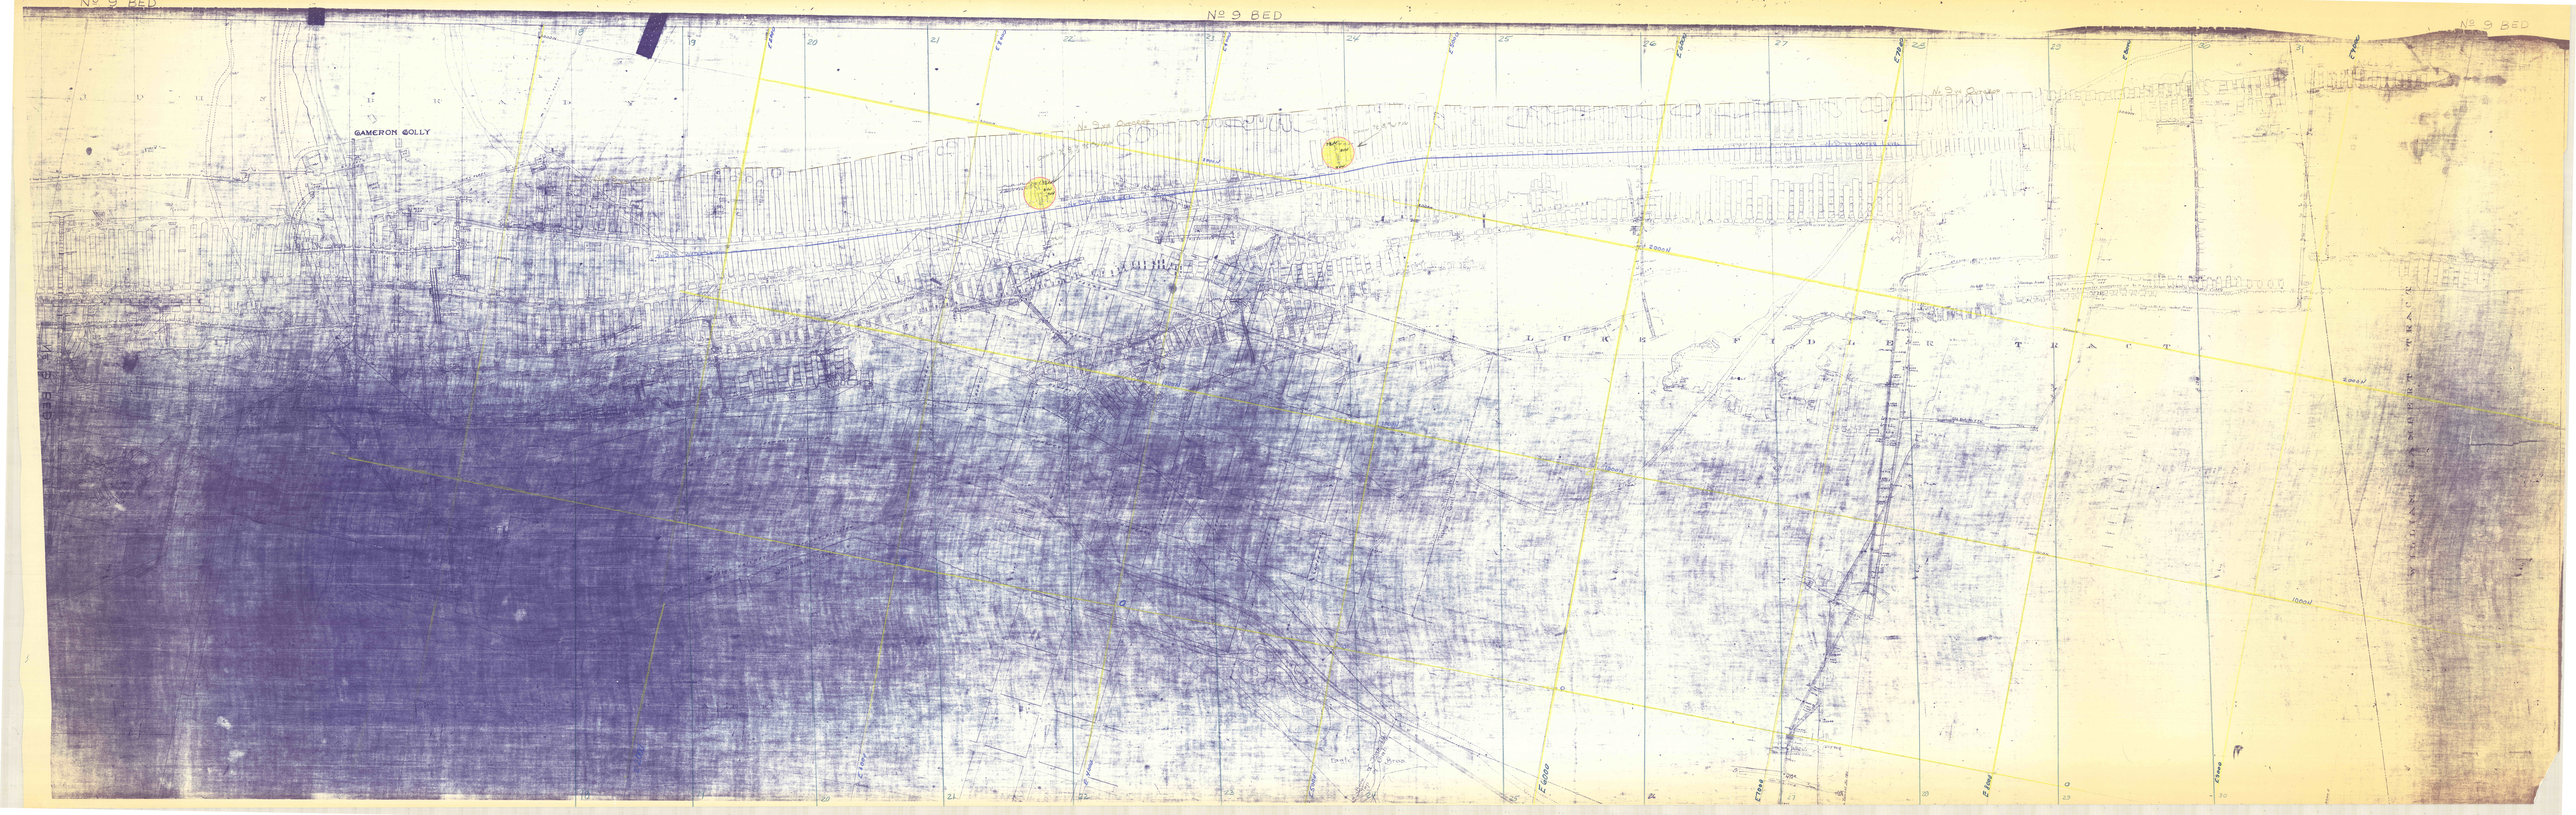
No 9 BED
No 9 BED
No 9 BED
CAMERON GOLLY
LURGS FIDDLER TRACT
E 6000
E 7000
