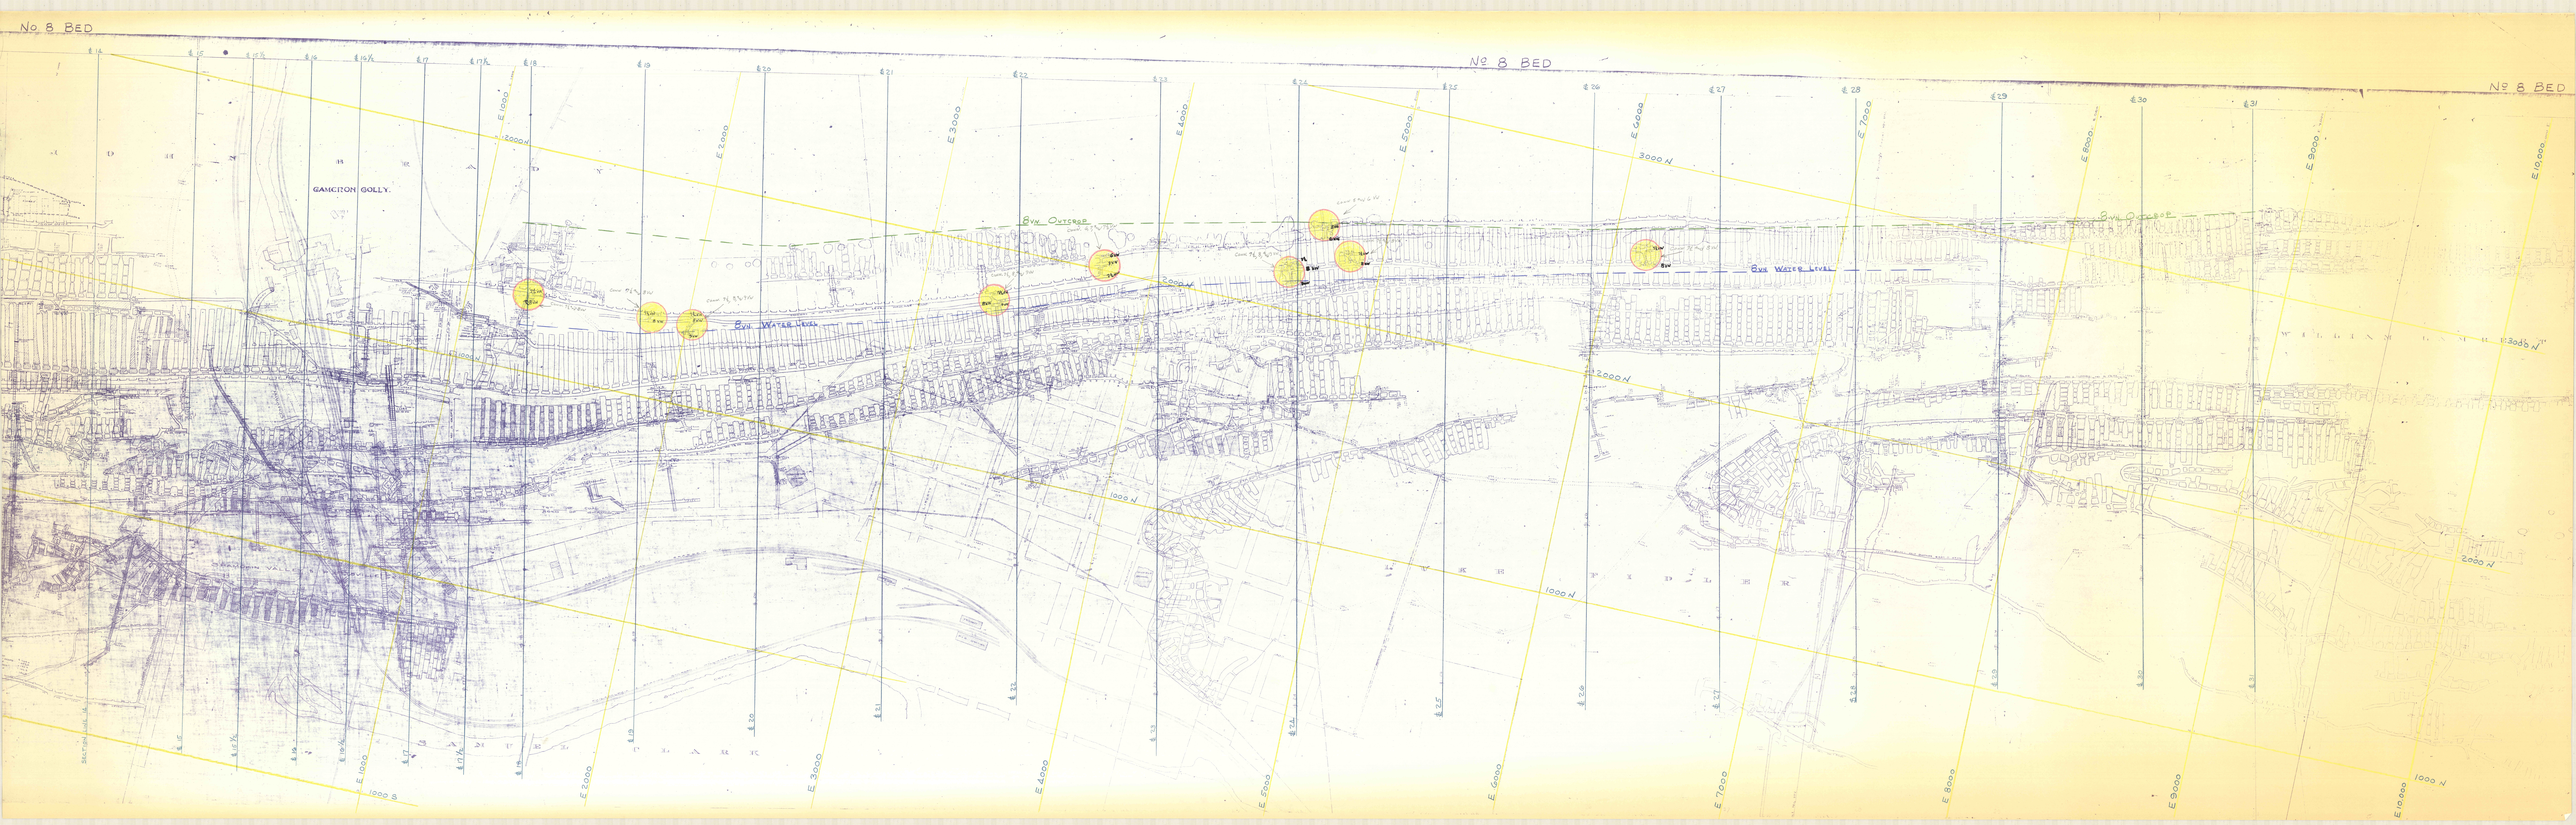
No 8 BED
No 8 BED
No 8 BED
GAMCITON GOLLY.
BVW Outcrop
BVW Water Level
BVW Outcrop
BVW Water Level
E 1000
E 2000
E 3000
E 4000
E 5000
E 6000
E 7000
E 8000
E 9000
E 10000
2000 N
1000 N
1000 S
3000 N
2000 N
1000 N
2000 N