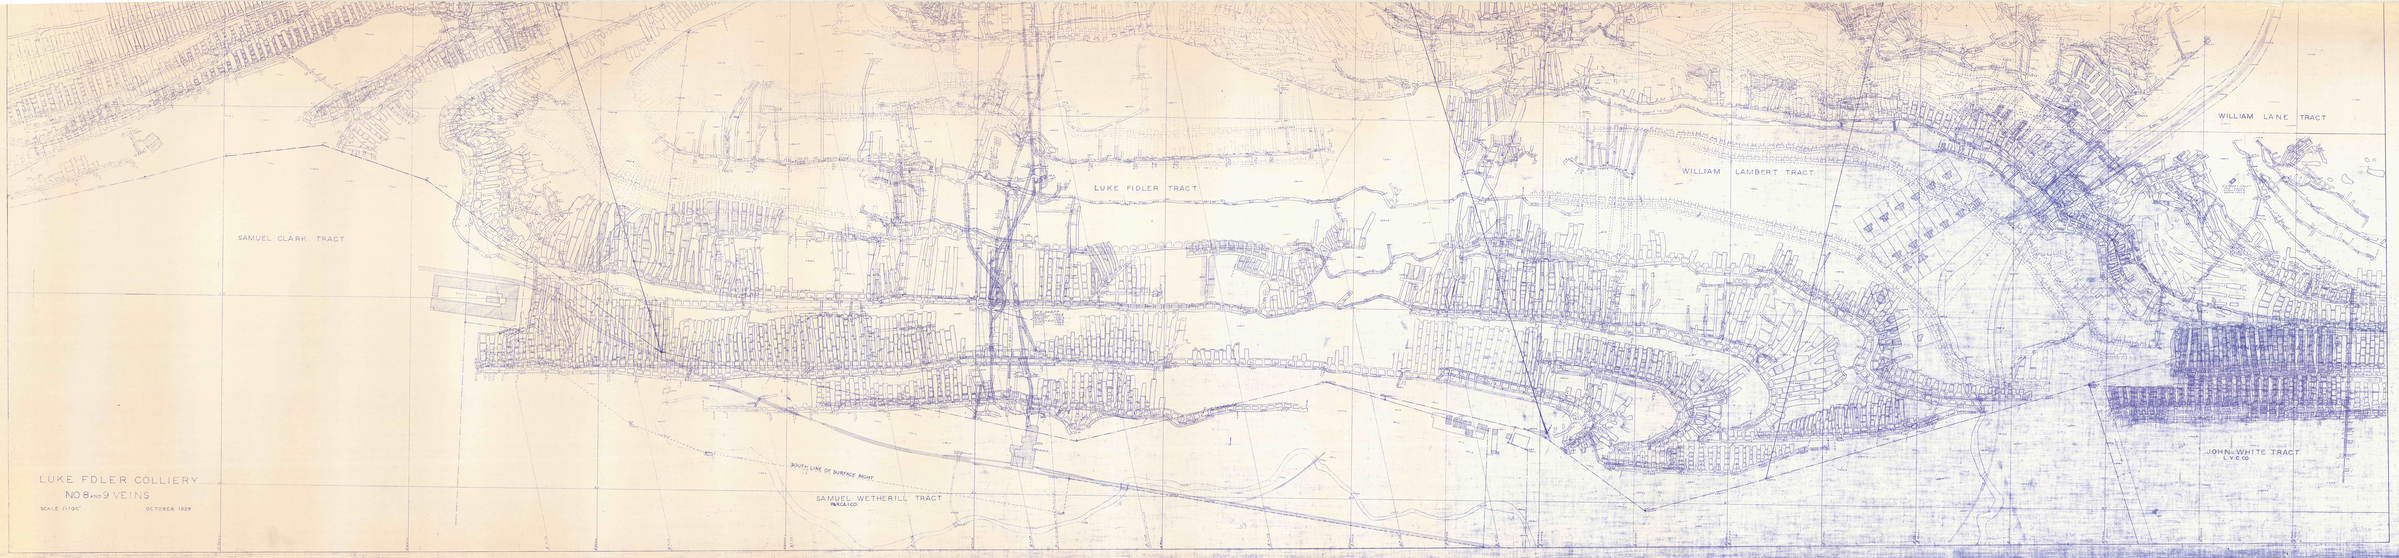
SAMUEL CLARK TRACT
LUKE FIDLER TRACT
WILLIAM LAMBERT TRACT
WILLIAM LANE TRACT
SOUTH LINE OF SURFACE RIGHT
SAMUEL WETHERILL TRACT
PIKE & CO.
JOHN WHITE TRACT
LYKE CO.
LUKE FDLER COLLIERY
NO 8 AND 9 VEINS
SCALE 1=100'
OCTOBER 1928