 

WIDDLE FIELD
COAL TOWNSHIP
LUKE PIDDER COBBY
NORTHUMBERLAND COUNTY
