


SUSQUEHANNA COLLIERIES CO.
HICKORY SWAMP COLLIERY
SECTION ON MERIDIAN 14,500 E.

SCALE 1"=100'

NOVEMBER 30, 1921.

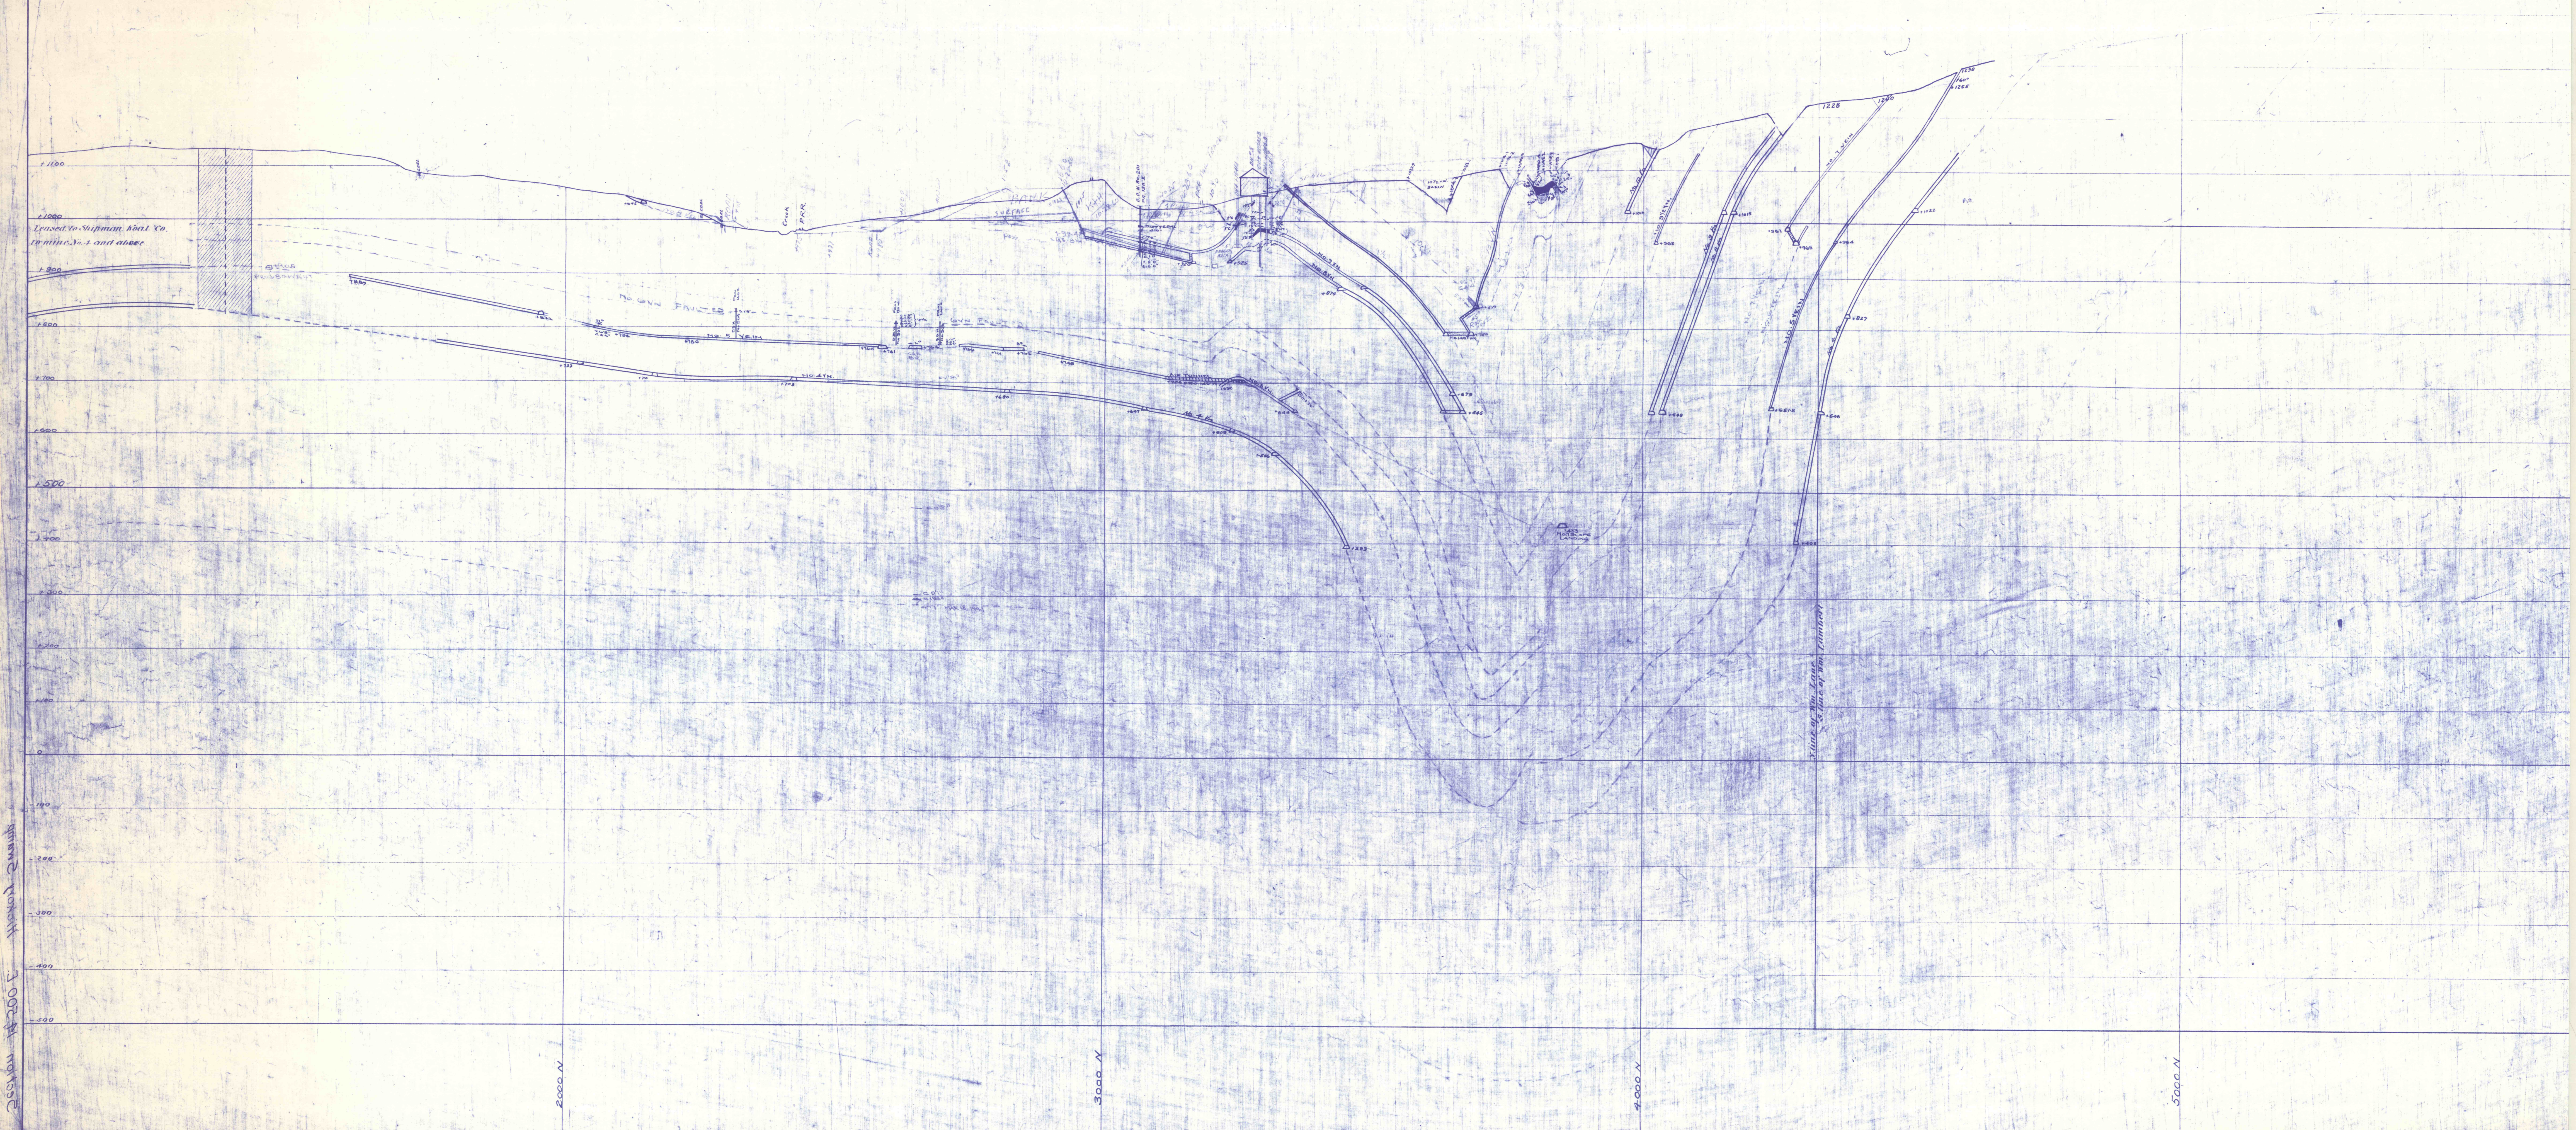

Leased to Shipman Coal Co.



2000 X

3000 X

4000 X

5000 X