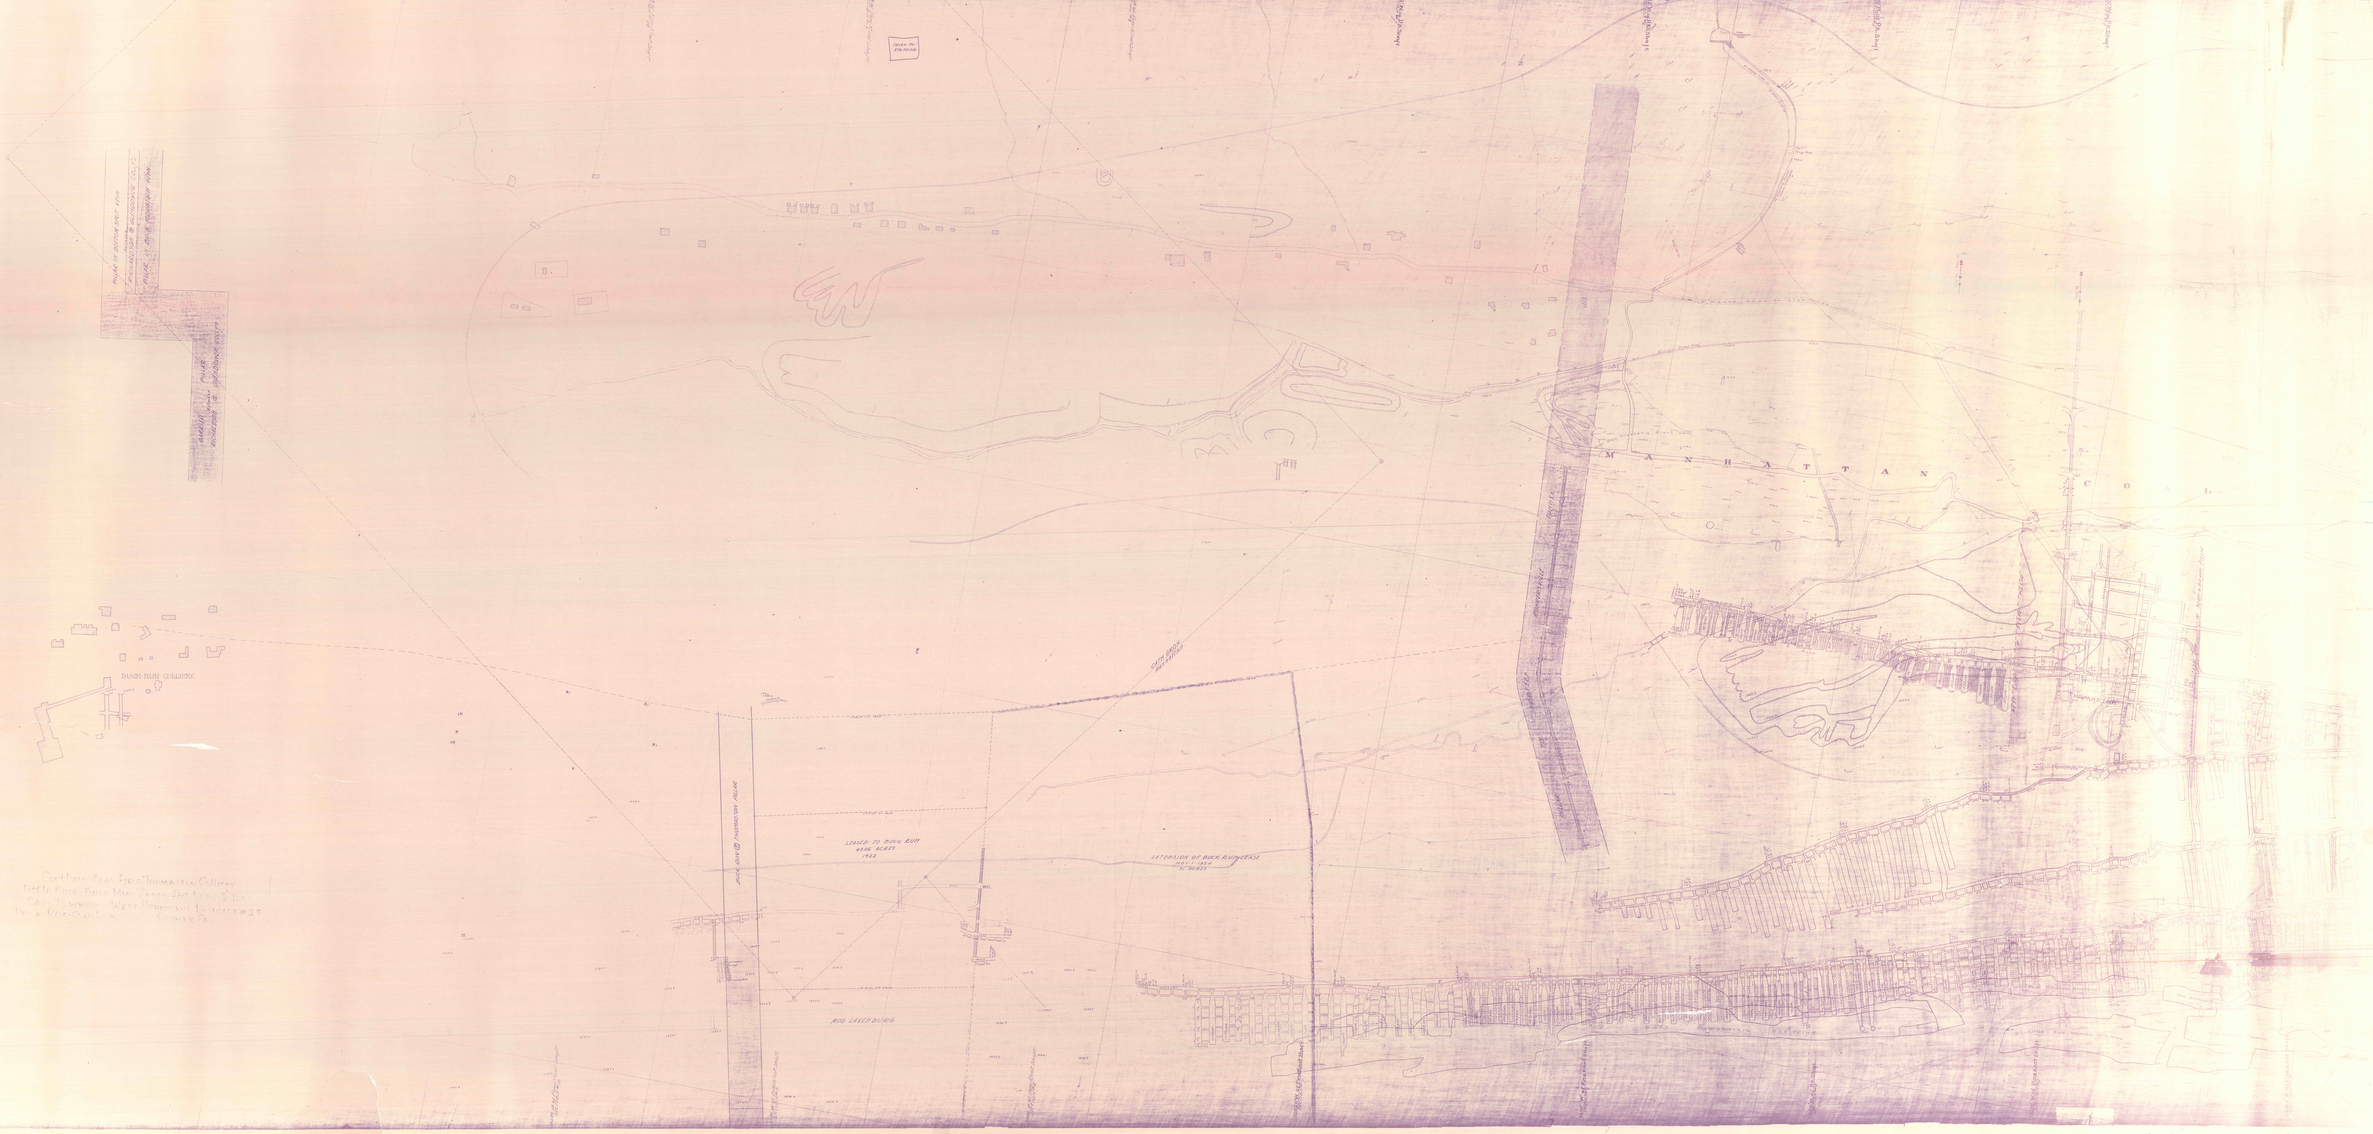
BACK RUN COLLIERY
LEASED TO BACK RUN
4.694 ACRES
1924
EXTENSION OF BACK RUN LEASE
11 ACRES
MANHATTAN
COAL