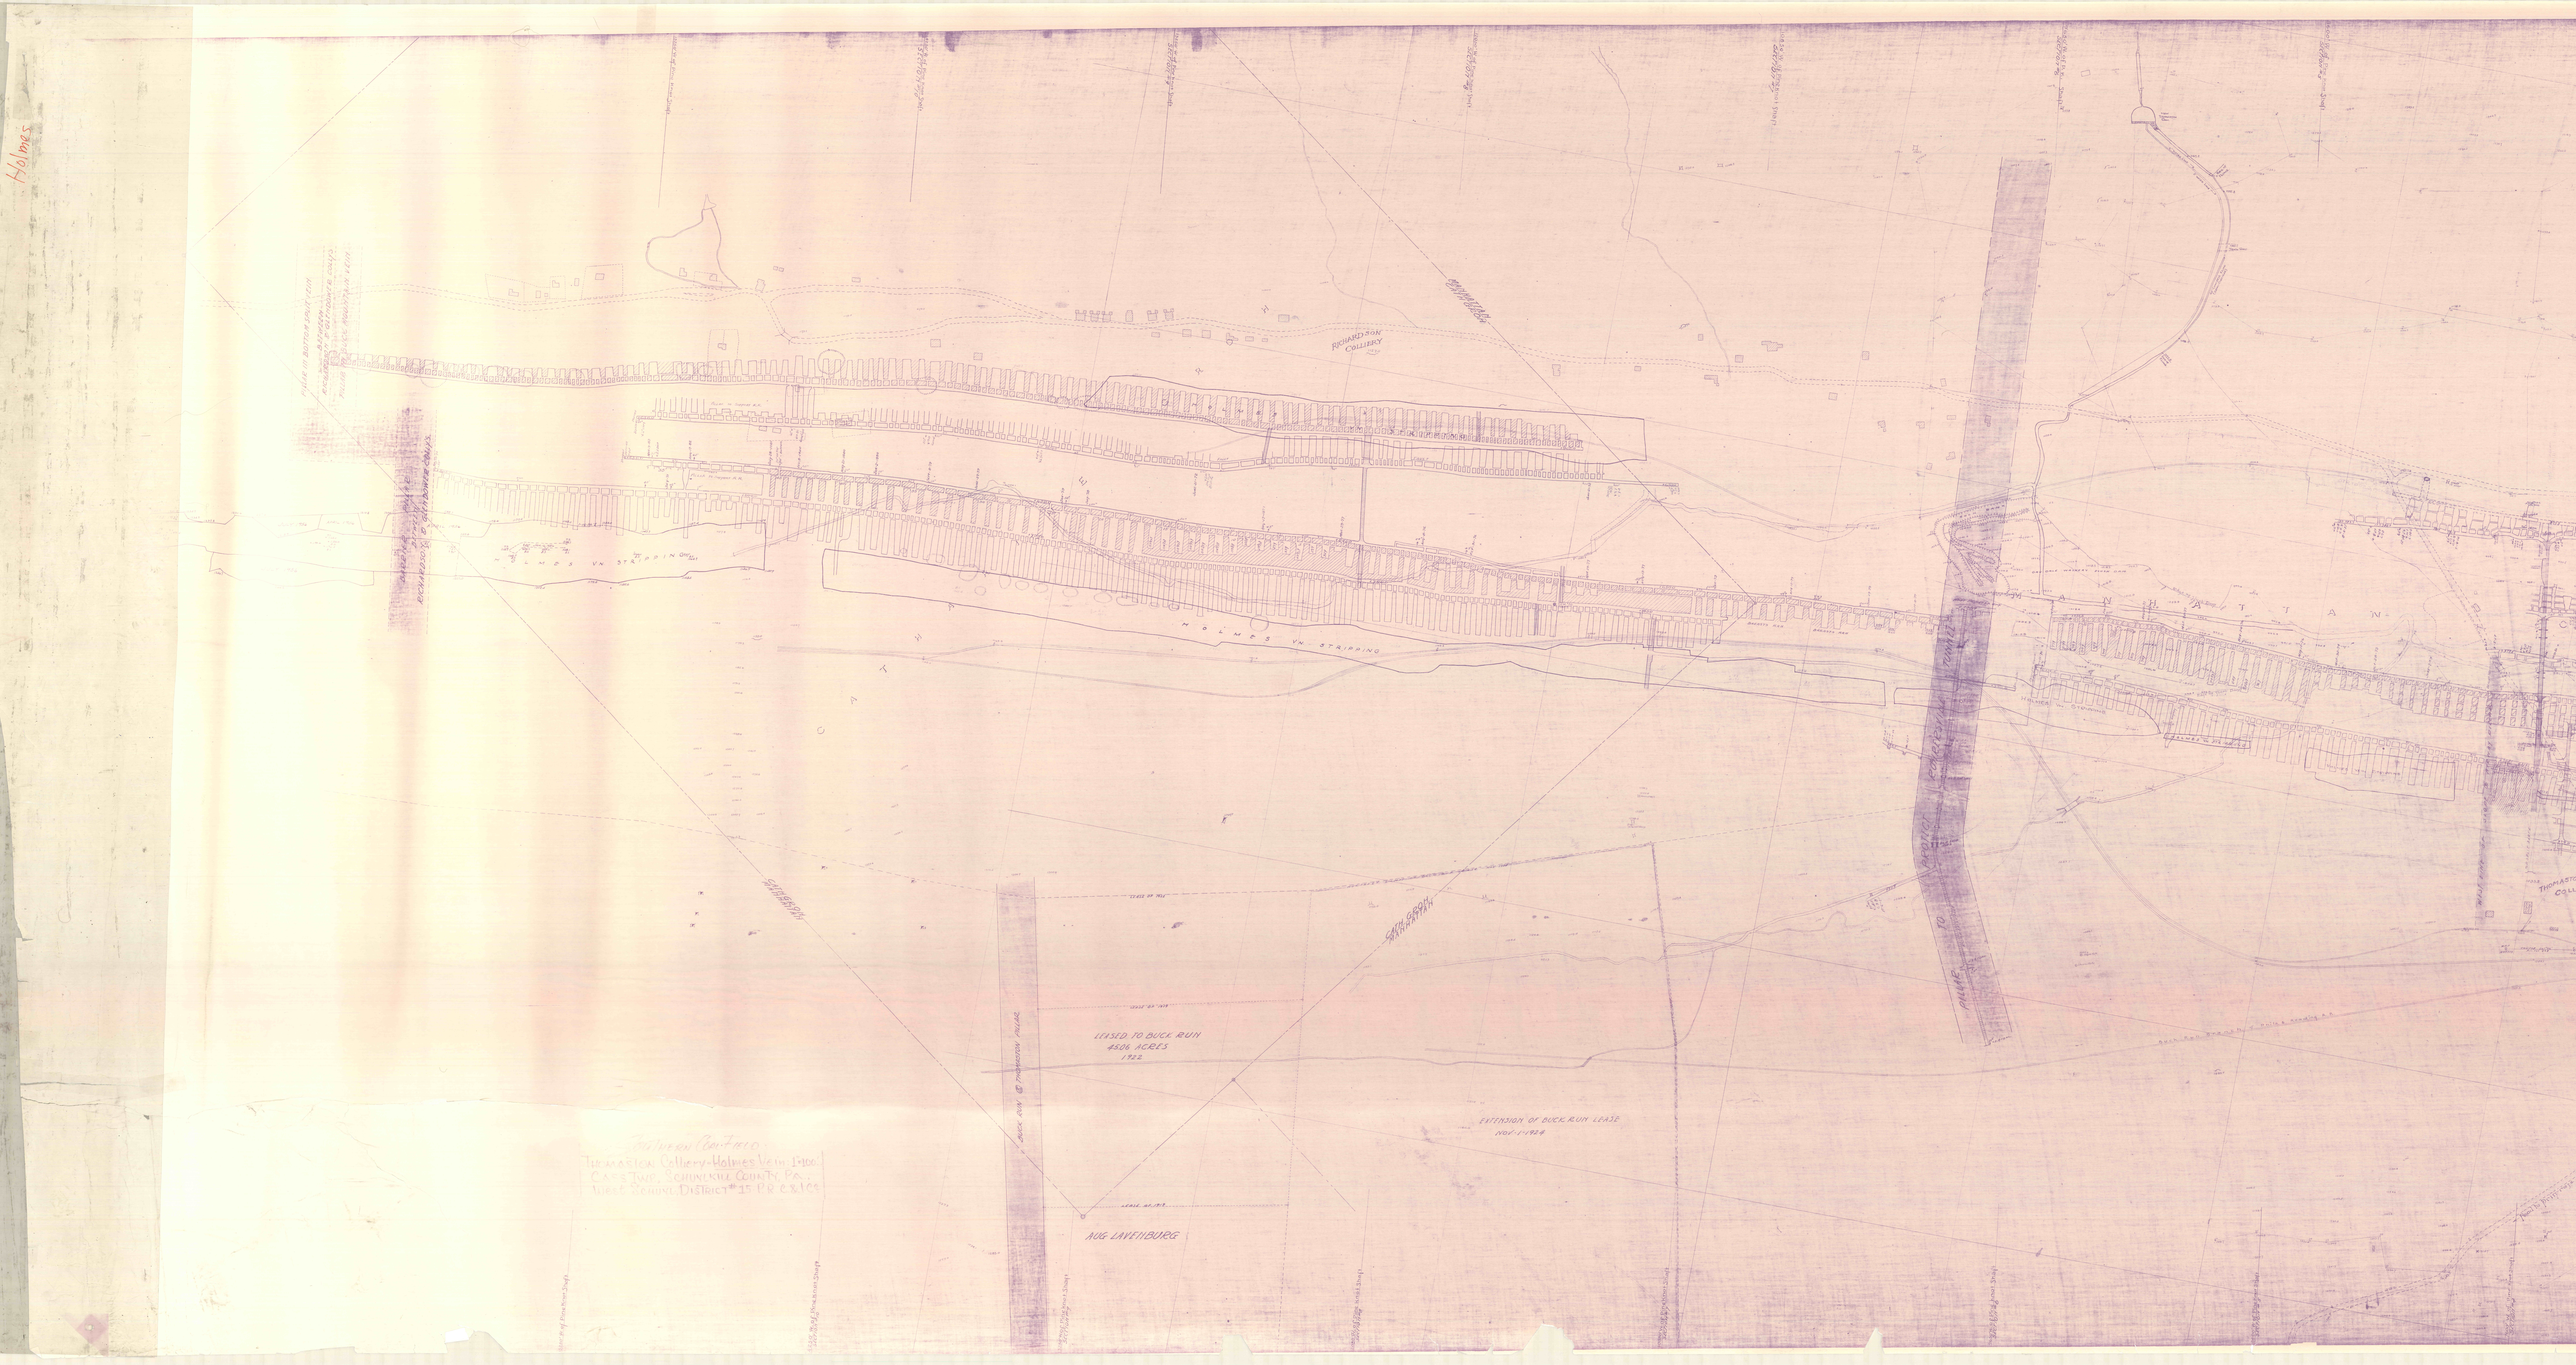
Holmes
RICHARDSON COLLIERY
HOLMES VN STRIPPING
HOLMES VN STRIPPING
CATH GROH MANHATTAN
LEASED TO BUCK RUN
45.06 ACRES
1922
EXTENSION OF BUCK RUN LEASE
NOV. 1-1924
AUG LAVENBURG
PILLAR TO PROTECT PORTRAIT TUNNEL
Southern Coal Field
Thomaston Colliery-Holmes Vein 1"=100'
Cass Twp. Schuylkill County, Pa.
West Schuyl. District #15 P.R.C. & I.Co.