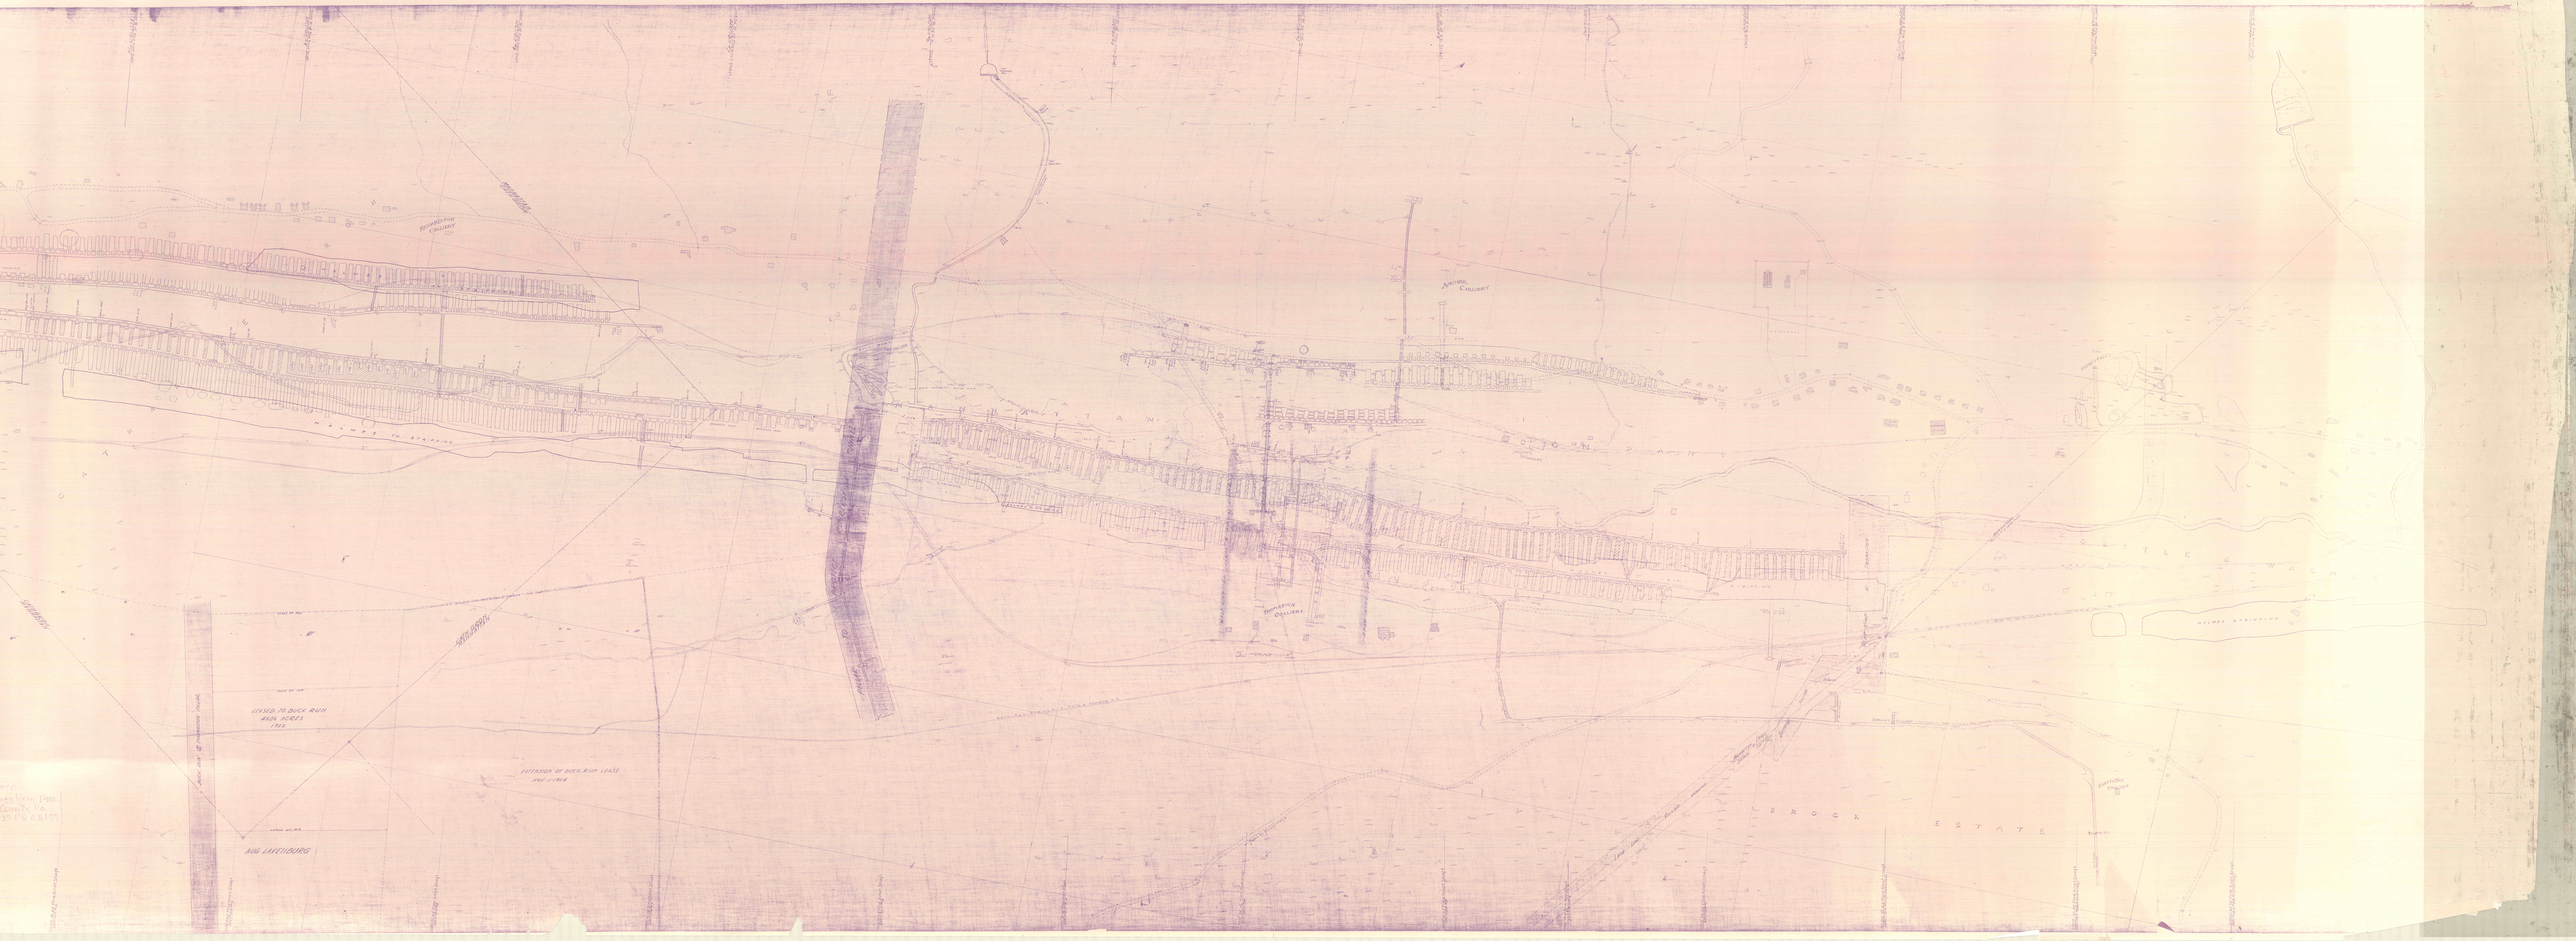
HOMESTOCK COLLIERY
ARCADIA COLLIERY
HOMESTOCK COLLIERY
HOLMES STRIPPING
LEASED TO BUCK RUN
EXTENSION OF BUCK RUN LEASE
BROCK ESTATE