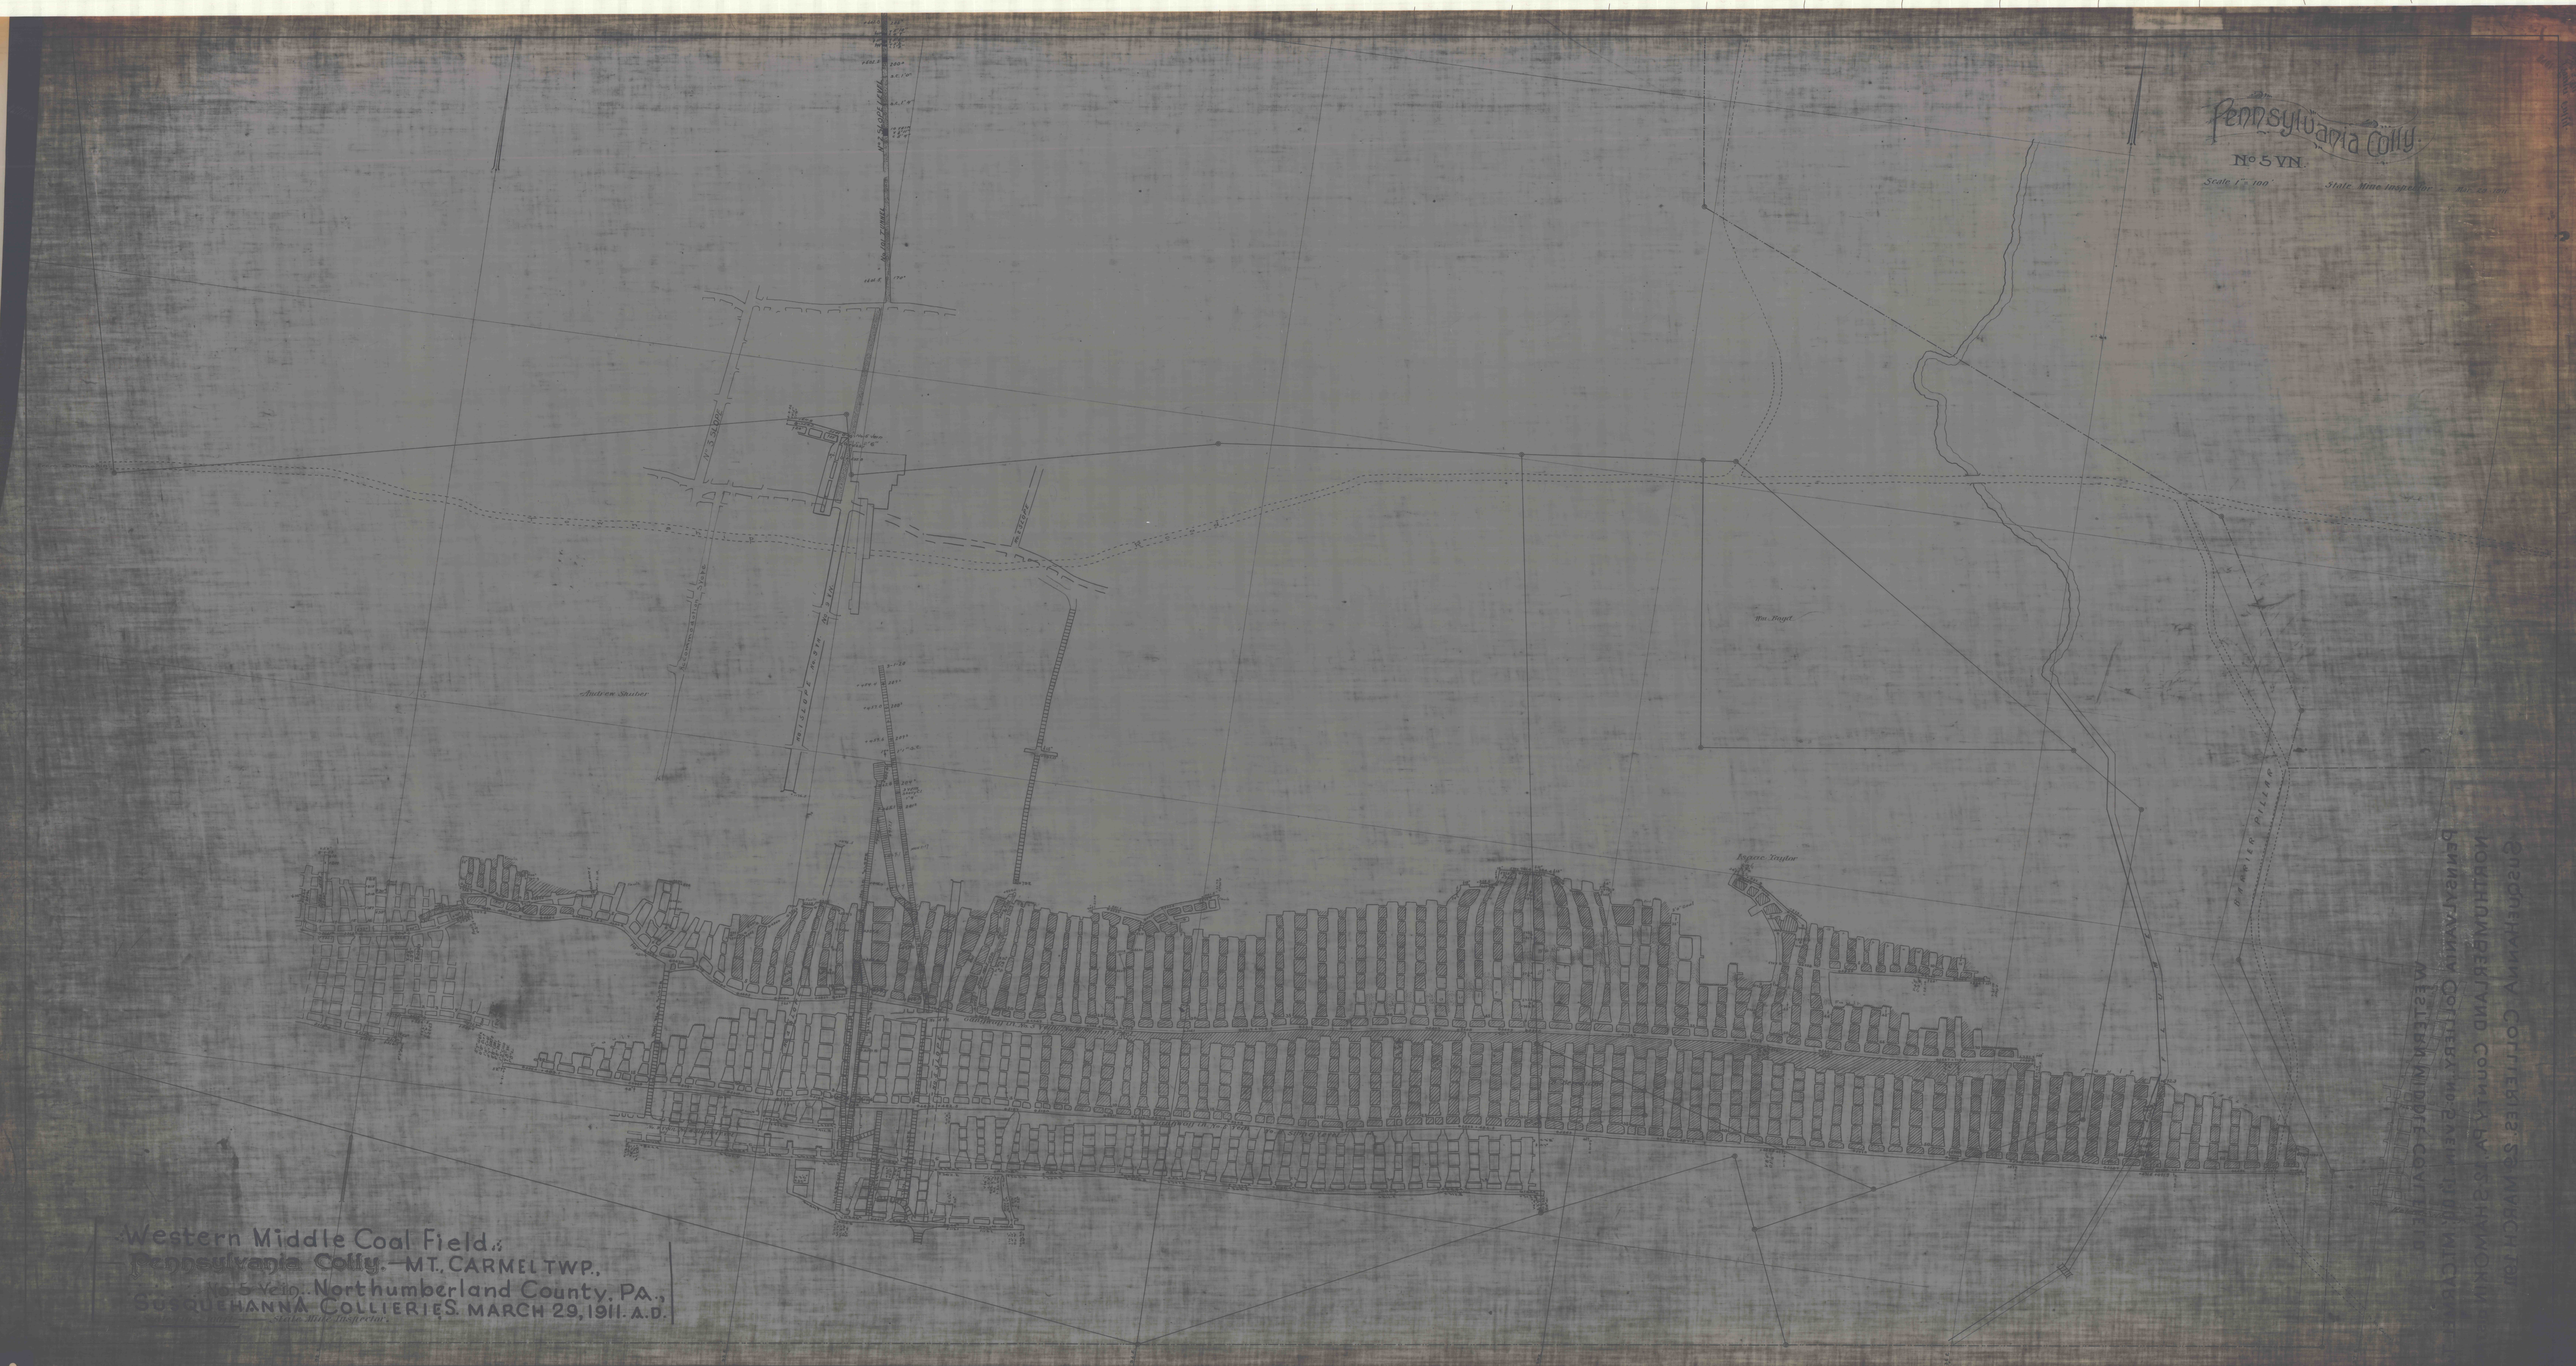
Pennsylvania Colly.
No. 5 VN.
Scale 1" = 100'
State Mine Inspector
Andrew Shuter
Wm. Trapt.
Isaac Taylor
Western Middle Coal Field.
Pennsylvania Colly.—MT. CARMEL TWP.,
No. 5 Vein. Northumberland County, PA.,
Susquehanna Collieries. MARCH 29, 1911. A.D.
State Mine Inspector.
PENNSYLVANIA COLLY.
WESTERN MIDDLE COAL FIELD
PENNSYLVANIA COLLIERY No. 2
MT. CARMEL TWP.
NORTHUMBERLAND CO., PA.
SUSQUEHANNA COLLIERIES CO.