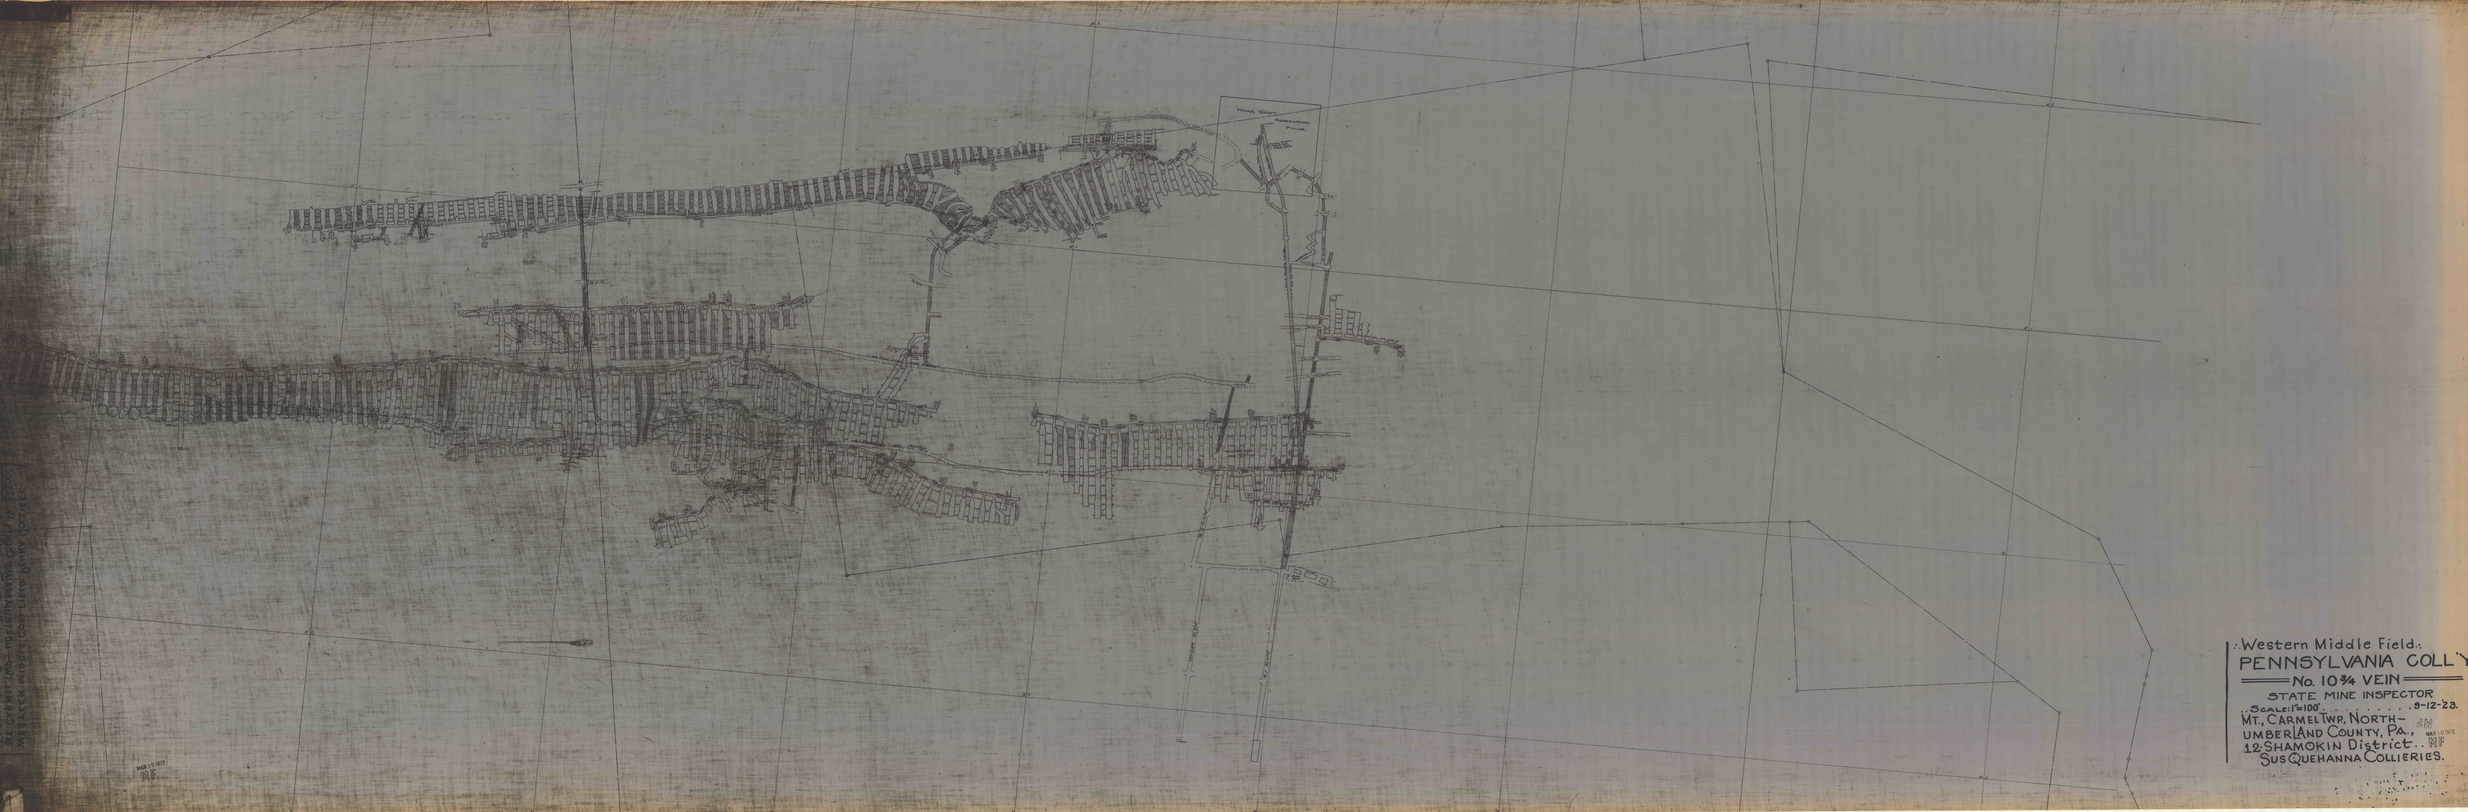

Western Middle Field.
PENNSYLVANIA COLL'Y.
No. 10¾ VEIN
STATE MINE INSPECTOR
SCALE: 1"=100' . . . . . 9-12-23.
MT. CARMEL TWP, NORTHUMBERLAND COUNTY, PA.,
12 SHAMOKIN District.
SUSQUEHANNA COLLIERIES.

MAR 13 1972