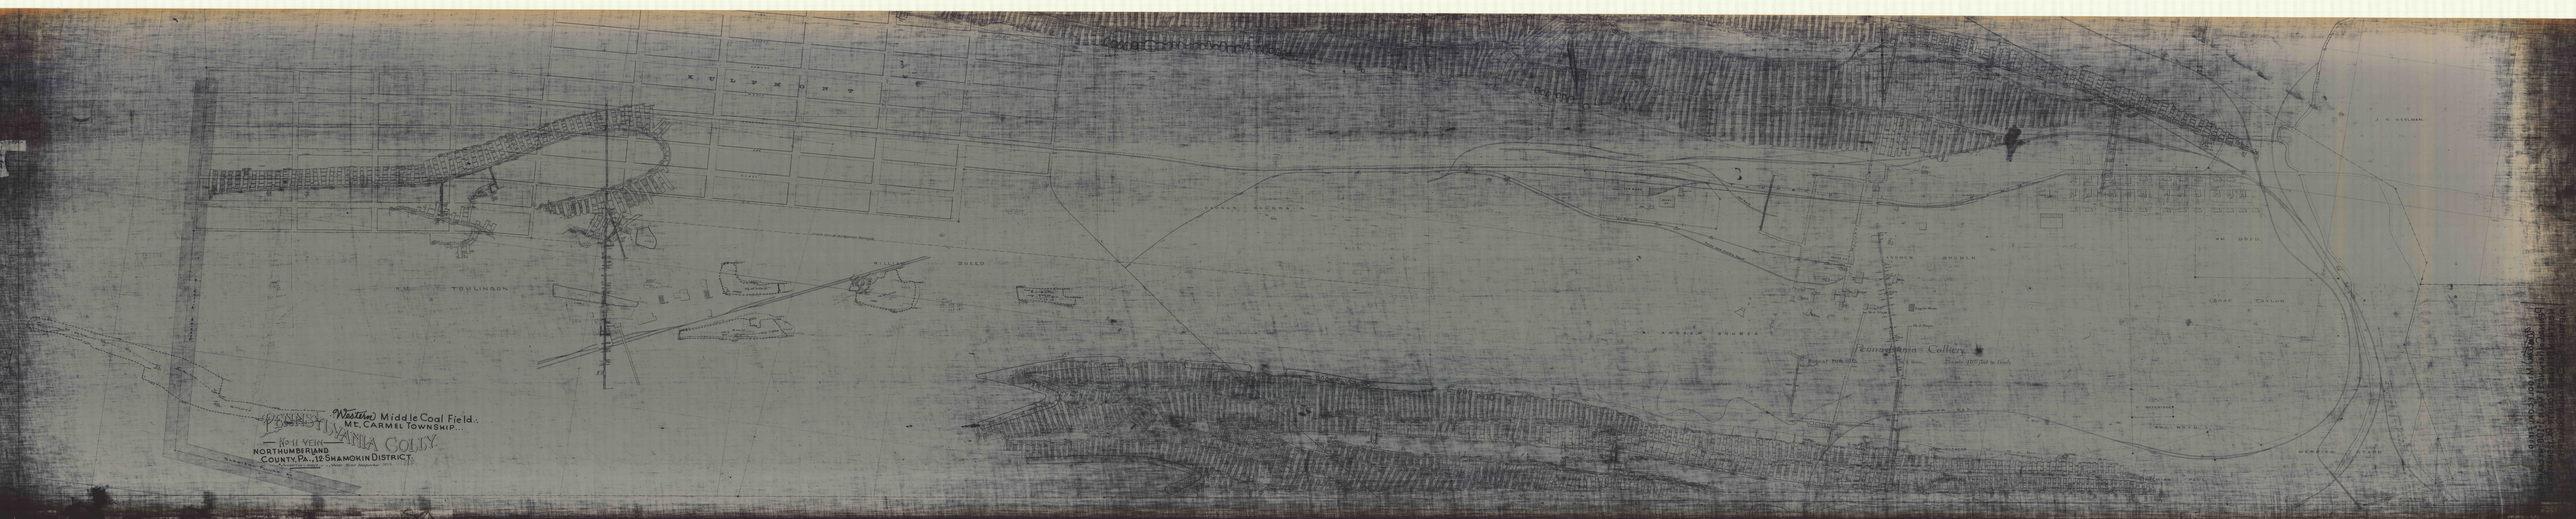
Western Middle Coal Field.
Mt. CARMEL TOWNSHIP.
PENNSYLVANIA COLLY.
NO 11 VEIN
NORTHUMBERLAND
COUNTY, PA. 12 SHAMOKIN DISTRICT.
Pennsylvania Colliery