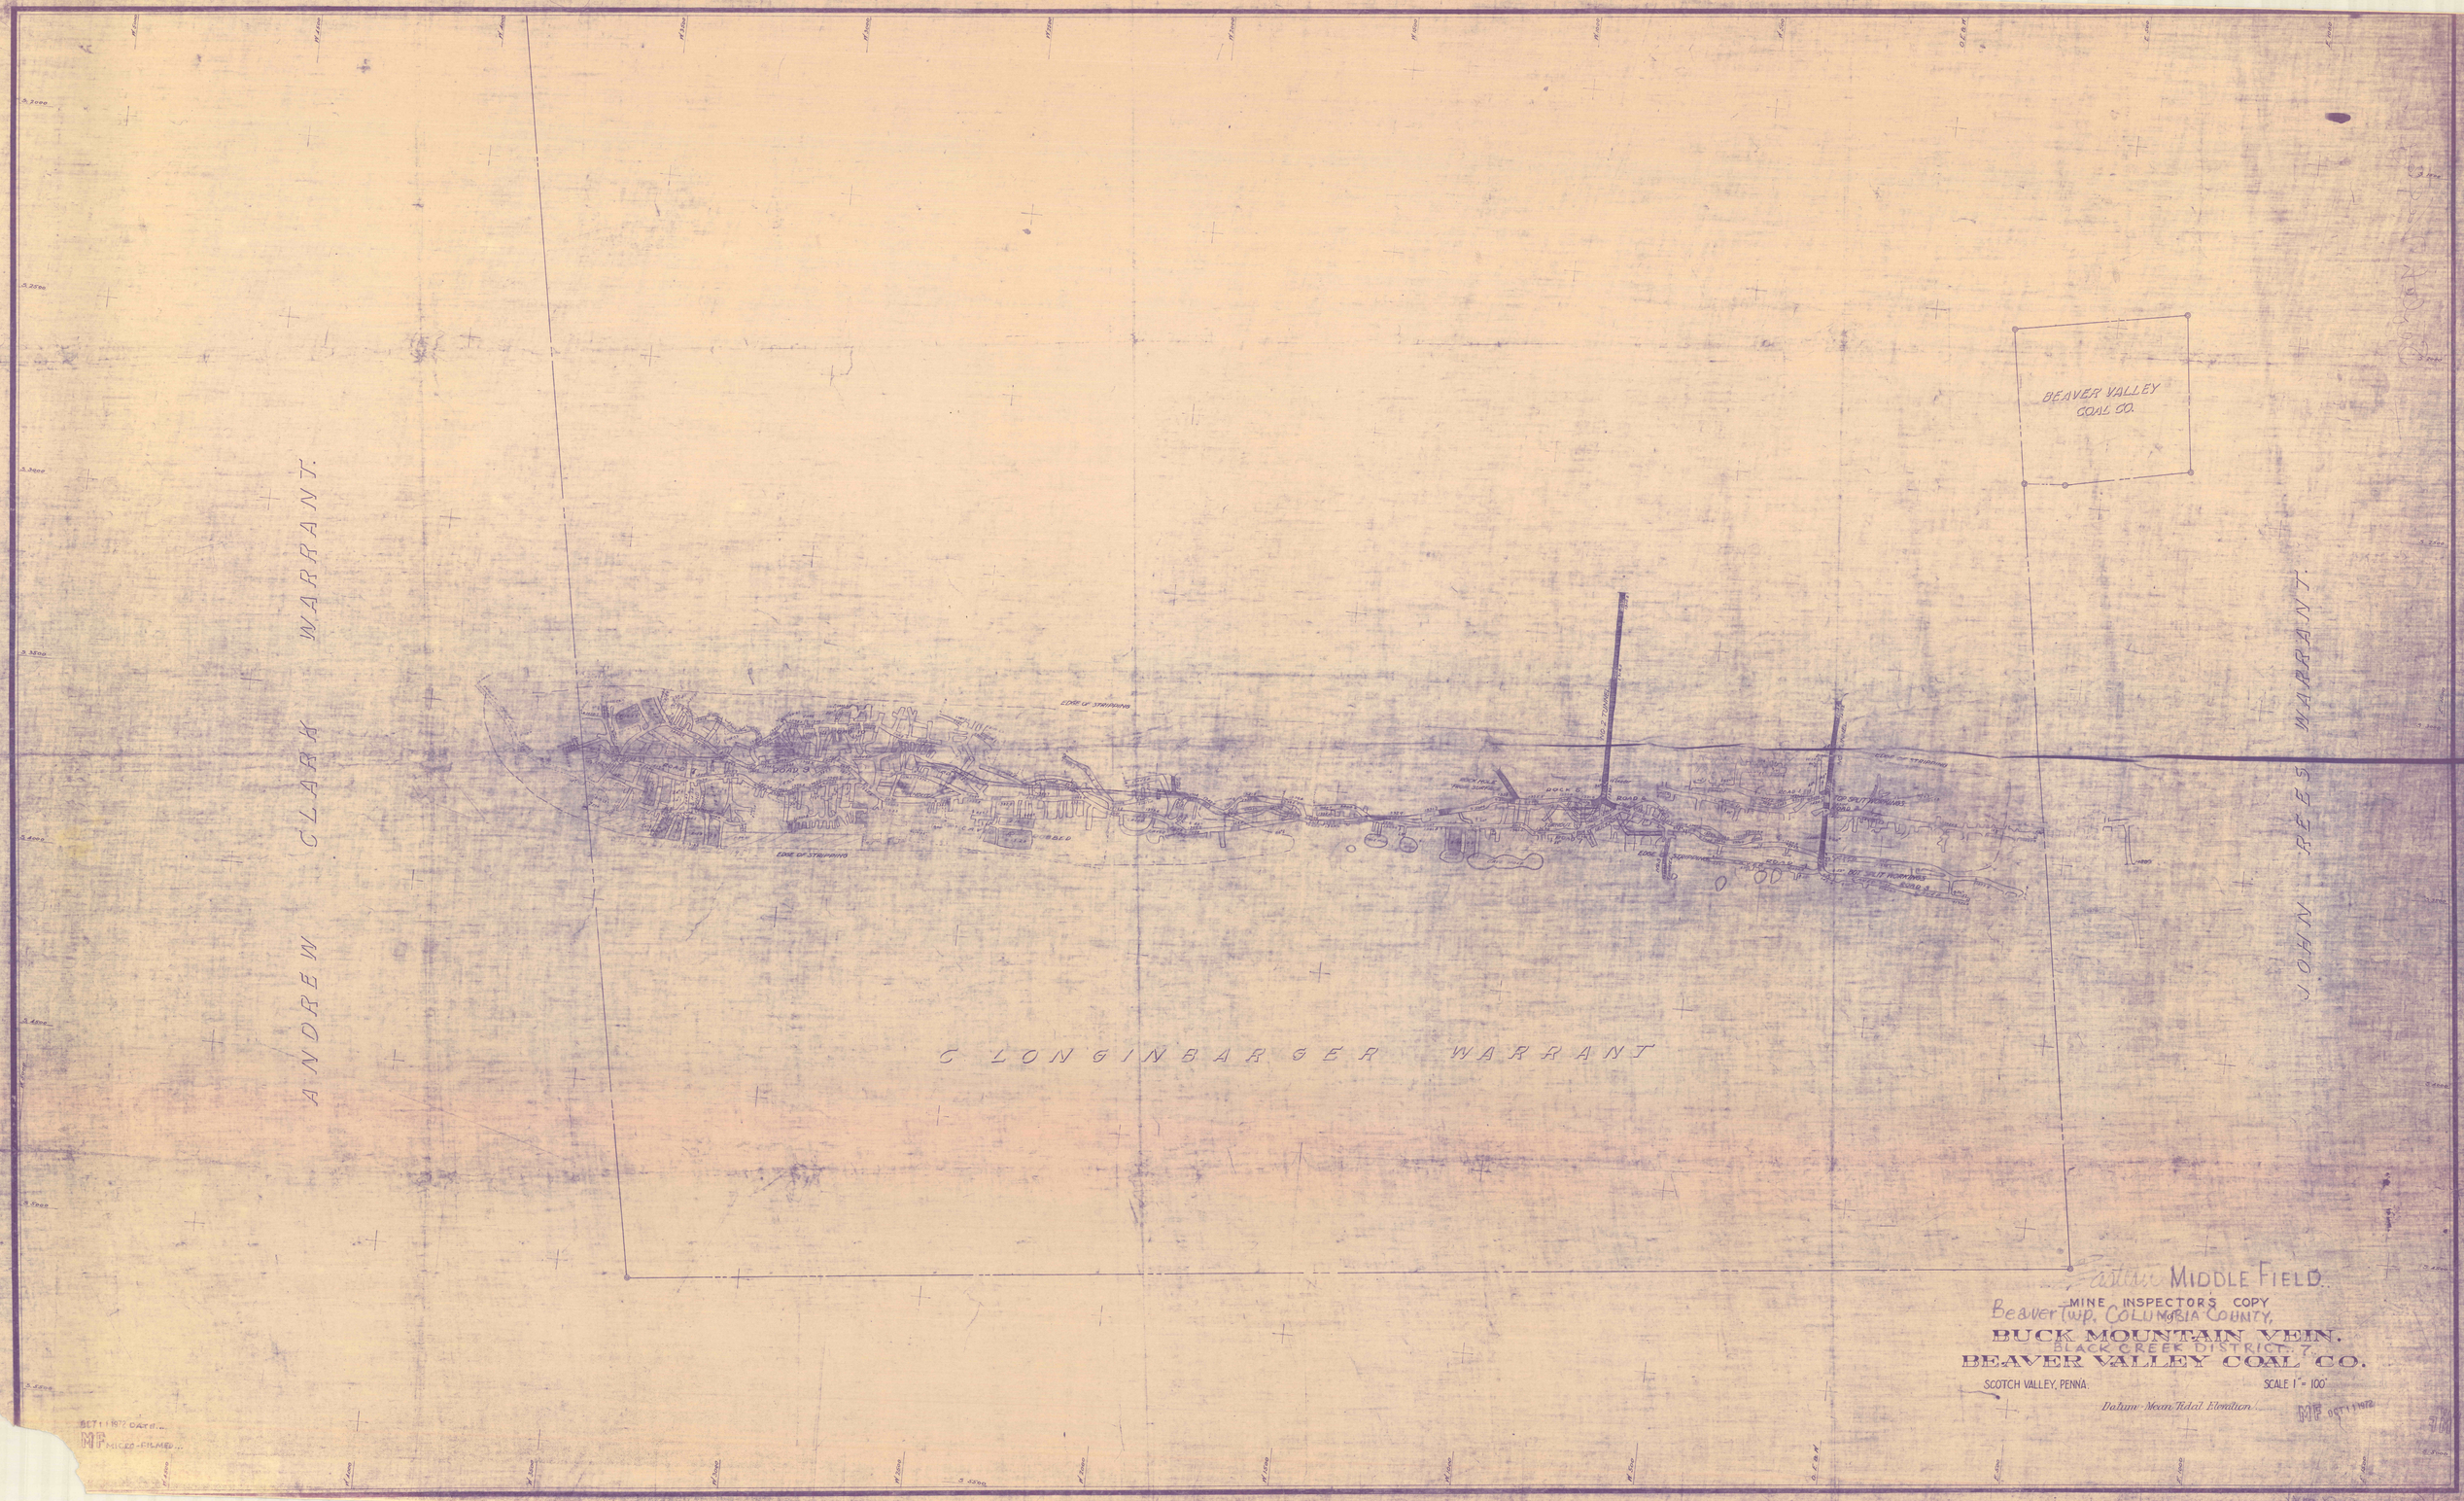

WARRANT.
ANDREW CLARK
JOHN REES WARRANT.
BEAVER VALLEY COAL CO.
C LONGINBARGER WARRANT
EDGE OF STRIPPING
ROAD
DOCK
TOP SPLIT WORKINGS
BOT SPLIT WORKINGS
MIDDLE FIELD.
MINE INSPECTORS COPY
Beaver Twp. COLUMBIA COUNTY,
BUCK MOUNTAIN VEIN.
BLACK CREEK DISTRICT. 7.
BEAVER VALLEY COAL CO.
SCOTCH VALLEY, PENNA.
SCALE 1" = 100'
Datum Mean Tidal Elevation.